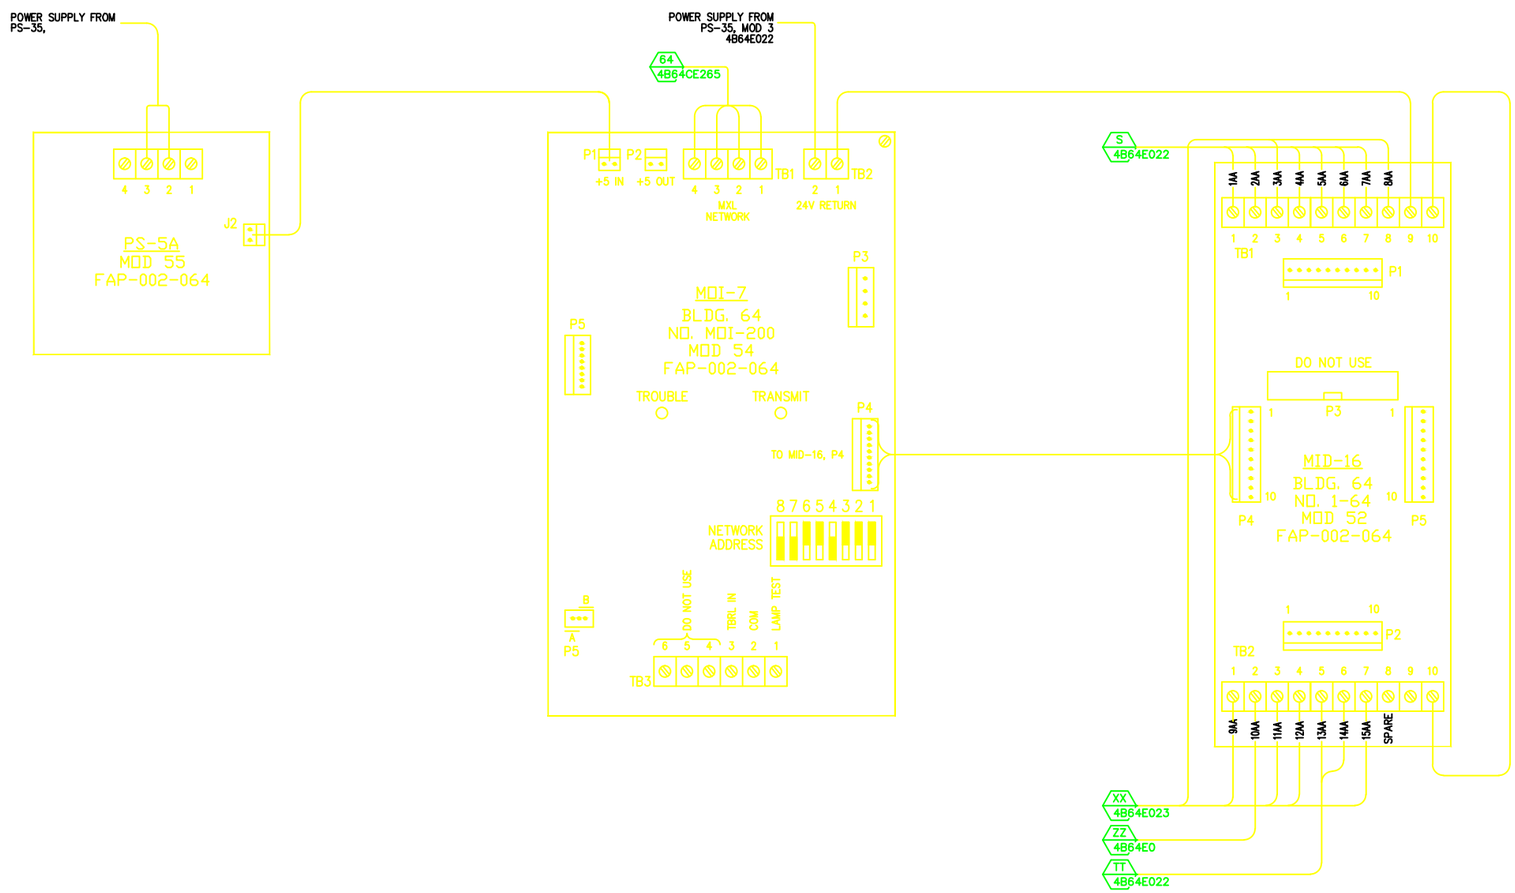

OLD ADDRESS	DESCRIPTION	MID-16 TERMINATION	& NO.	MXL 03-64C ADDRESS
2G65	WATERFLOW SPRINKLERS-BLDG. 64 & RIGGERS	TB1, No. 1	MID 16, No. 1-64	3-200-1
2G66	WATERFLOW SPRINKLERS-BLDG. 56	TB1, No. 2	MID 16, No. 1-64	3-200-2
2G67	WFS B64 ELEV. MECH ROOM	TB1, No. 3	MID 16, No. 1-64	3-200-3
2G68	FCB, FIRST FLOOR (4)	TB1, No. 4	MID 16, No. 1-64	3-200-4
2G69	FCB, SECOND FLOOR (3)	TB1, No. 5	MID 16, No. 1-64	3-200-5
2G70	SD, FIRST FLOOR	TB1, No. 6	MID 16, No. 1-64	3-200-6
2G71	SD, SECOND FLOOR	TB1, No. 7	MID 16, No. 1-64	3-200-7
2G72	DUCT SD'S AND AHU-3,29,31-64	TB1, No. 8	MID 16, No. 1-64	3-200-8
2G73	DUCT SD'S AND AHU-28-64	TB2, No. 1	MID 16, No. 1-64	3-200-9
2G74	ISO VALVE/WFS	TB2, No. 2	MID 16, No. 1-64	3-200-10
2G75	DUCT SMOKES AHU-2-56, AHU-1-56	TB2, No. 3	MID 16, No. 1-64	3-200-11
2G76	ROOM SD'S/FCB'S	TB2, No. 4	MID 16, No. 1-64	3-200-12
2G77	SUPERVISION, RISER VALVE AND ISOLATION VALVE (2)	TB2, No. 5	MID 16, No. 1-64	3-200-13
2G78	SUPERVISION, RISER VALVE AND ISOLATION VALVE	TB2, No. 6	MID 16, No. 1-64	3-200-14
2G79	SYSTEM 3 COMMON PANEL TROUBLE	TB2, No. 7	MID 16, No. 1-64	3-200-15
2G80	MX-203 SUPERVISION	N/A	N/A	N/A

AS BUILT

C
5/29/13

REVISION NUMBER	DRAWN BY	CHECKED BY	APPR'D BY	DATE	REMARKS
C	DSV	LDD	MCD	5/29/13	AS BUILT PER FIELD VERIFICATION
B	AD	LDD	MCD	03/13/06	REVISED FOR MXL COPPER LOOP
A	AD	MCG	MCG	10/28/05	AS BUILT RECORD DRAWING

PROFESSIONAL SEAL (IF REVISION, APPLIES ONLY TO REVISED WORK)

ISSUE (PROGRESS, ESTIMATE, BID, CONSTRUCTION, CONFORMED, REVISION, RECORD)

64
REPLACEMENT FIRE ALARM SYSTEM
MOI/MID MODULE ARRANGEMENT

UNIVERSITY OF CALIFORNIA
LAWRENCE BERKELEY NATIONAL LABORATORY
FACILITIES DIVISION

DRAWN BY	MRC	DATE 6/17/2004
CHECKED BY	AD	6/17/2004
APPROVED BY	MCG	3/17/2004
CAD FILE PATH		
SCALE	As Noted	
DRAWING NO.	4B64E124C	SHEET 1 OF 1
PROJECT NO.	FB4010	