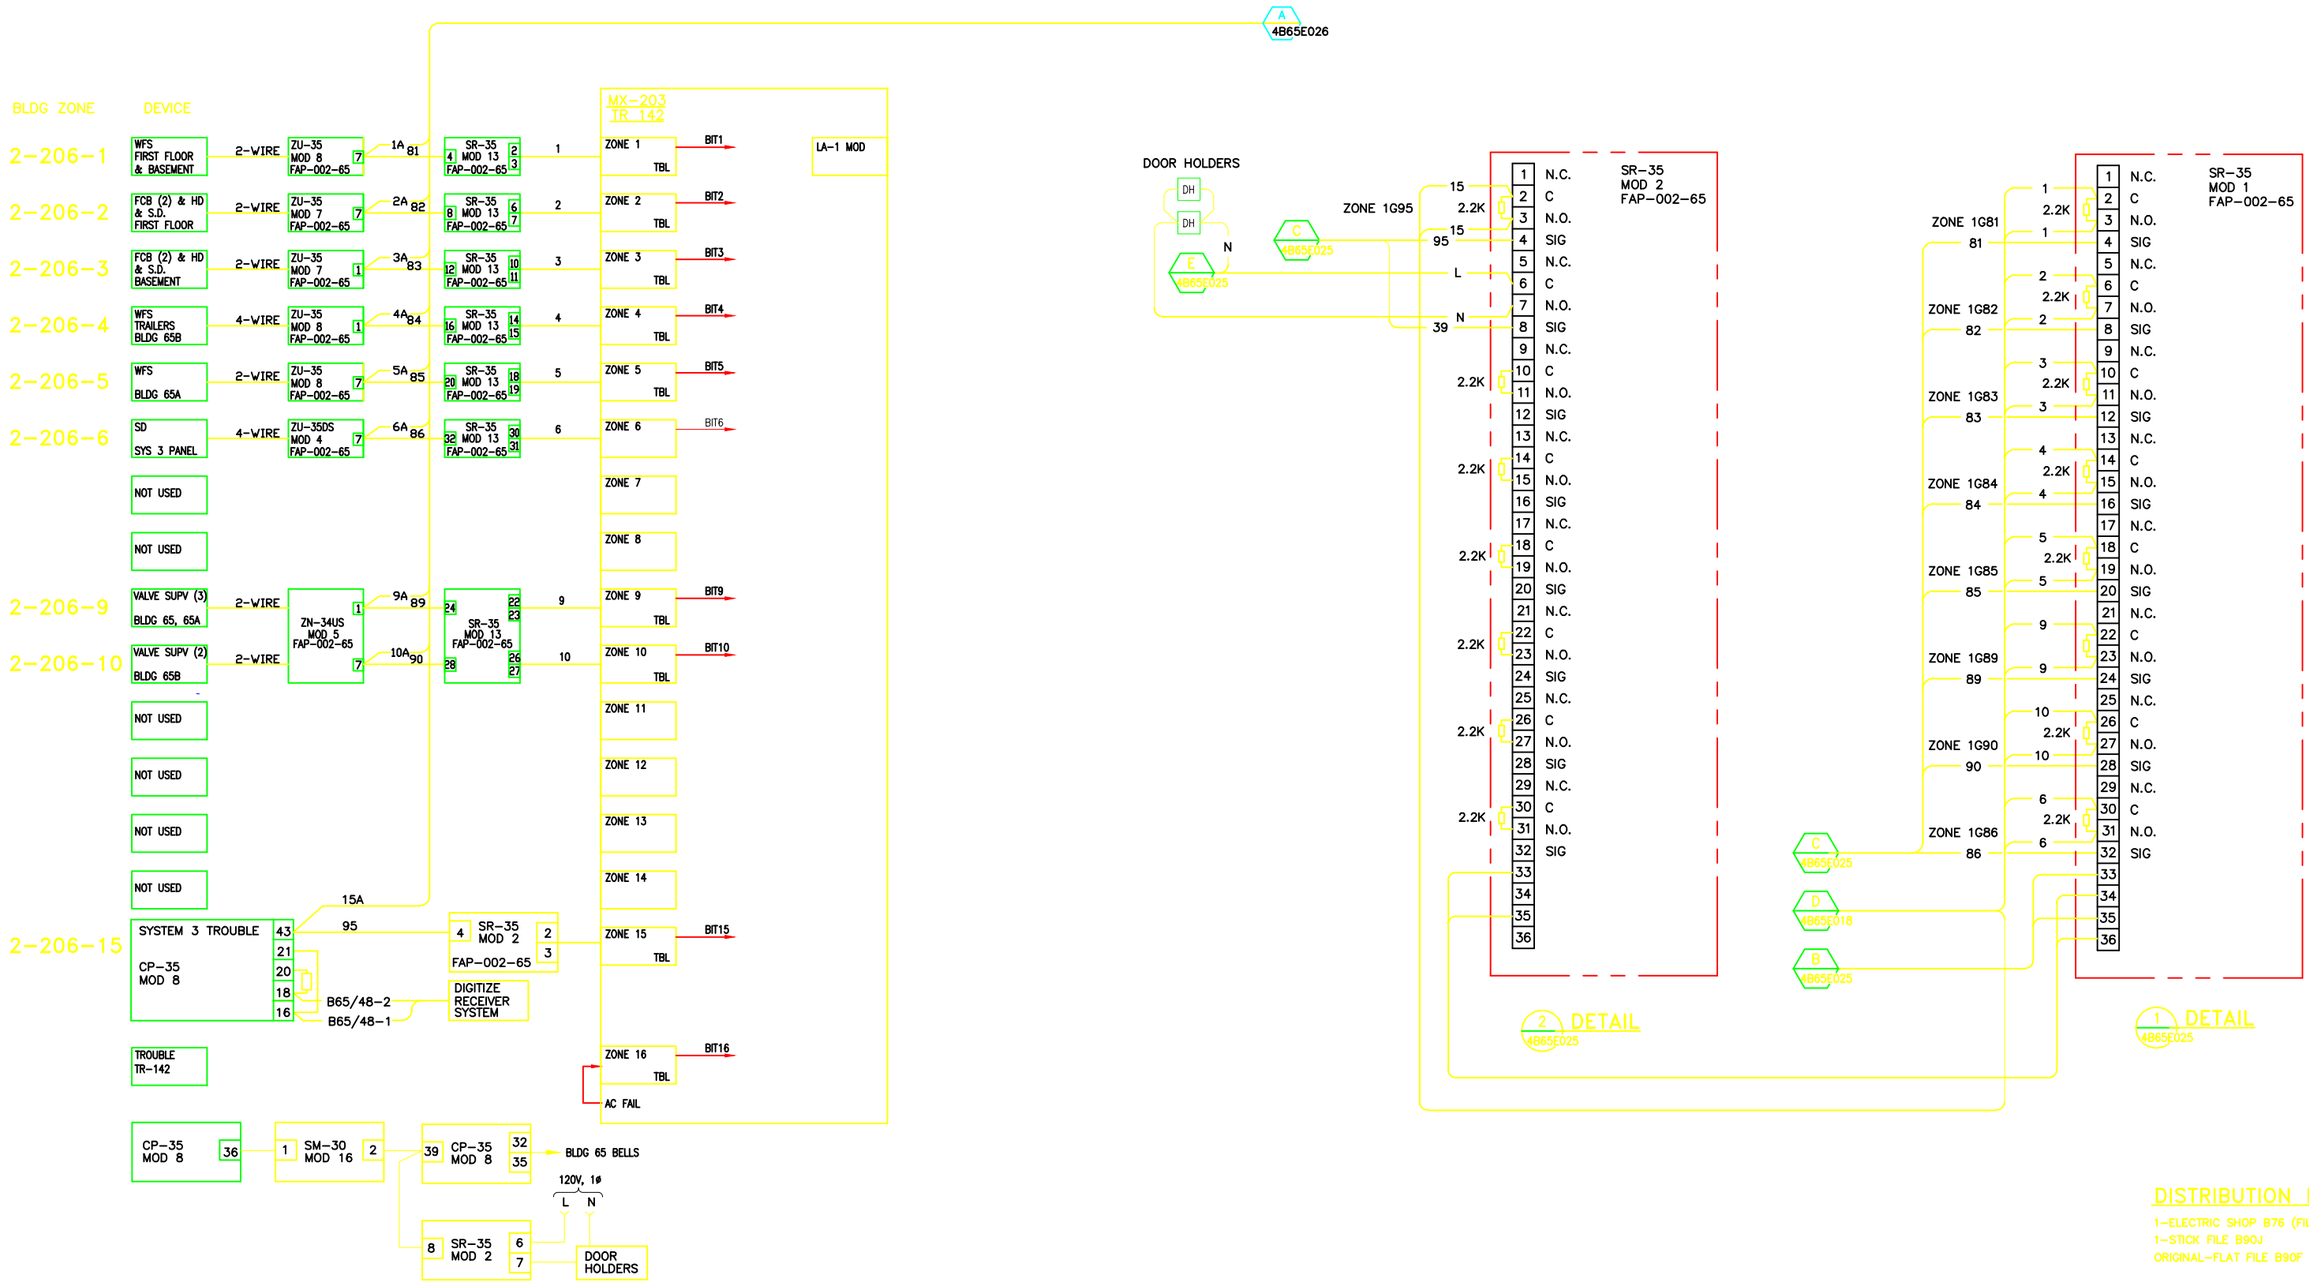

DISTRIBUTION LIST:

1-ELECTRIC SHOP B76 (FILE I)
1-STICK FILE B90J
ORIGINAL-FLAT FILE B90F

AS BUILT
G
5/30/13

REVISION NUMBER	DRAWN BY	CHECKED BY	APPR'D BY	DATE	REMARKS
G	DSV	LDD	MCD	5/30/13	AS BUILT PER FIELD VERIFICATION
F	MRC	AD	MCG	05/06/05	REVISED FOR MXL/DIGITIZE SYSTEMS
E	AD	MCG	MCG	01/26/02	AS BUILT RECORD DRAWING
D	LM		MG	5/6/97	AUTOCAD CONVERSION
C	LSR	BHS		11/15/88	SR-33 ADDED
B	RG	BHS		1/87	B65B ADDED
A	RG	BHS		11/85	ADDED ZONES 1G81 & 1G89

PROFESSIONAL SEAL (IF REVISION, APPLIES ONLY TO REVISED WORK)
ISSUE (PROGRESS, ESTIMATE, BID, CONSTRUCTION, CONFORMED, REVISION, RECORD)

65 FIRE ALARM SYSTEM
TRANSMITTER 142 LOGIC DIAGRAM
AND SR-35 RELAY

UNIVERSITY OF CALIFORNIA
LAWRENCE BERKELEY NATIONAL LABORATORY
FACILITIES DIVISION

DRAWN BY RG
DATE 12/9/1983
CHECKED BY
APPROVED BY
CAD FILE PATH
SCALE FULL
DRAWING NO. 4B65E008G
SHEET 1 OF 1
PROJECT NO. FB4010