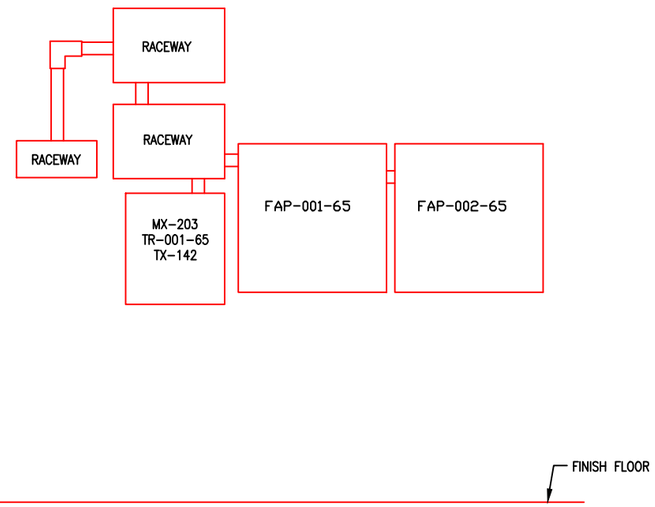

ELEVATION

SYSTEM 3 PANELS-ROOM 010
SCALE: 1"=1'-0"

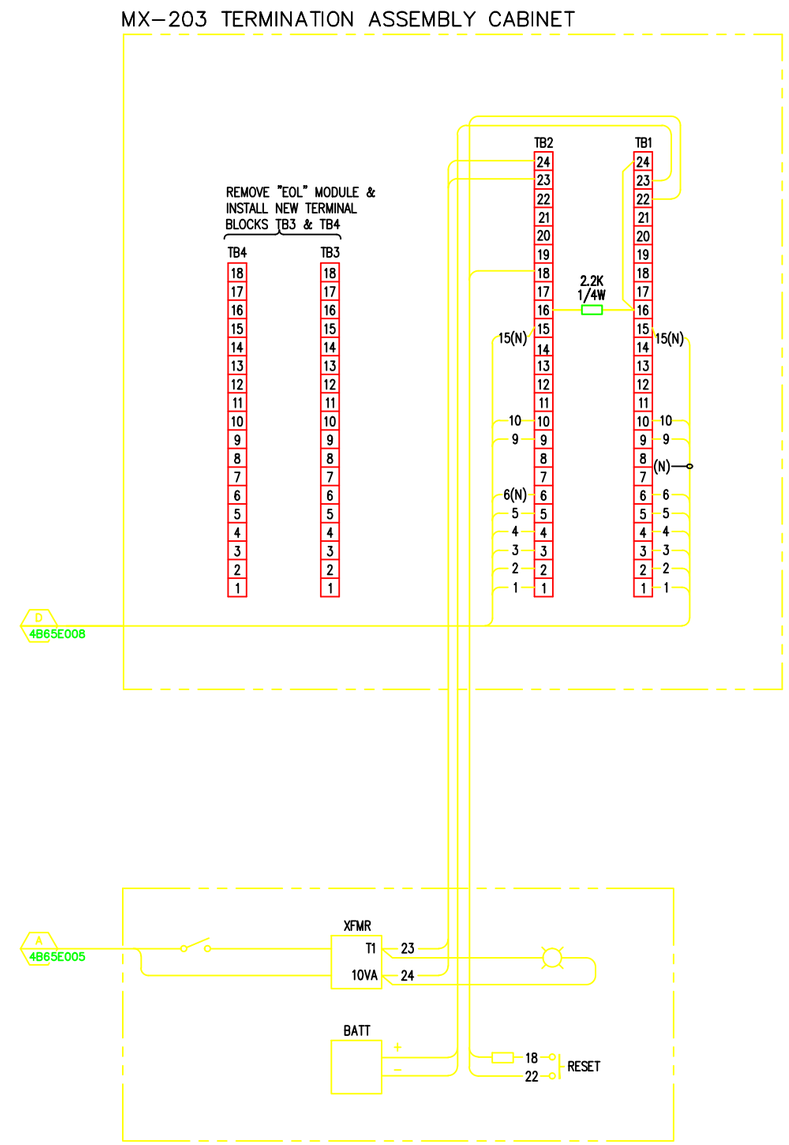

DISTRIBUTION LIST:

1-ELECTRIC SHOP B76 (FILE I)
1-STICK FILE B90J
ORIGINAL-FLAT FILE B90F

	AS BUILT						
	D 5/30/13	D	DSV	LDD	MCD	5/30/13	AS BUILT PER FIELD VERIFICATION
		C	MRC	AD	MCG	05/06/05	REVISED FOR MXL DIGITIZE SYSTEMS
		B	AD	MCG	MCG	01/26/02	AS BUILT RECORD DRAWING
		A	LM		MG	5/6/97	AUTOCAD CONVERSION
PROFESSIONAL SEAL (IF REVISION, APPLIES ONLY TO REVISED WORK)	ISSUE (PROGRESS, ESTIMATE, BID, CONSTRUCTION, CONFORMED, REVISION, RECORD)	REVISION NUMBER	DRAWN BY	CHECKED BY	APPR'D BY	DATE	REMARKS

65 FIRE ALARM SYSTEM
MX-203, TRANSMITTER 142
WIRING DIAGRAM

UNIVERSITY OF CALIFORNIA
LAWRENCE BERKELEY NATIONAL LABORATORY
FACILITIES DIVISION

DRAWN BY	RG
DATE	12/9/1983
CHECKED BY	
APPROVED BY	
CAD FILE PATH	
SCALE	FULL
DRAWING NO.	4B65E018D
SHEET	1 OF 1
PROJECT NO.	FB4010