NOTES:

1. CONNECT ALL N.O. CONTACT SWITCHES IN PARALLEL WITH "EOL" AT THE LAST SWITCH.

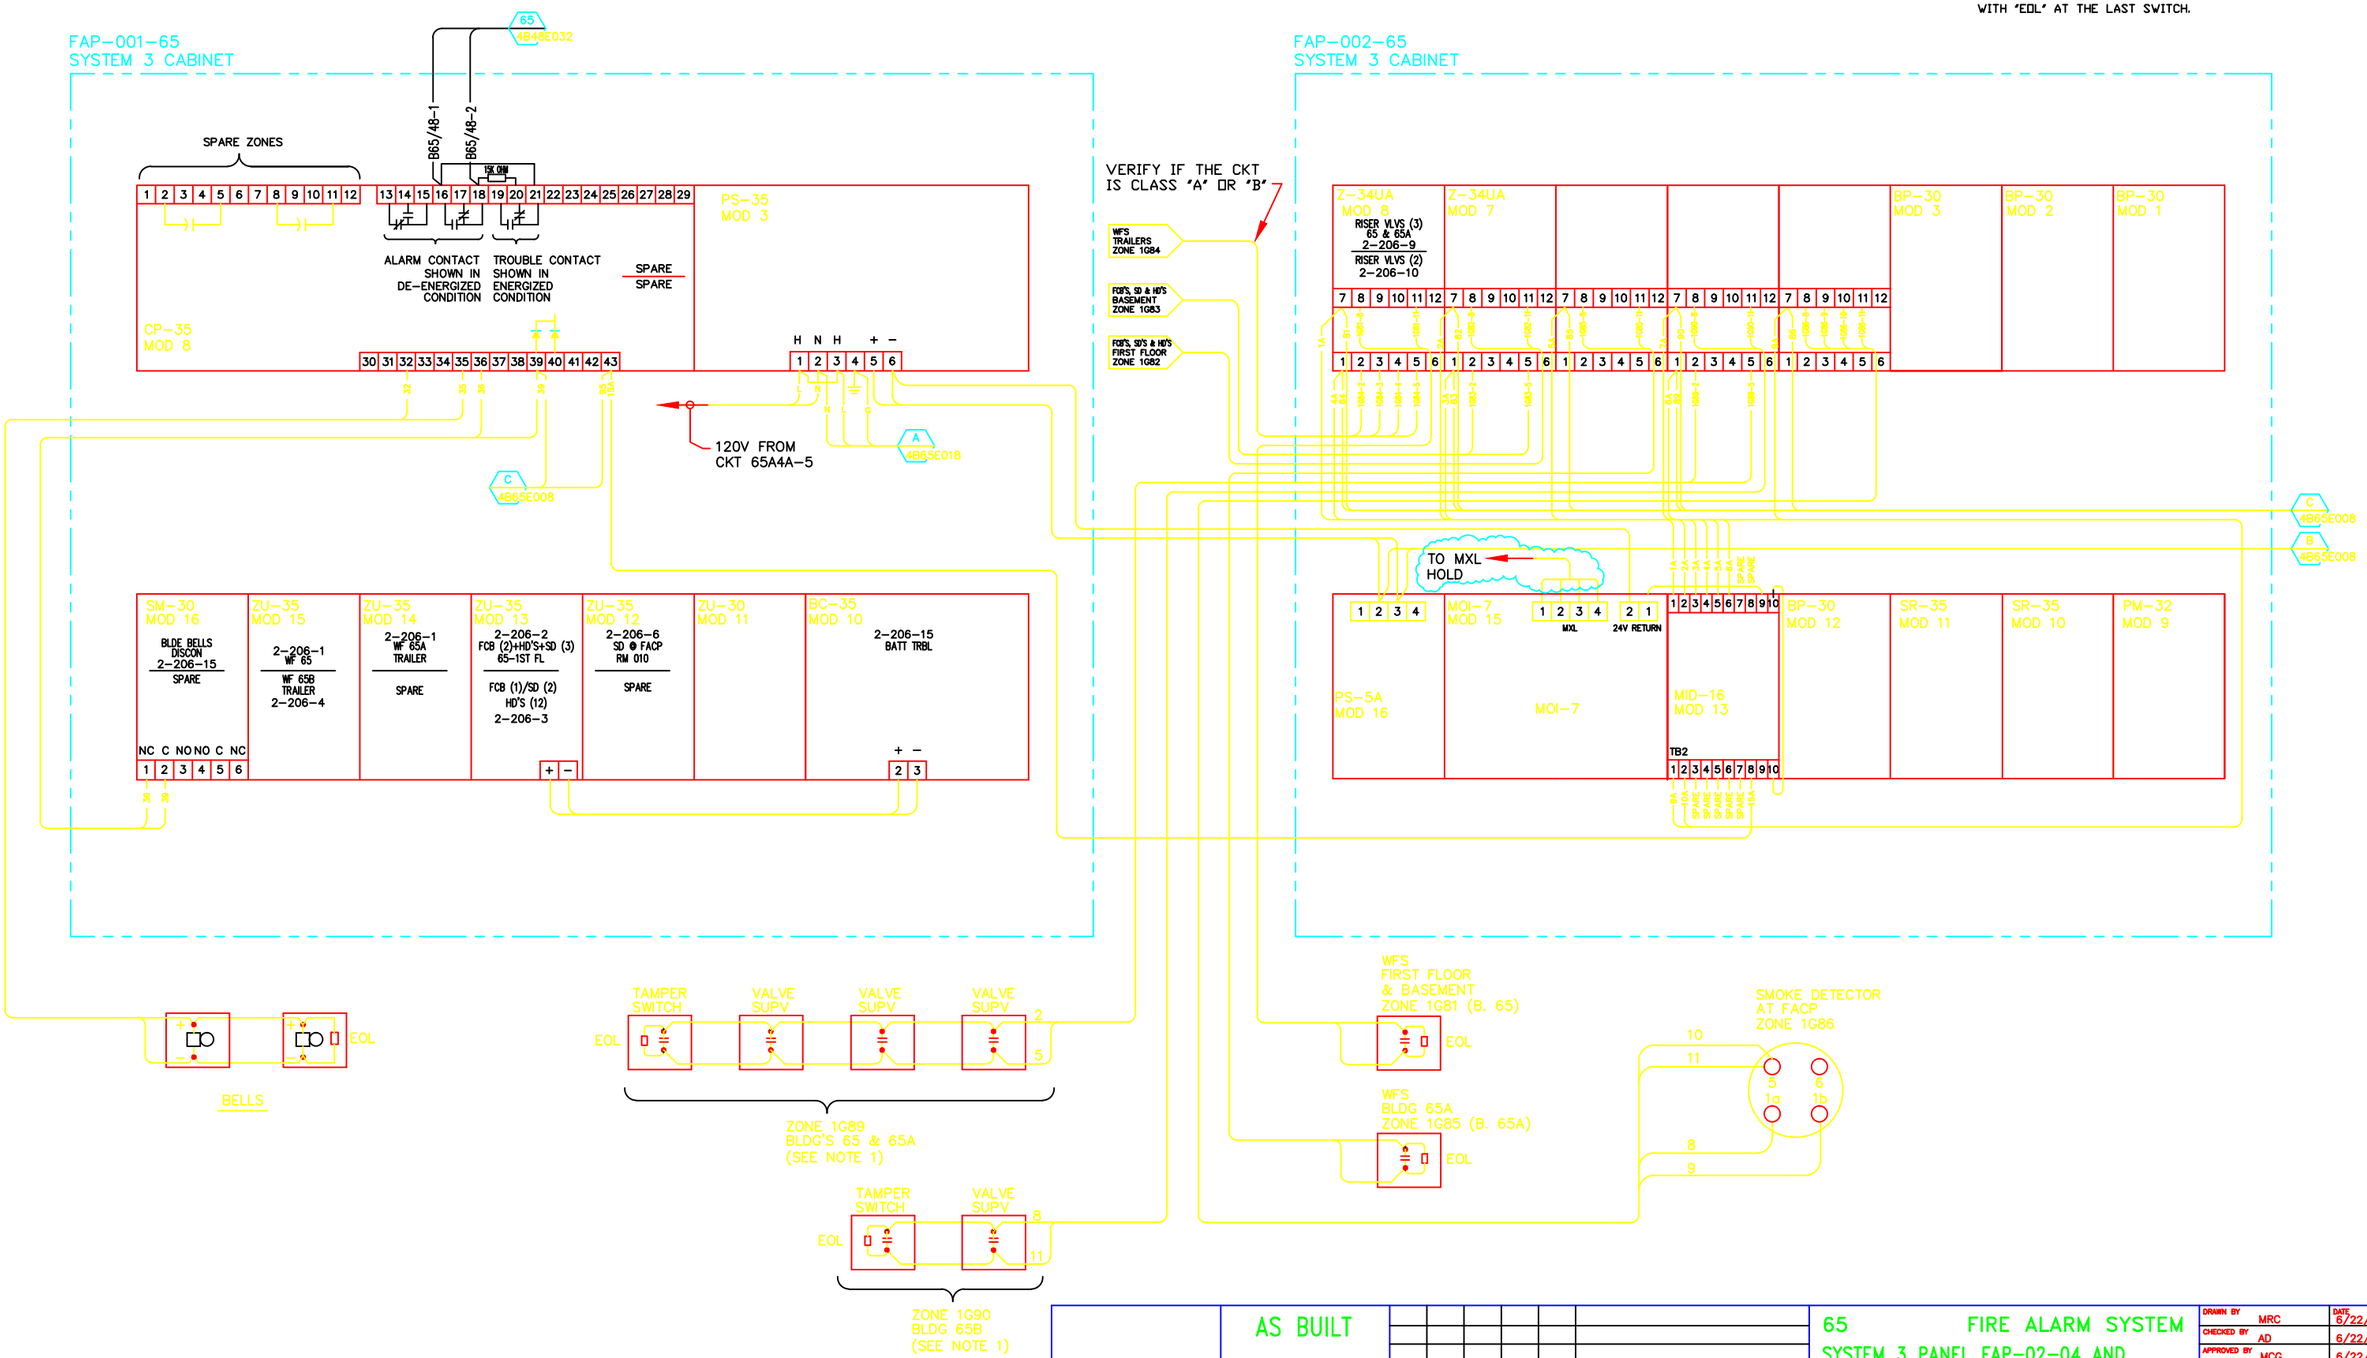

	AS BUILT A 5/29/13	A	DSV	LDD	MCD	5/30/13	AS BUILT PER FIELD VERIFICATION
PROFESSIONAL SEAL (IF REVISION, APPLIES ONLY TO REVISED WORK)	ISSUE (PROGRESS, ESTIMATE, BID, CONSTRUCTION, CONFORMED, REVISION, RECORD)	REVISION NUMBER	DRAWN BY	CHECKED BY	APPR'D BY	DATE	REMARKS

65 FIRE ALARM SYSTEM
SYSTEM 3 PANEL FAP-02-04 AND SR-35 RELAYS, WIRING DIAGRAMS

UNIVERSITY OF CALIFORNIA
LAWRENCE BERKELEY NATIONAL LABORATORY
FACILITIES DIVISION

DRAWN BY MRC	DATE 6/22/2004	
CHECKED BY AD	6/22/2004	
APPROVED BY MCG	6/22/2004	
CAD FILE PATH		
SCALE FULL		
DRAWING NO. 4B65E025A	SHEET 1 OF 1	
PROJECT NO. FB4010		