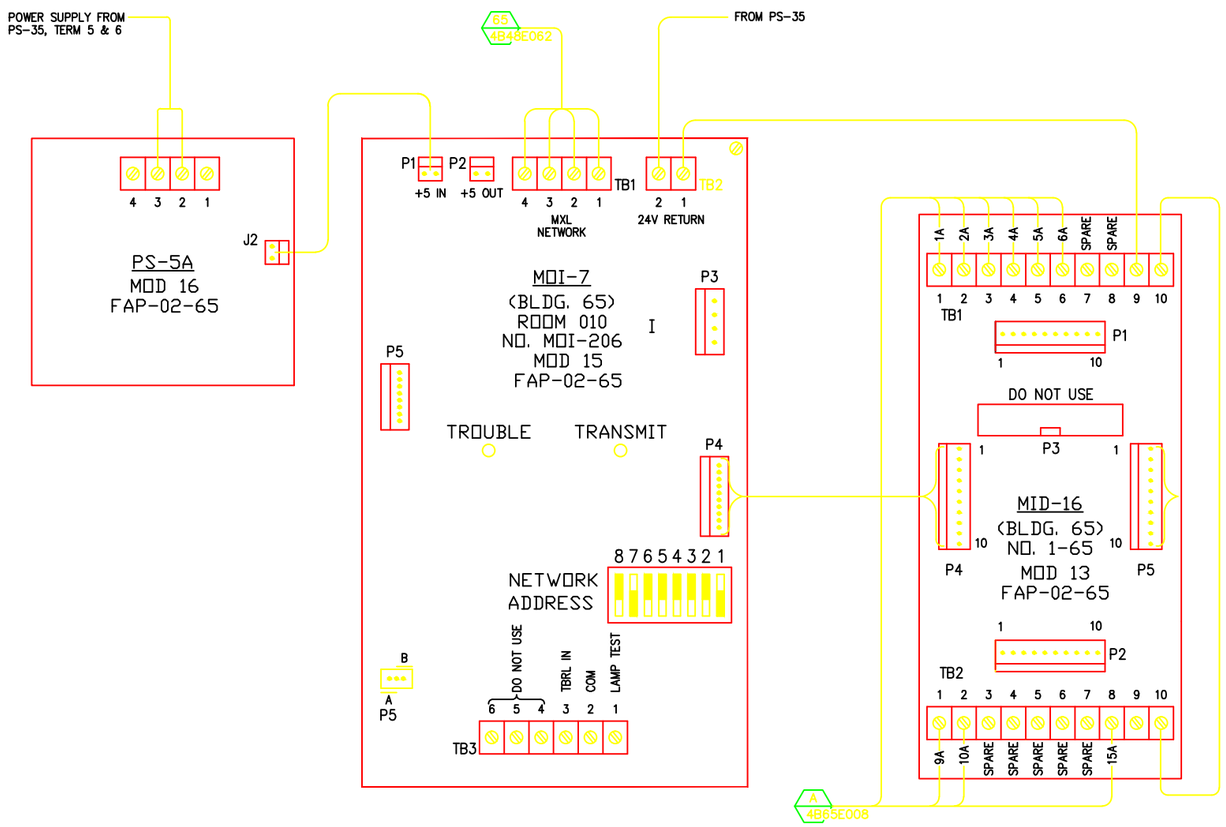

OLD ADDRESS	DESCRIPTION	MID-16 TERMINATION	MODULE TYPE & NO.	MXL NO. 02-50B ADDRESS
1G81	WATERFLOW SPRINKLERS-FIRST FLOOR & BASEMENT	TB1, No. 1	MID 16, No. 1-65	2-206-1
1G82	FIRE-FCB'S, SD & HD'S FIRST FLR	TB1, No. 2	MID 16, No. 1-65	2-206-2
1G83	FIRE-FCB, SD'S & HD'S BASEMENTS	TB1, No. 3	MID 16, No. 1-65	2-206-3
1G84	WATERFLOW SPRINKLERS TRAILERS 65B	TB1, No. 4	MID 16, No. 1-65	2-206-4
1G85	WATERFLOW SPRINKLERS TRAILERS 65A	TB1, No. 5	MID 16, No. 1-65	2-206-5
1G86	SMOKE DETECTOR SYSTEM 3 PANEL	TB1, No. 6	MID 16, No. 1-65	2-206-6
1G87	NOT USED	N/A	N/A	N/A
1G88	NOT USED	N/A	N/A	N/A
1G89	SUPERVISION RISER VALVE FOR 65 & 65A	TB2, No. 1	MID 16, No. 1-65	2-206-9
1G90	SUPERVISION RISER VALVE TRAILERS 65B	TB2, No. 2	MID 16, No. 1-65	2-206-10
1G91	NOT USED	N/A	N/A	N/A
1G92	NOT USED	N/A	N/A	N/A
1G93	NOT USED	N/A	N/A	N/A
1G94	NOT USED	N/A	N/A	N/A
1G95	SYSTEM 3 TROUBLE	TB2, No. 8	MID 16, No. 1-65	2-206-15
1G96	MX-203 TROUBLE	N/A	N/A	N/A

AS BUILT

C
5/30/13

PROFESSIONAL SEAL (IF REVISION, APPLIES ONLY TO REVISED WORK)

ISSUE (PROGRESS, ESTIMATE, BID, CONSTRUCTION, CONFORMED, REVISION, RECORD)

REVISION NUMBER	DRAWN BY	CHECKED BY	APPR'D BY	DATE	REMARKS
C	DSV	LDD	MCD	5/30/13	AS BUILT PER FIELD VERIFICATION
B	AD	LDD	MCD	03/06/06	REVISED FOR MXL COPPER LOOP
A	MRC	MCG	MCG	05/06/04	REVISED FOR MXL/DIGITIZE SYSTEMS

65
FIRE ALARM SYSTEM
MOI/MID MODULE ARRANGEMENT

UNIVERSITY OF CALIFORNIA
LAWRENCE BERKELEY NATIONAL LABORATORY
FACILITIES DIVISION

DRAWN BY	MRC	DATE 6/22/2004
CHECKED BY	AD	6/22/2004
APPROVED BY	MCG	6/22/2004
CAD FILE PATH		
SCALE	Full	
DRAWING NO.	4B65E026C	SHEET
PROJECT NO.	FB4010	1 OF 1