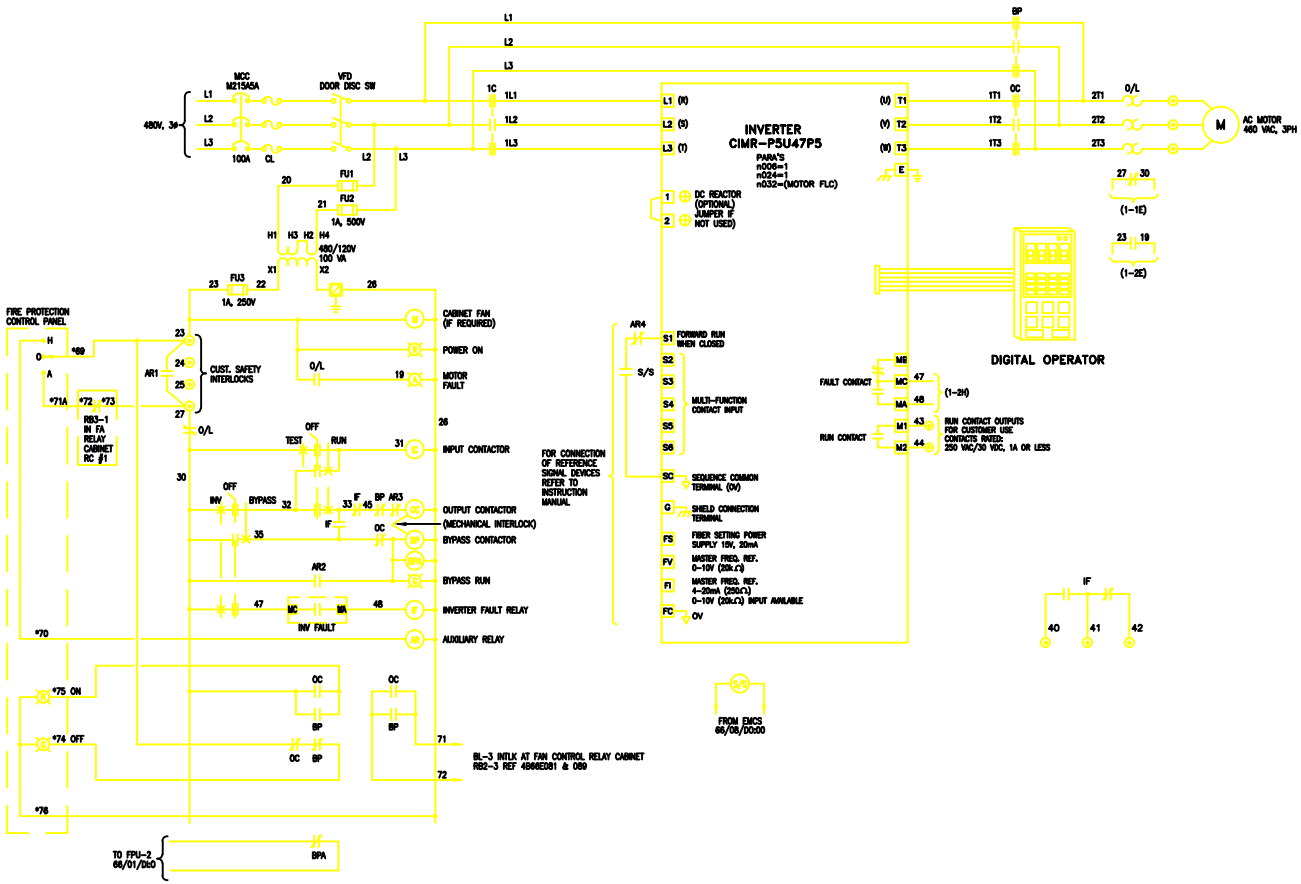

NOTES:

1. ADD AR W/2 NO & 1 NC CONTACT SETS
2. IF SUFFICIENT AUX. CONTACTS ON OC & BP ARE NOT PRESENT, ADD CONTACTS OR RELAY(S) AS NEEDED
3. WIRE H-O-A SWITCH AND LITES AS SHOWN, REF. DWG. 4B66E091.
4. EXTEND WIRE 77-84 IN (N) 3/4" EMT FROM MCC M215A5A TO VFD.

AHU-2-66 CONTROL DIAGRAM

REVISION NO.	DRAWN BY	CHECKED BY	APPROVED BY	DATE	REMARKS
B	RDB	MCG	MCG	11/12/97	AS-BUILT
A	RDB	MCG	MCG	4/08/97	ADD SMOKE CONTROL, ISSUE FOR ESTIMATING

66 BLDG SMOKE CONTROL
AHU-2-66
CONTROL DIAGRAMS

UNIVERSITY OF CALIFORNIA LAWRENCE BERKELEY LABORATORY
FACILITIES DEPARTMENT

DRAWN BY	LM	DATE 03/20/97
CHECKED BY	RDB	06/03/97
APPROVED BY	MCG	06/03/97
CAD FILE PATH	00002995	
SCALE	As Noted	
DRAWING NO.	4B66E082B	SHEET E4
PROJECT NO.	120362	1 OF 1