FIRE ALARM CONTROL UNIT ARRANGEMENT

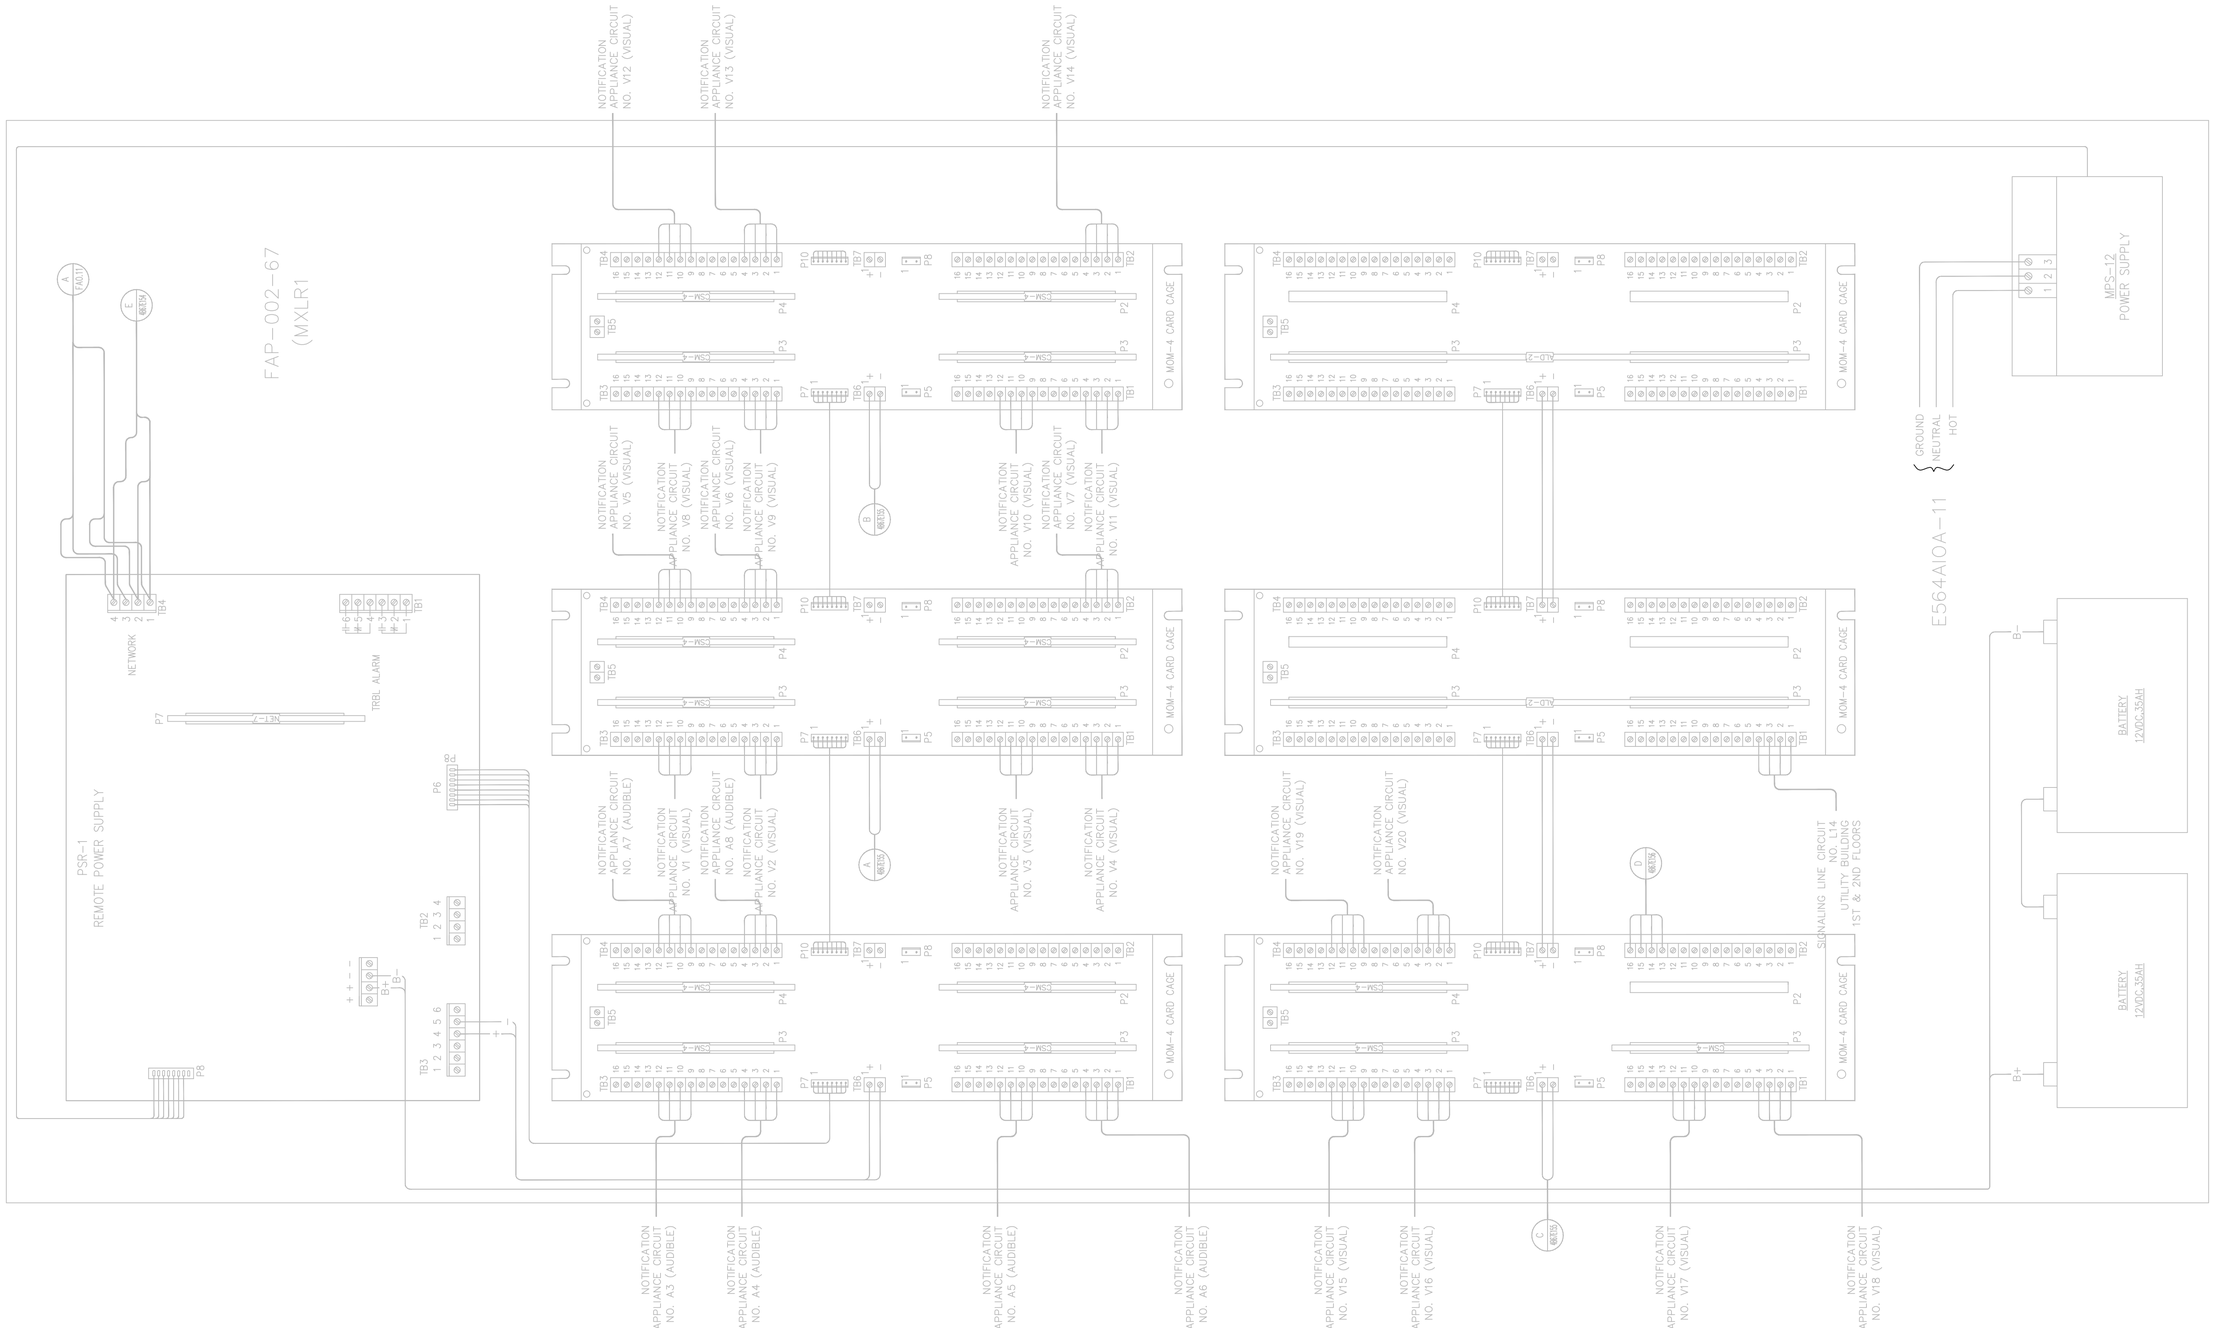

AS BUILT

06/17/13

PROFESSIONAL SEAL (IF REVISION, APPLIES ONLY TO REVISED WORK)

ISSUE (PROGRESS, ESTIMATE, BID, CONSTRUCTION, CONFORMED, REVISION, RECORD)

REVISION NUMBER	DRAWN BY	CHECKED BY	APPR'D BY	DATE	REMARKS
–	DSV	LDD	MCD	6/17/13	AS BUILT PER FIELD VERIFICATION

BLDG-67 FIRE ALARM
CONTROL UNITARRANGEMENT
FAP-002-67

UNIVERSITY OF CALIFORNIA
LAWRENCE BERKELEY NATIONAL LABORATORY
FACILITIES DIVISION

DRAWN BY	DSV	DATE 06/17/2013
CHECKED BY	LDD	7/8/2013
APPROVED BY	MCD	7/8/2013
SCALE		
DRAWING NO.	4B67E154	SHEET 7
PROJECT NO.	FN1438	7 OF 21