CONTROL UNIT + PWR SUPPLY ARRANGEMENT

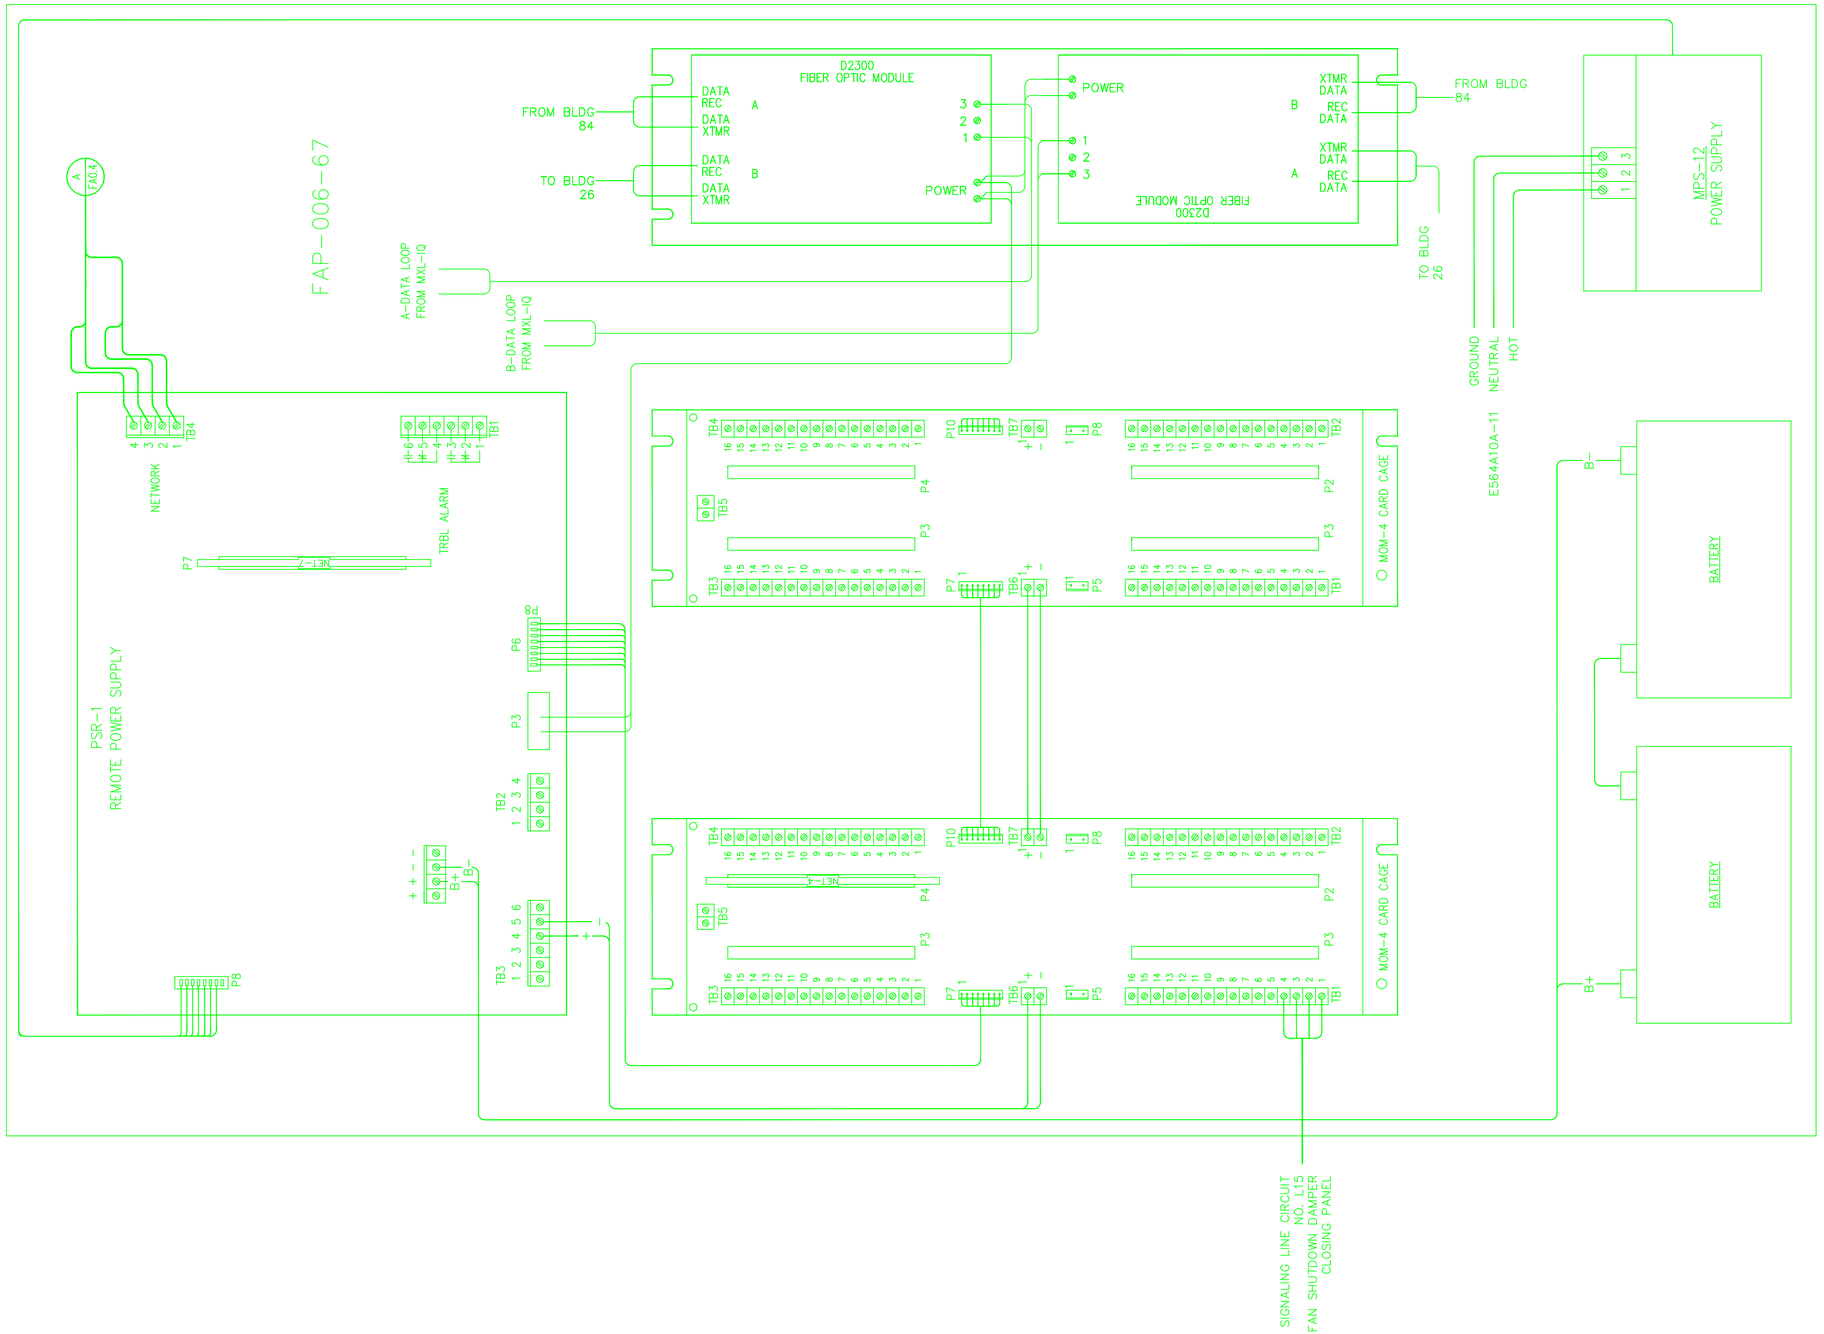

	AS BUILT 06/17/13	–	DSV	LDD	MCD	6/17/13	AS BUILT PER FIELD VERIFICATION
PROFESSIONAL SEAL (IF REVISION, APPLIES ONLY TO REVISED WORK)	ISSUE (PROGRESS, ESTIMATE, BID, CONSTRUCTION, CONFORMED, REVISION, RECORD)	REVISION NUMBER	DRAWN BY	CHECKED BY	APPR'D BY	DATE	REMARKS

BLDG-67 FIRE ALARM
CONTROL UNIT ARRANGEMENT
FAP-006-67

UNIVERSITY OF CALIFORNIA
LAWRENCE BERKELEY NATIONAL LABORATORY
FACILITIES DIVISION

DRAWN BY	DSV	DATE 06/17/2013
CHECKED BY	LDD	7/8/2013
APPROVED BY	MCD	7/8/2013
SCALE		
DRAWING NO. 4B67E157		SHEET 10
PROJECT NO. FN1438		10 OF 21