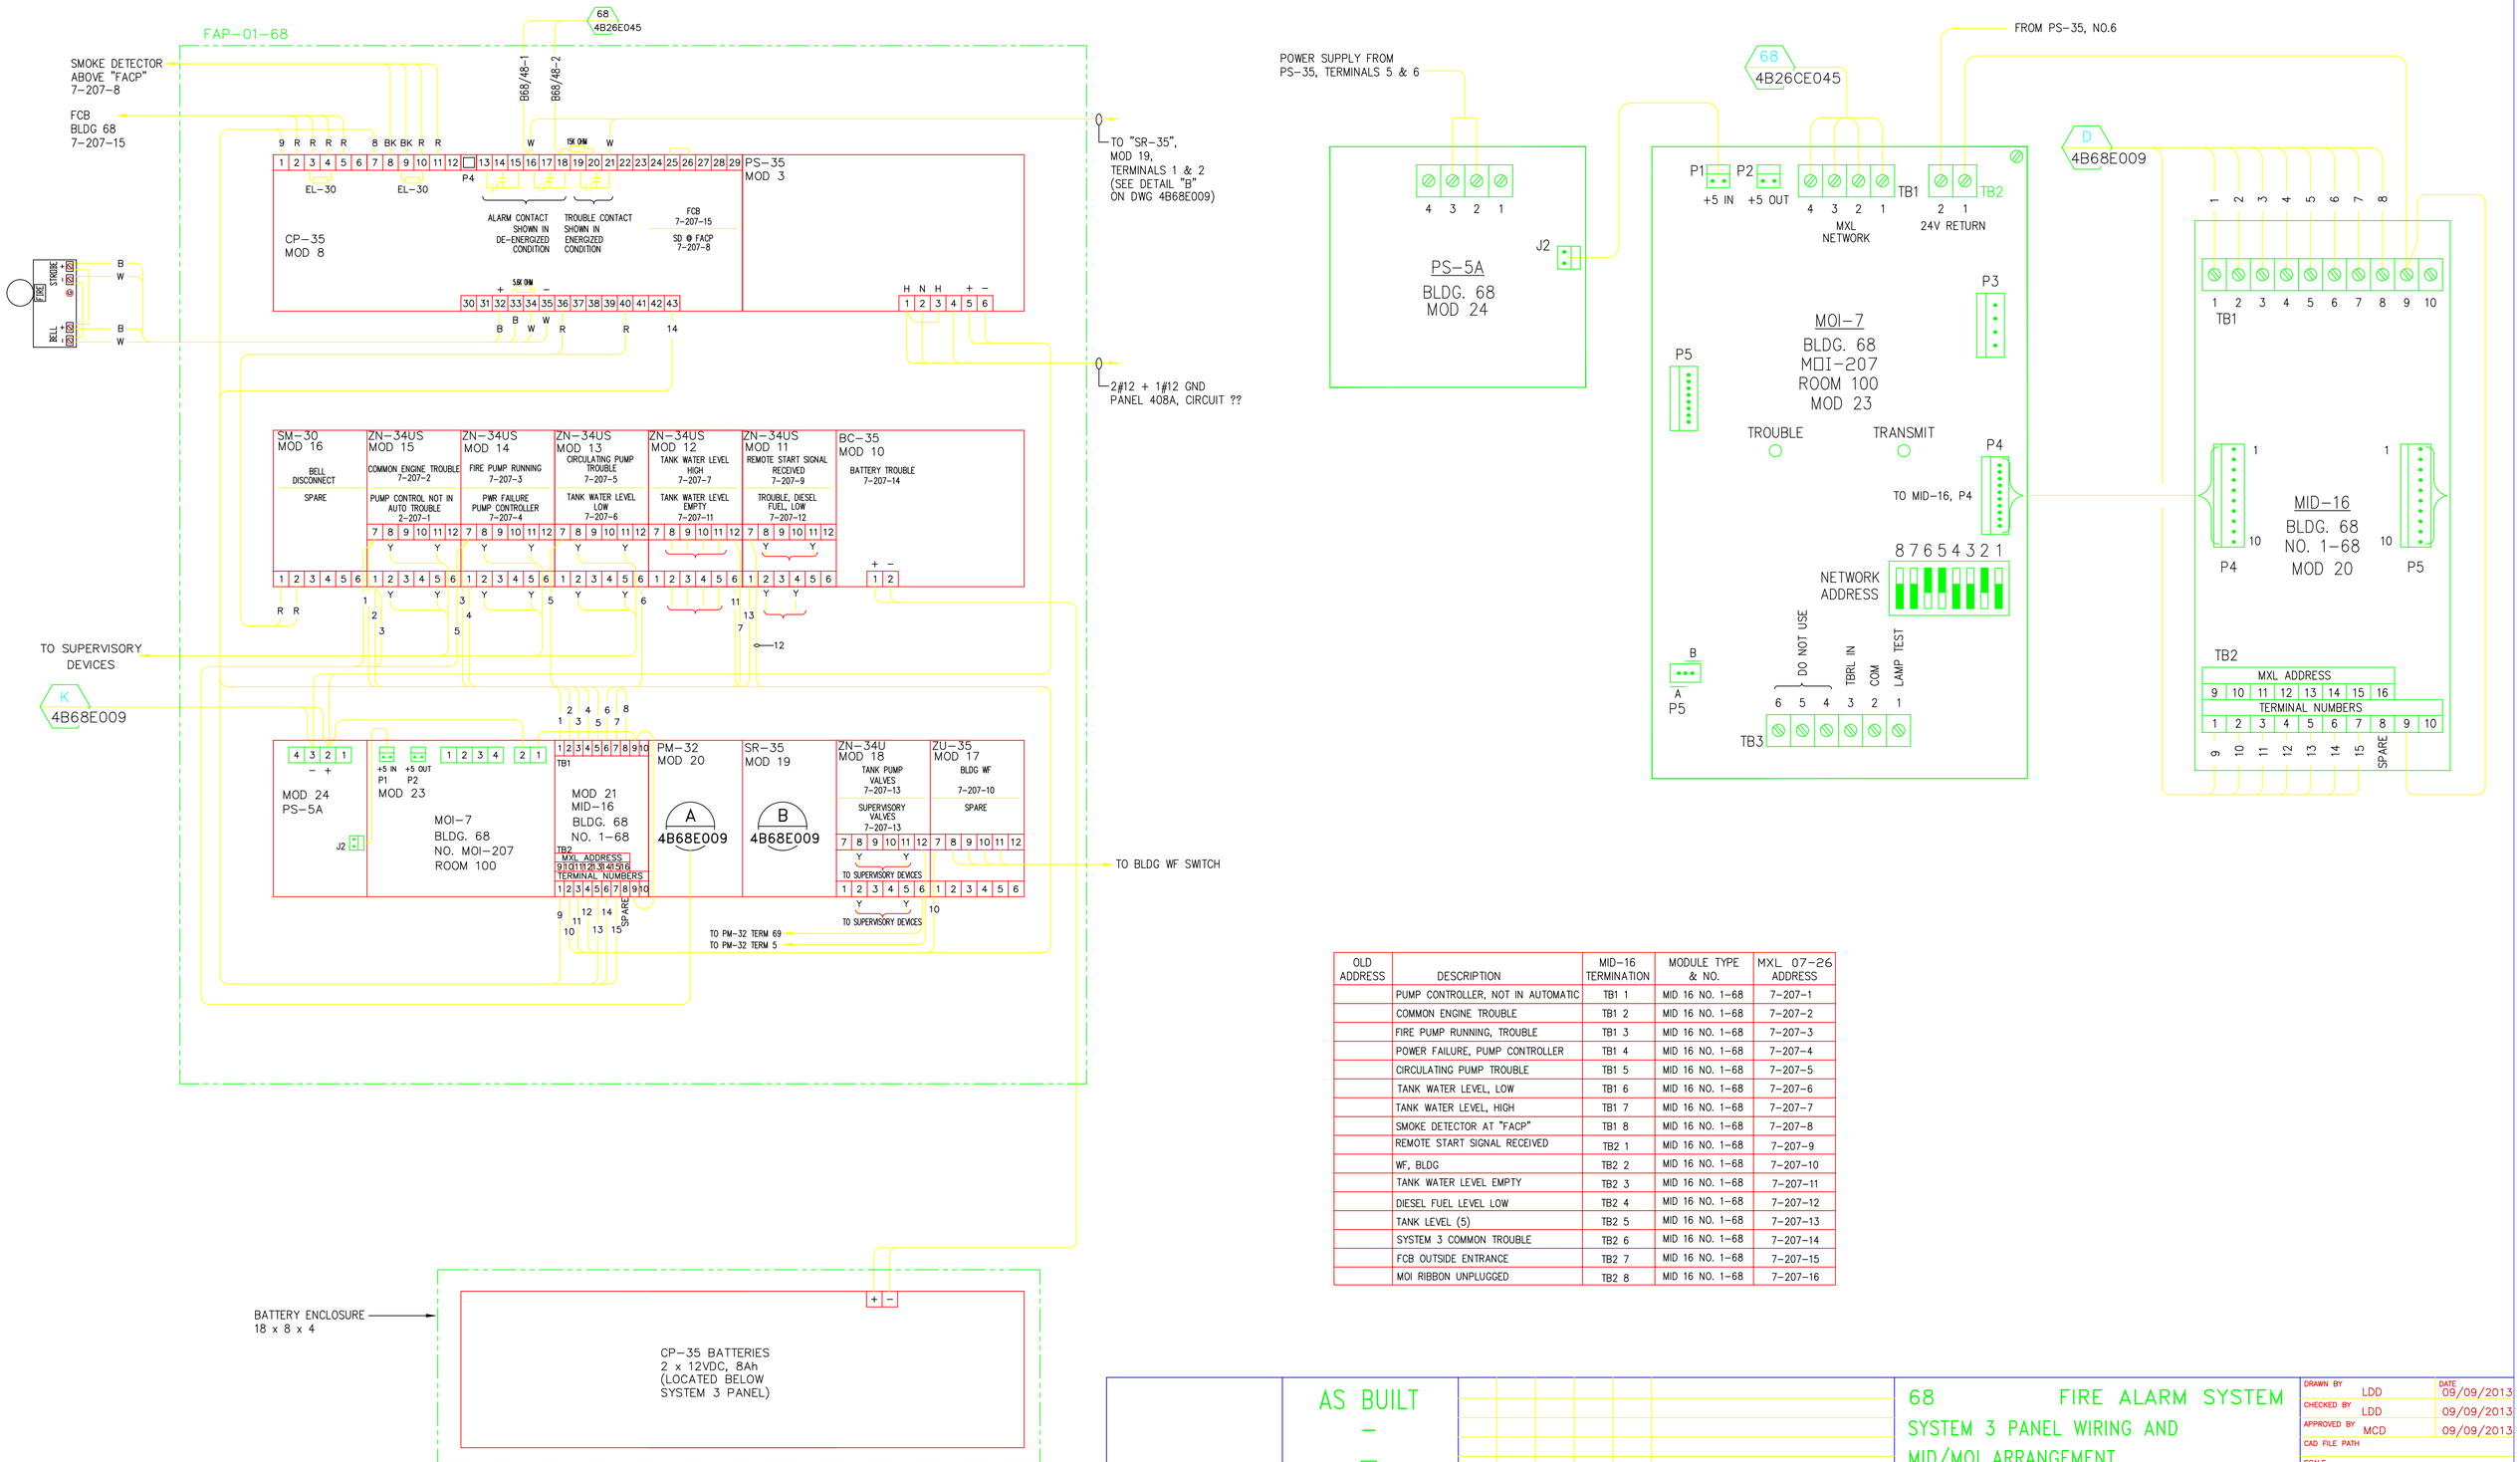

OLD ADDRESS	DESCRIPTION	MID-16 TERMINATION	MODULE TYPE & NO.	MXL 07-26 ADDRESS
	PUMP CONTROLLER, NOT IN AUTOMATIC	TB1 1	MID 16 NO. 1-68	7-207-1
	COMMON ENGINE TROUBLE	TB1 2	MID 16 NO. 1-68	7-207-2
	FIRE PUMP RUNNING, TROUBLE	TB1 3	MID 16 NO. 1-68	7-207-3
	POWER FAILURE, PUMP CONTROLLER	TB1 4	MID 16 NO. 1-68	7-207-4
	CIRCULATING PUMP TROUBLE	TB1 5	MID 16 NO. 1-68	7-207-5
	TANK WATER LEVEL, LOW	TB1 6	MID 16 NO. 1-68	7-207-6
	TANK WATER LEVEL, HIGH	TB1 7	MID 16 NO. 1-68	7-207-7
	SMOKE DETECTOR AT "FACP"	TB1 8	MID 16 NO. 1-68	7-207-8
	REMOTE START SIGNAL RECEIVED	TB2 1	MID 16 NO. 1-68	7-207-9
	WF, BLDG	TB2 2	MID 16 NO. 1-68	7-207-10
	TANK WATER LEVEL EMPTY	TB2 3	MID 16 NO. 1-68	7-207-11
	DIESEL FUEL LEVEL LOW	TB2 4	MID 16 NO. 1-68	7-207-12
	TANK LEVEL (5)	TB2 5	MID 16 NO. 1-68	7-207-13
	SYSTEM 3 COMMON TROUBLE	TB2 6	MID 16 NO. 1-68	7-207-14
	FCB OUTSIDE ENTRANCE	TB2 7	MID 16 NO. 1-68	7-207-15
	MOI RIBBON UNPLUGGED	TB2 8	MID 16 NO. 1-68	7-207-16

AS BUILT
–
–
09/09/13

REVISION NUMBER	DRAWN BY	CHECKED BY	APPR'D BY	DATE	REMARKS
–	LDD	LDD	MCD	09/09/13	AS BUILT PER FIELD VERIFICATIONS

PROFESSIONAL SEAL (IF REVISION, APPLIES ONLY TO REVISED WORK)

ISSUE (PROGRESS, ESTIMATE, BID, CONSTRUCTION, CONFORMED, REVISION, RECORD)

68 FIRE ALARM SYSTEM
SYSTEM 3 PANEL WIRING AND MID/MOI ARRANGEMENT

UNIVERSITY OF CALIFORNIA
LAWRENCE BERKELEY NATIONAL LABORATORY
FACILITIES DIVISION

		DATE
DRAWN BY	LDD	09/09/2013
CHECKED BY	LDD	09/09/2013
APPROVED BY	MCD	09/09/2013
CAD FILE PATH		
SCALE	Full	

DRAWING NO. 4B68E010_
PROJECT NO. 000000
SHEET FA3 3 OF 3