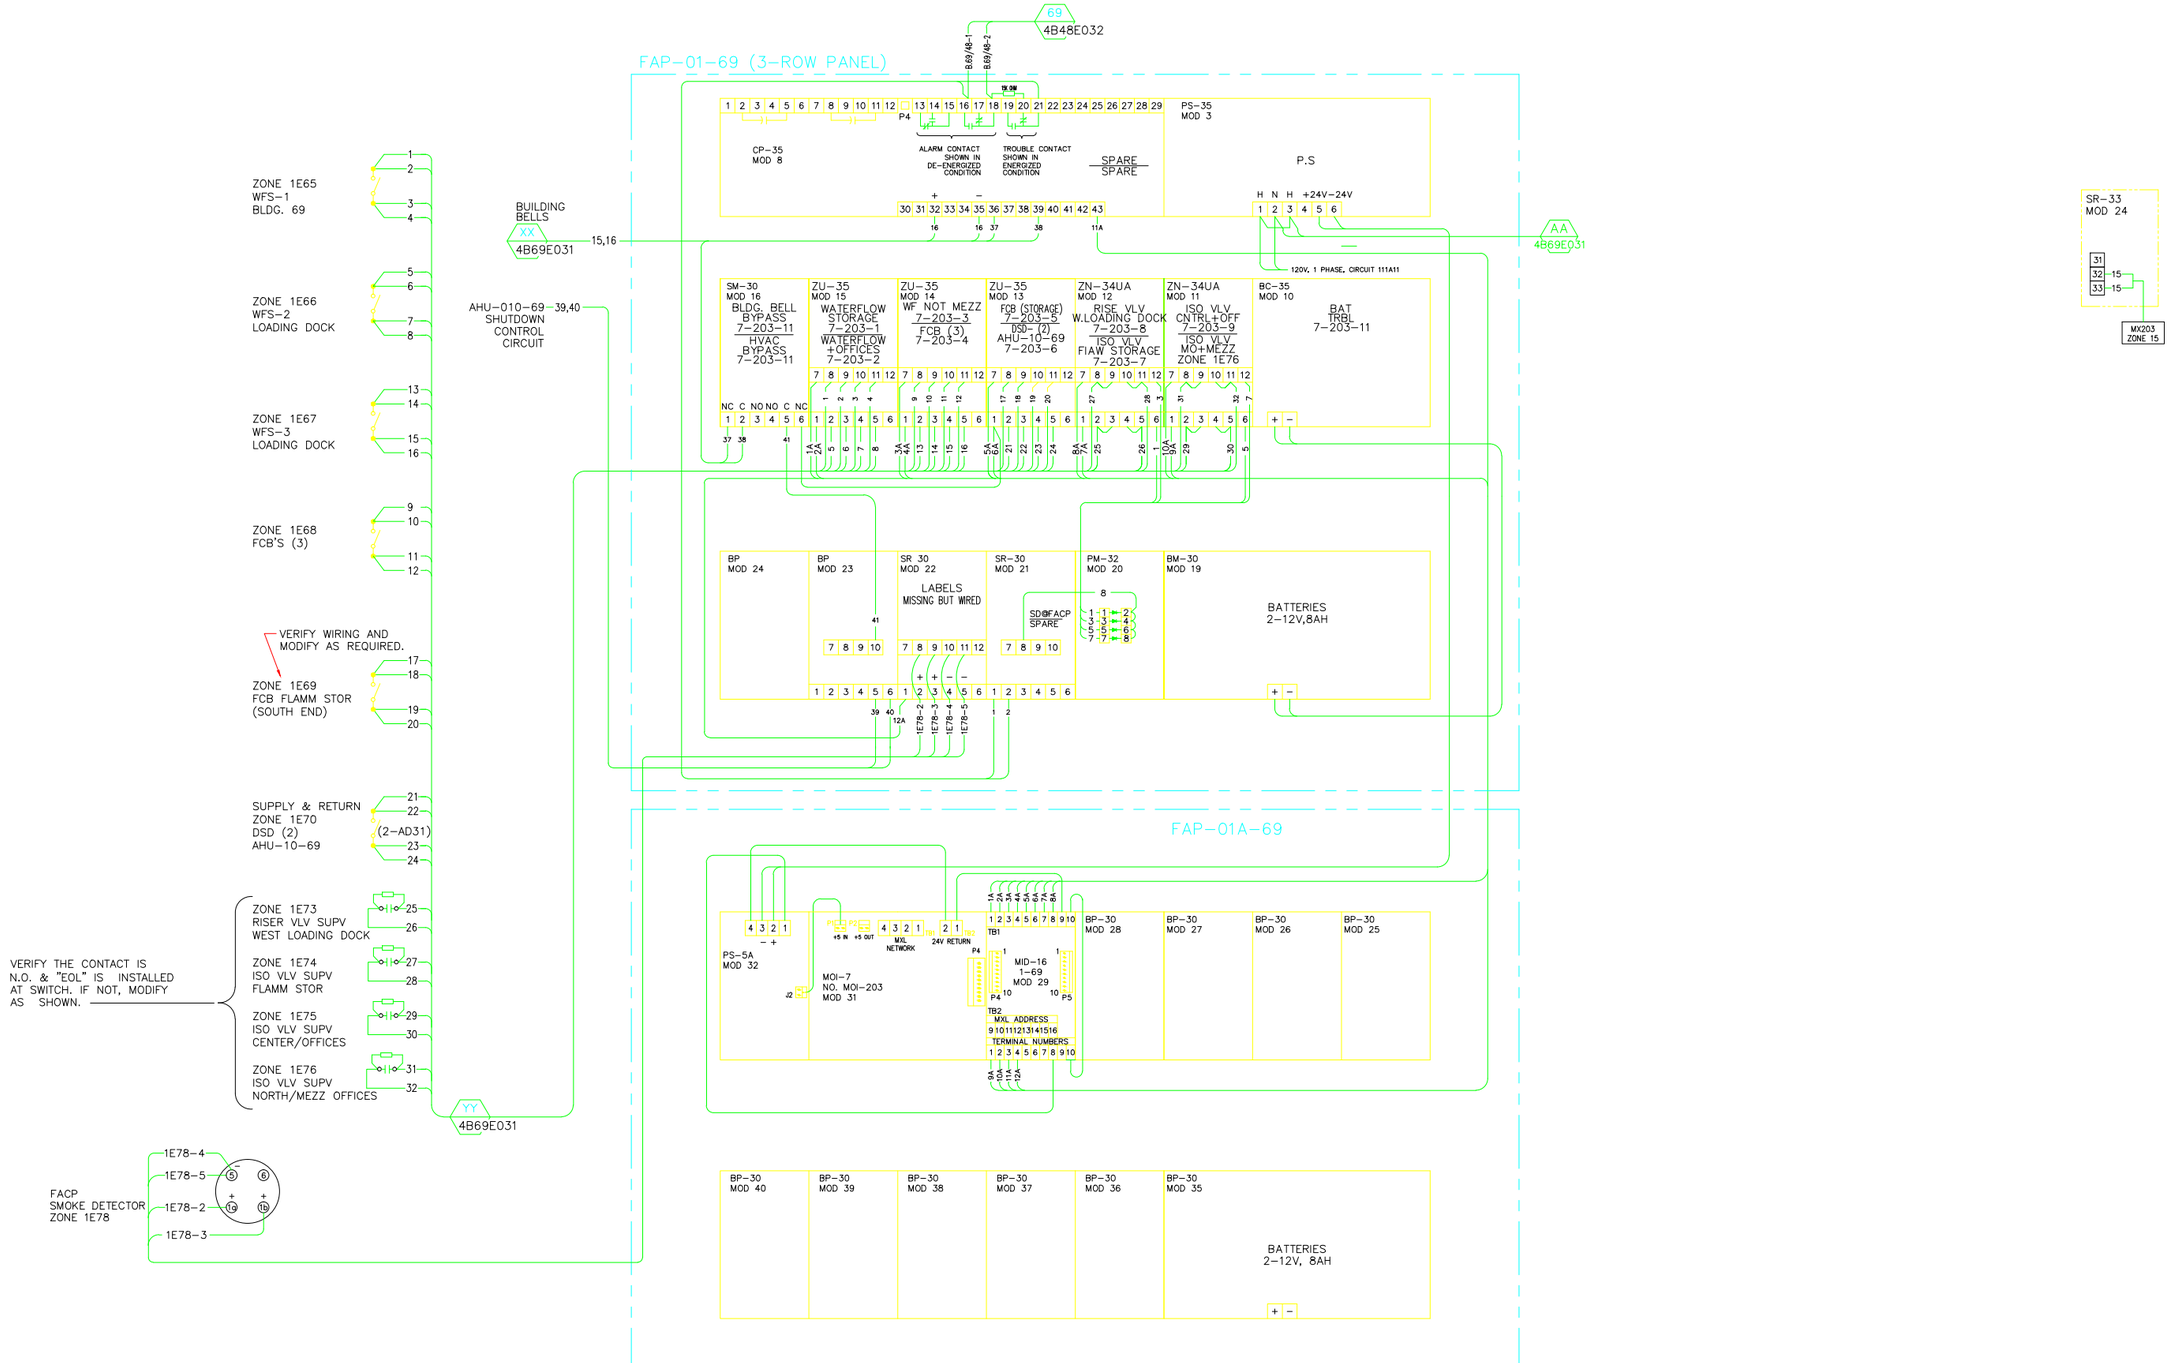

	AS BUILT	G	DSV	LDD	MCD	5/31/13	AS BUILT PER FIELD VERIFICATION
		F				5/15/09	AS-BUILD
		E				9/30/08	AS-BUILD
		D	AD	LDD	MCD	12/04/06	AS-BUILD RECORD DRAWING PER CONSTRUCTION MARK-UP
		C	AD	MCG	MCG	04/21/05	REVISED FOR MXL/DIGITIZE SYSTEMS
		B	AD	AD	MCG	12/17/03	AS-BUILT, RECORD DRAWING
		A	MRC	AD	MCG	11/03/03	AS-BUILT, PHASE II FA UPGRADE
PROFESSIONAL SEAL (IF REVISION, APPLIES ONLY TO REVISED WORK)	ISSUE (PROGRESS, ESTIMATE, BID, CONSTRUCTION, CONFORMED, REVISION, RECORD)	REVISION NUMBER	DRAWN BY	CHECKED BY	APPR'D BY	DATE	REMARKS

5/31/13

69 FIRE ALARM

FAP-01 & -01A-69

SYSTEM 3 WIRING DIAGRAM

UNIVERSITY OF CALIFORNIA
LAWRENCE BERKELEY NATIONAL LABORATORY
FACILITIES DIVISION

DRAWN BY	MRC	DATE 11/5/200
CHECKED BY	AD	11/5/200
APPROVED BY	MCG	11/5/200
CAD FILE PATH		
SCALE	Full	
DRAWING NO.	4B69E052G	SHEET
PROJECT NO.	FA8040	1 OF 1