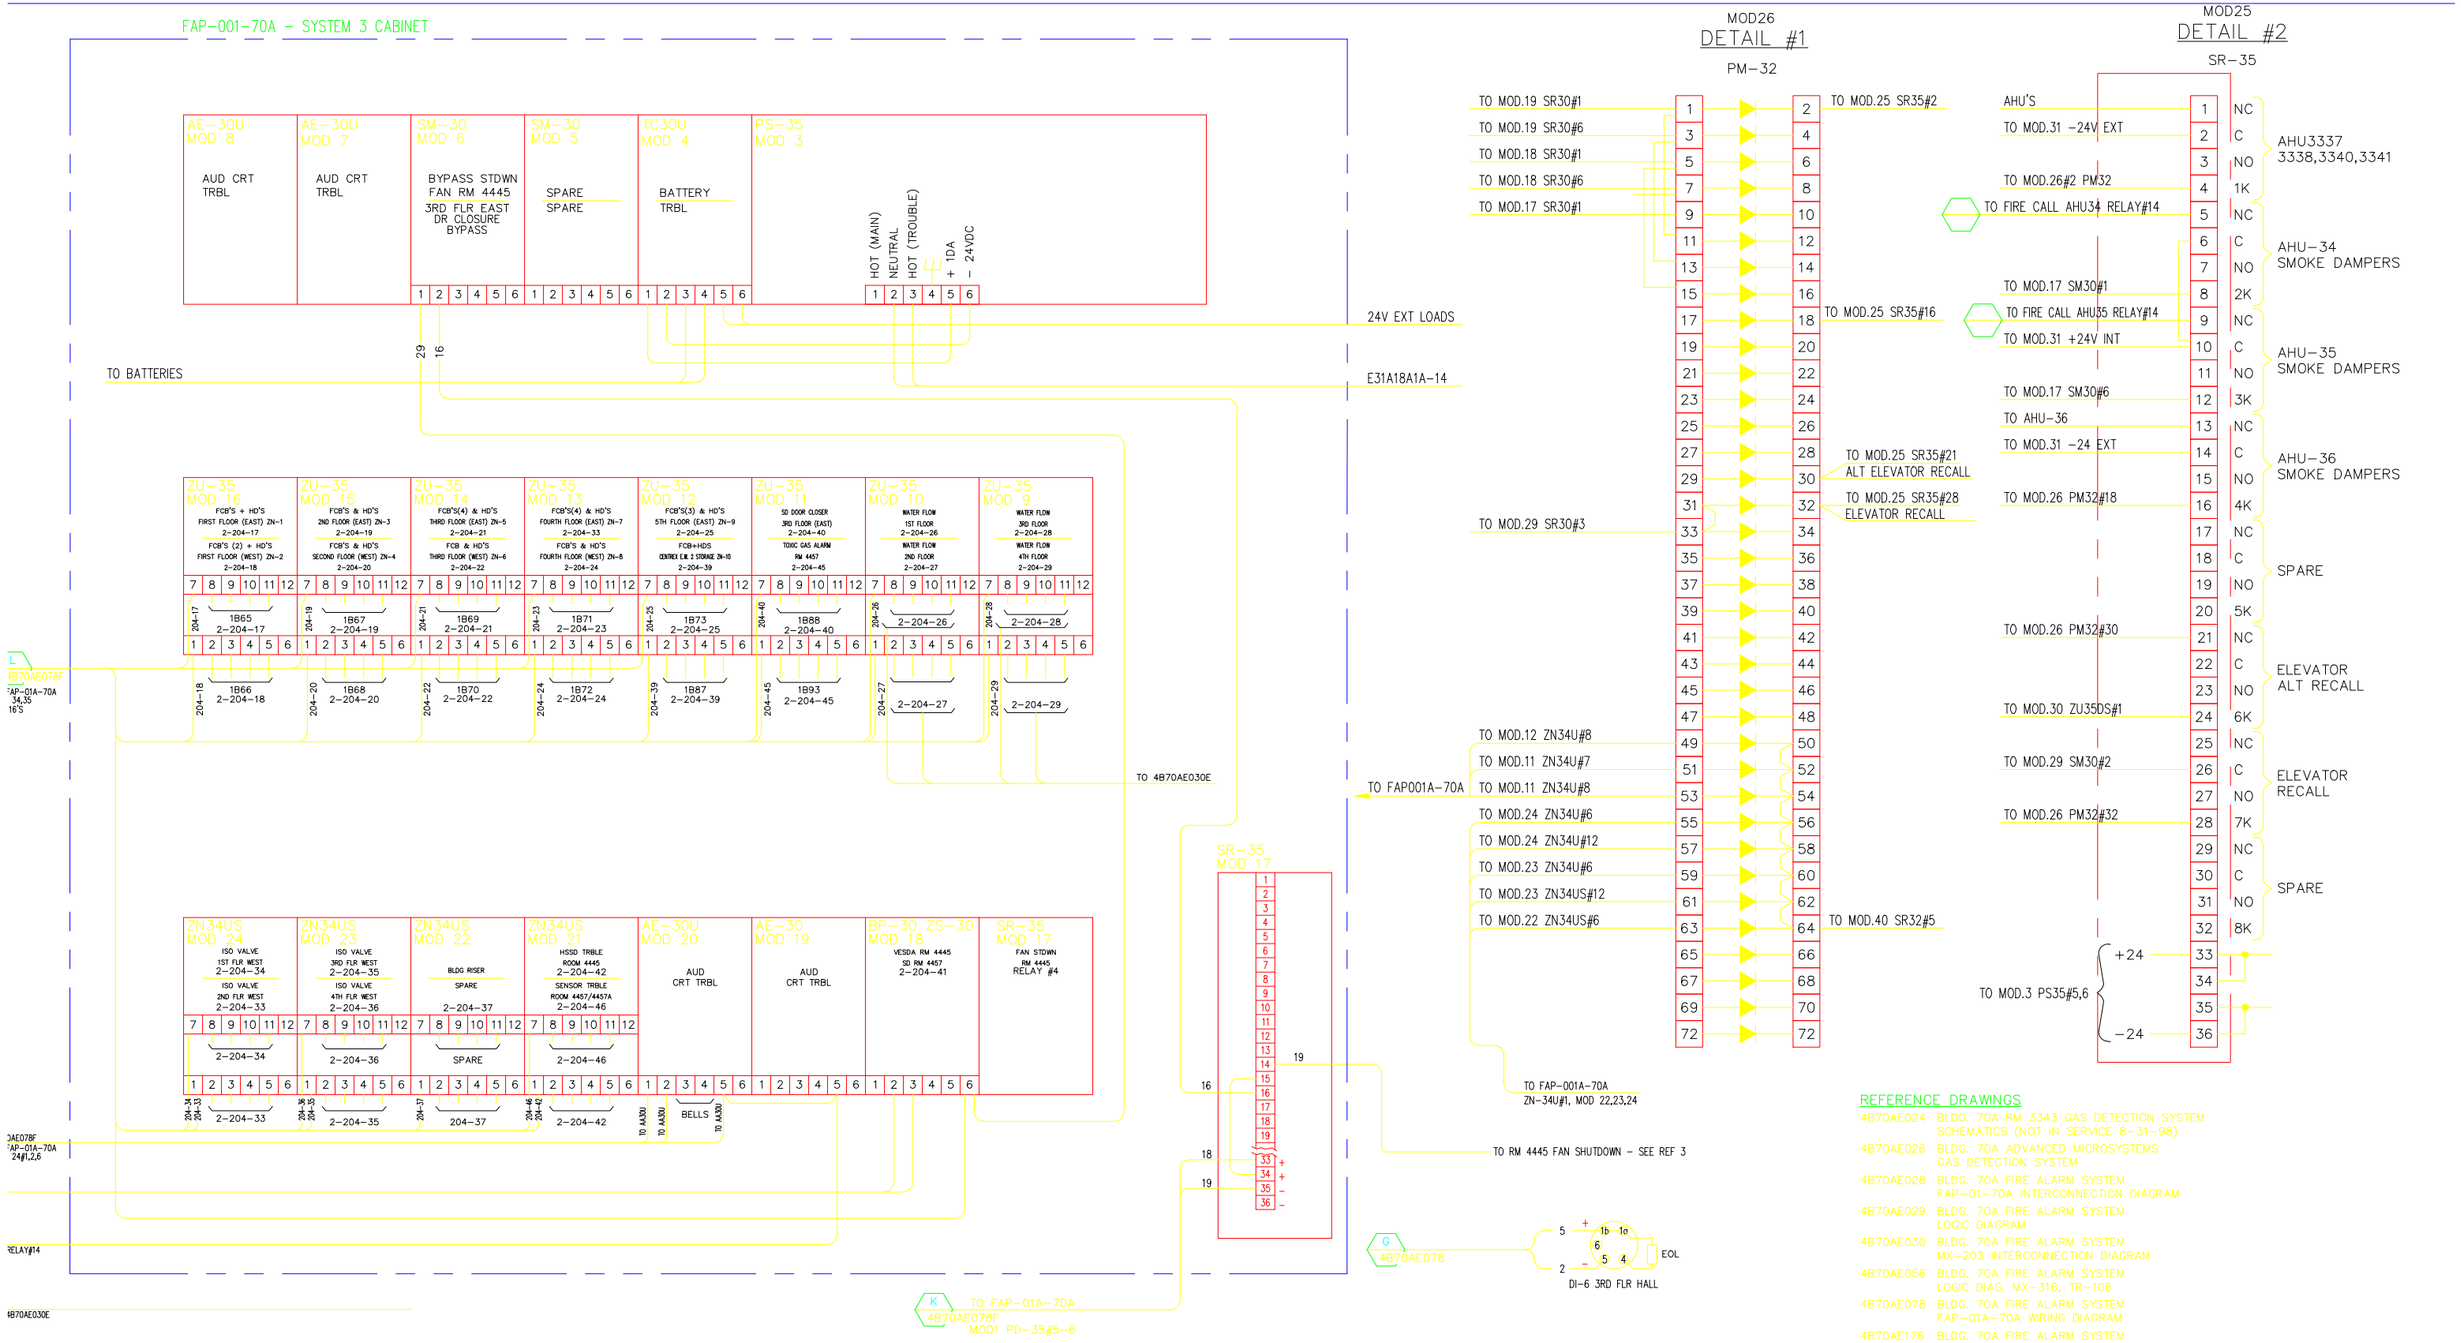

REFERENCE DRAWINGS

- 4B70AE024 BLDG. 70A RM 3343 GAS DETECTION SYSTEM SCHEMATICS (NOT IN SERVICE 8-31-98)
- 4B70AE026 BLDG. 70A ADVANCED MICROSYSTEMS GAS DETECTION SYSTEM
- 4B70AE028 BLDG. 70A FIRE ALARM SYSTEM FAP-01-70A INTERCONNECTION DIAGRAM
- 4B70AE029 BLDG. 70A FIRE ALARM SYSTEM LOGIC DIAGRAM
- 4B70AE030 BLDG. 70A FIRE ALARM SYSTEM MX-203 INTERCONNECTION DIAGRAM
- 4B70AE056 BLDG. 70A FIRE ALARM SYSTEM LOGIC DIAG. MX-316, TR-106
- 4B70AE078 BLDG. 70A FIRE ALARM SYSTEM FAP-01A-70A WIRING DIAGRAM
- 4B70AE176 BLDG. 70A FIRE ALARM SYSTEM FAP-01B-70A, SR-35 RELAYS WRG. DIAG. & ELEV.
- 4B70AE177 BLDG. 70A FIRE ALARM SYSTEM MOI/MID MODULE ARRANGEMENT

REVISION NUMBER	DRAWN BY	CHECKED BY	APPR'D BY	DATE	REMARKS
N	DSV	LDD	MCD	6/6/13	AS BUILT PER FIELD VERIFICATION
M				5/15/09	AS-BUILT
L				9/30/08	AS-BUILT
K	AD	–	–	11/08/07	ISSUED FOR REFERENCE ONLY
J	AD	LDD	MCD	10/03/07	FIRE ALARM SYSTEM UPGRADE
H	MRC	AD	MCG	7/20/04	PHASE III FIRE ALARM SYSTEM UPGRADE
G	IPM	VDA	MCG	8/22/02	AS-BUIT

70A FIRE ALARM SYSTEM
FAP-01-70A
INTERCONNECTION DIAGRAM

UNIVERSITY OF CALIFORNIA LAWRENCE BERKELEY LABORATORY
FACILITIES DEPARTMENT

		DATE
DRAWN BY	LSR	3/19/19
CHECKED BY	RG	8/30/19
APPROVED BY	RMG	8/30/19
CAD FILE PATH		
SCALE	As Noted	
DRAWING NO.	4B70AE028N	SHEET
PROJECT NO.	FB4010	1 OF 1