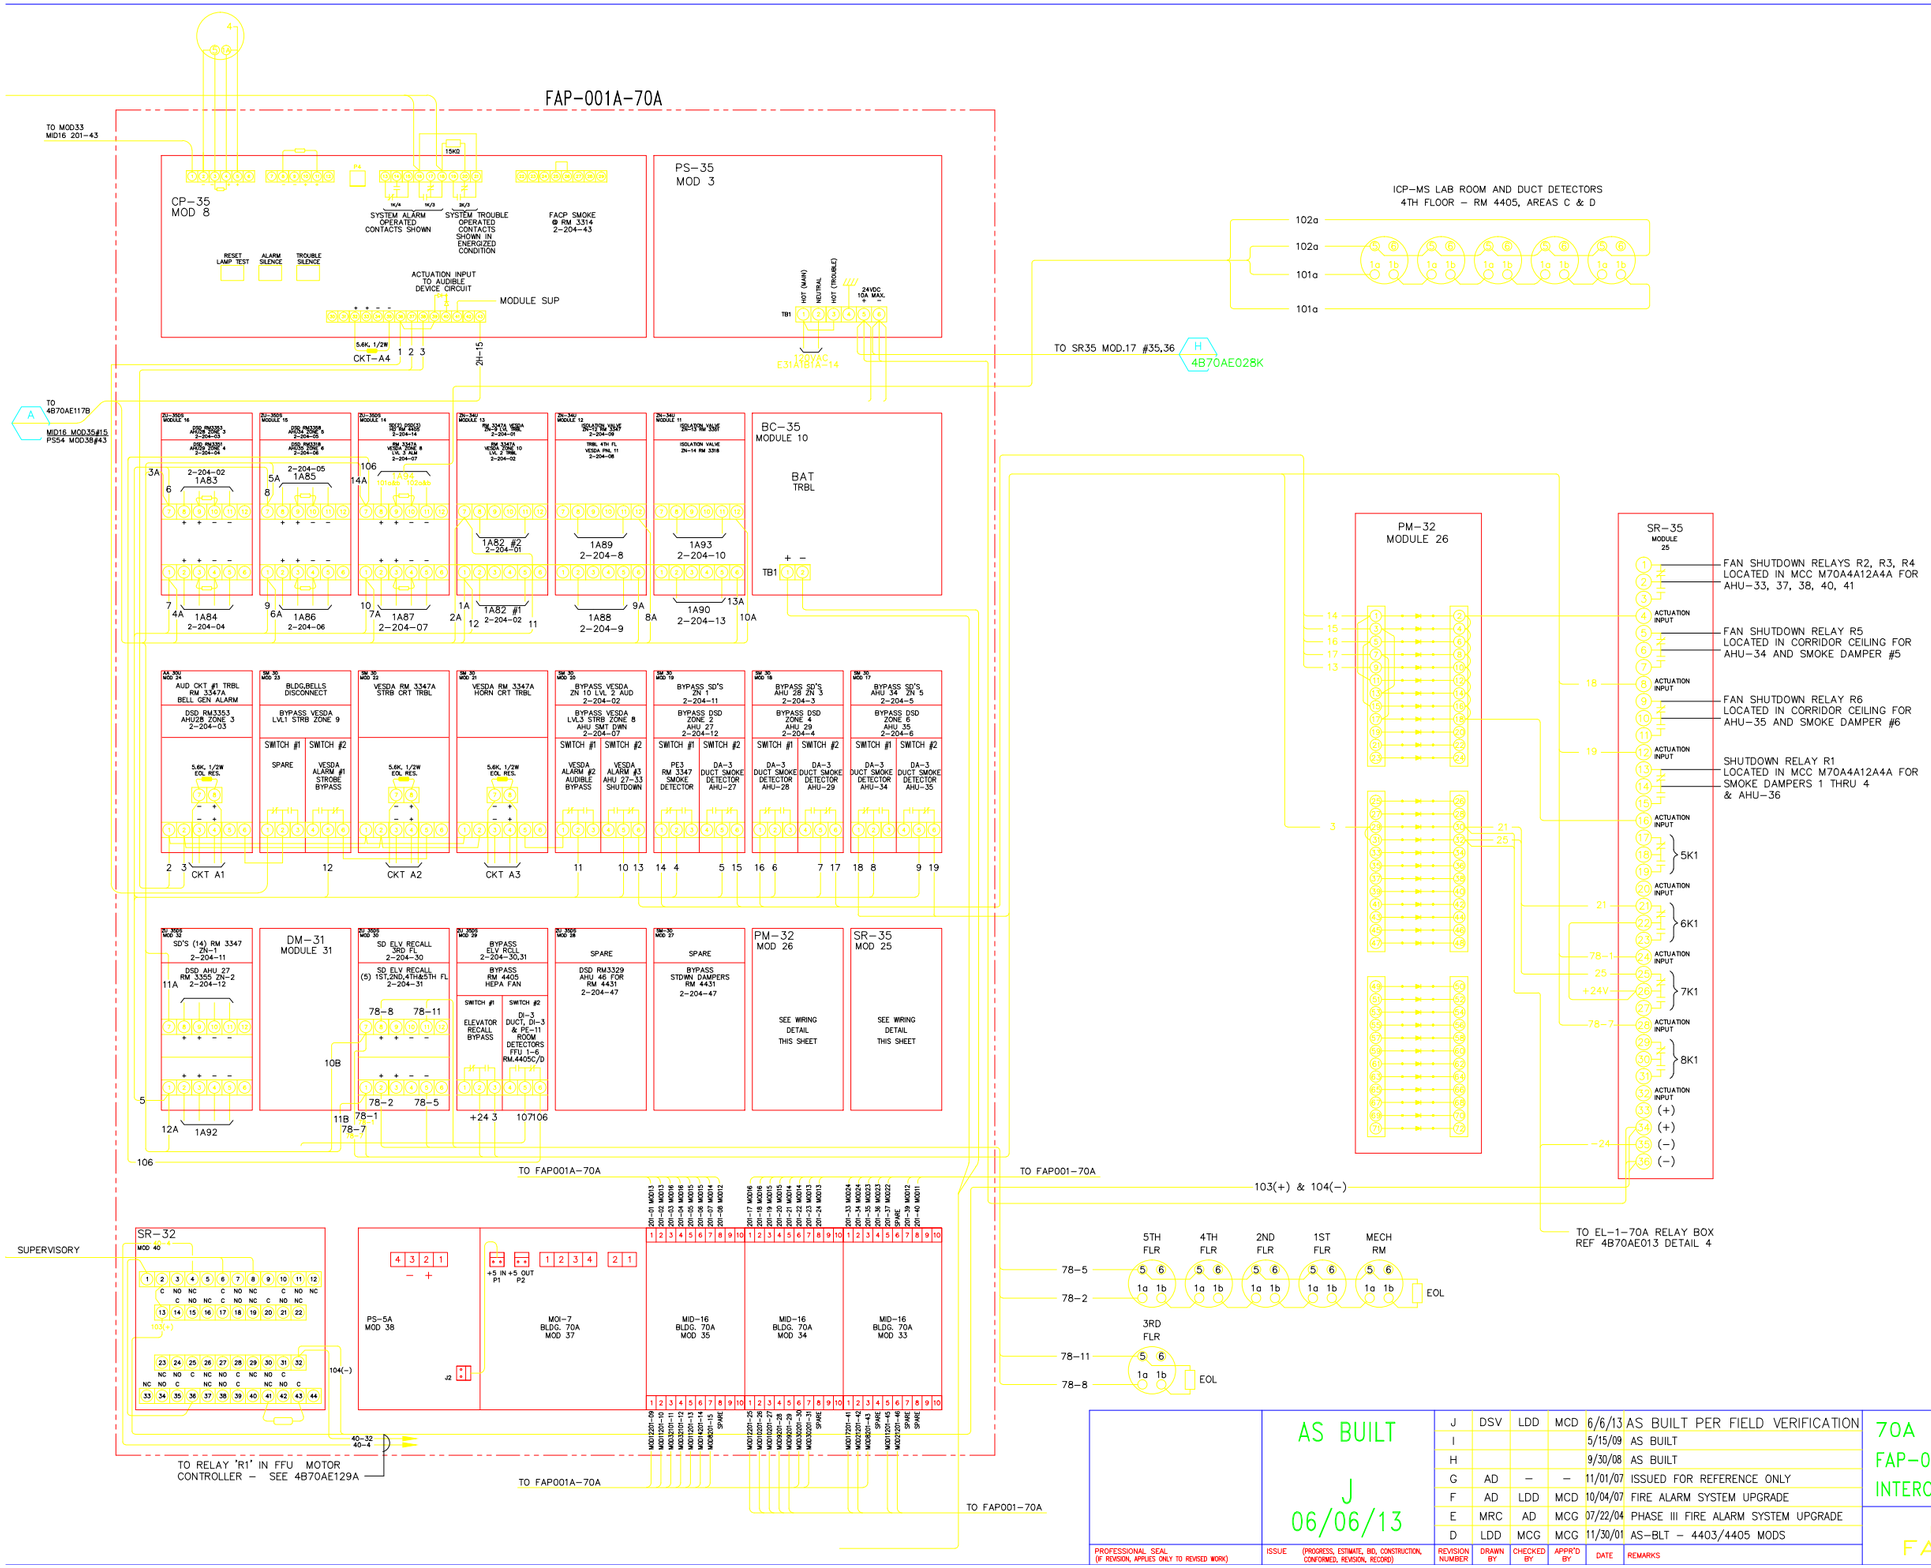

AS BUILT

J

06/06/13

REVISION NUMBER	DRAWN BY	CHECKED BY	APPR'D BY	DATE	REMARKS
J	DSV	LDD	MCD	6/6/13	AS BUILT PER FIELD VERIFICATION
I				5/15/09	AS BUILT
H				9/30/08	AS BUILT
G	AD	–	–	11/01/07	ISSUED FOR REFERENCE ONLY
F	AD	LDD	MCD	10/04/07	FIRE ALARM SYSTEM UPGRADE
E	MRC	AD	MCG	07/22/04	PHASE III FIRE ALARM SYSTEM UPGRADE
D	LDD	MCG	MCG	11/30/01	AS-BLT – 4403/4405 MODS

PROFESSIONAL SEAL (IF REVISION, APPLIES ONLY TO REVISED WORK)

ISSUE (PROGRESS, ESTIMATE, BID, CONSTRUCTION, CONFORMED, REVISION, RECORD)

70A FIRE ALARM SYSTEM

FAP-001A-70A

INTERCONNECTION DIAGRAM

UNIVERSITY OF CALIFORNIA
LAWRENCE BERKELEY NATIONAL LABORATORY
FACILITIES DIVISION

DRAWN BY	RZT	DATE 1/29/199
CHECKED BY	MCG	1/29/199
APPROVED BY	MCG	1/29/199
CAD FILE PATH		
SCALE	As Noted	
DRAWING NO.	4B70AE078J	SHEET
PROJECT NO.	FB4010	1 OF 1