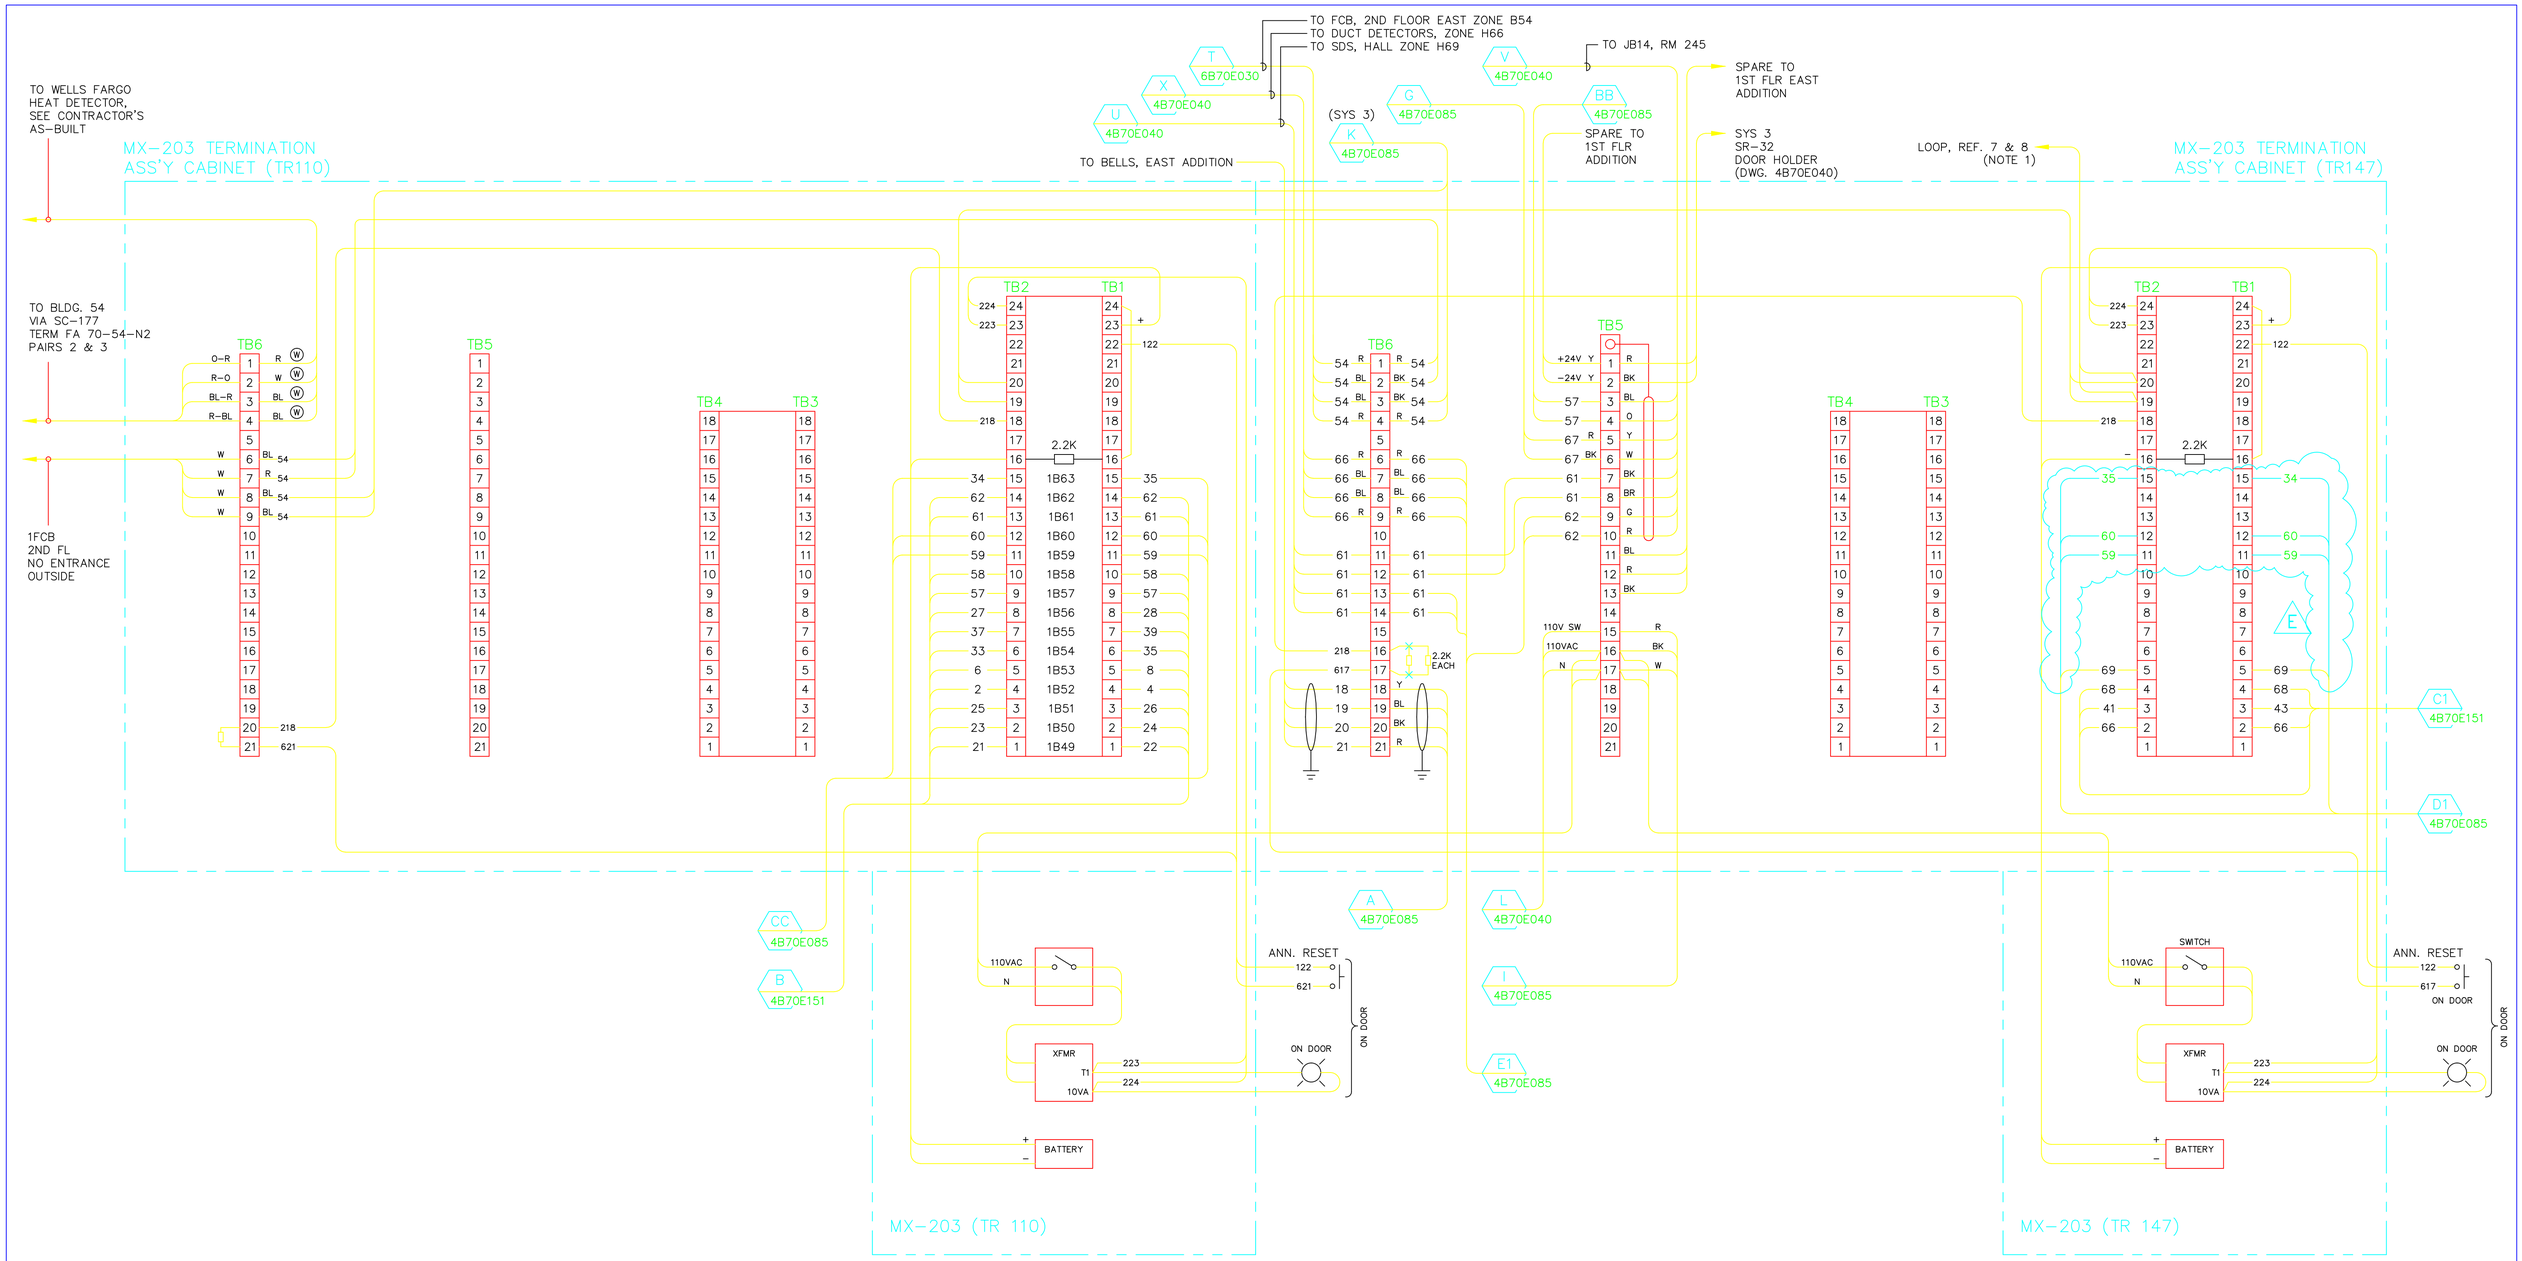

		F	AD	LDD	MCD	10/05/07	FIRE ALARM SYSTEM UPGRADE
		E	MRC	AD	MCG	06-30-04	PHASE III FIRE ALARM UPGRADE
		D	ROB	MCG	MCG	10-23-00	AS-BUILT
		C	LM		MCG	3-11-97	REDRAWN ON AUTOCAD, ADDED FIELD COMMENTS
		B	LSR	RG	RMG	11-15-88	MINOR REVISIONS
		A	LSR	RG		11/85	CHANGED DWG. NO., "J" CABLE
PROFESSIONAL SEAL (IF REVISION, APPLIES ONLY TO REVISED WORK)	ISSUE (PROGRESS, ESTIMATE, BID, CONSTRUCTION, CONFORMED, REVISION, RECORD)	REVISION NUMBER	DRAWN BY	CHECKED BY	APPR'D BY	DATE	REMARKS

TITLE 2
CONSTRUCTION
F
10/5/2007

70 FIRE ALARM SYSTEM
MX-203 TR110 & TR147
INTERCONNECTION DIAGRAM

UNIVERSITY OF CALIFORNIA
LAWRENCE BERKELEY NATIONAL LABORATORY
FACILITIES DIVISION

DRAWN BY	LSR
DATE	5/5/2004
CHECKED BY	
APPROVED BY	
CAD FILE PATH	00022692
SCALE	As Noted
DRAWING NO.	4B70E039F
SHEET	1 OF 1
PROJECT NO.	FB4010