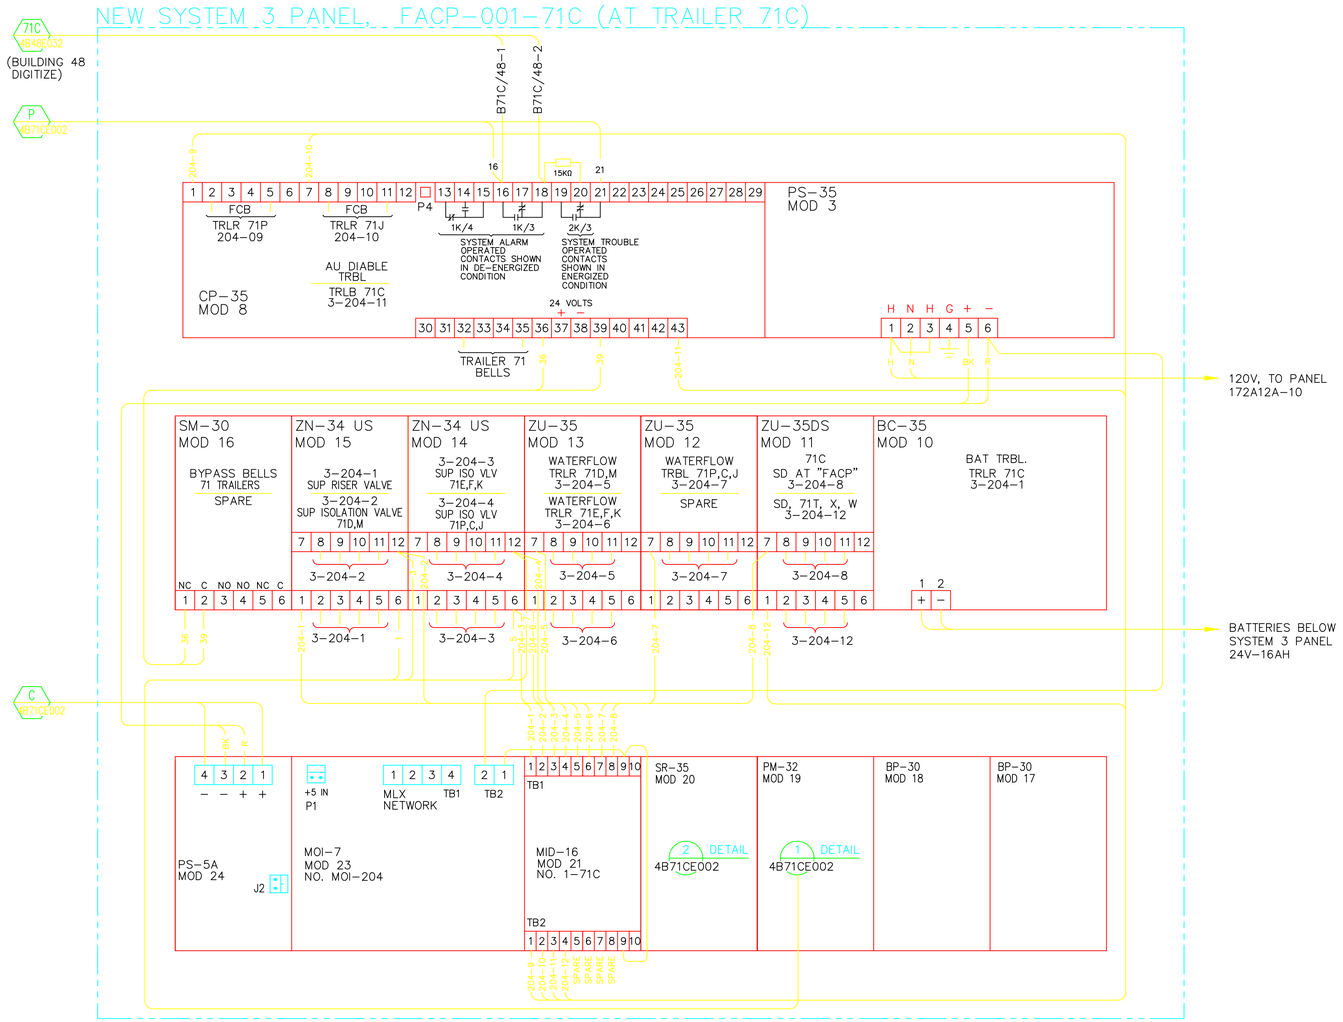

	AS BUILT	C	DSV	LDD	MCD	6/10/13	AS BUILT PER FIELD VERIFICATION
	C 6/1013	B	AD	LDD	MCD	01/07/08	AS-BUILT RECORD DRAWING
		A	AD	LDD	MCD	10/05/07	FIRE ALARM SYSTEM UPGRADE
PROFESSIONAL SEAL (IF REVISION, APPLIES ONLY TO REVISED WORK)	ISSUE (PROGRESS, ESTIMATE, BID, CONSTRUCTION, CONFORMED, REVISION, RECORD)	REVISION NUMBER	DRAWN BY	CHECKED BY	APPR'D BY	DATE	REMARKS

71C TRAILER

FIRE ALARM SYSTEM

FACP-001-71C, LOOP NO. 3

UNIVERSITY OF CALIFORNIA
LAWRENCE BERKELEY NATIONAL LABORATORY
FACILITIES DIVISION

DRAWN BY	MRC	9/8/2008
CHECKED BY	AD	9/8/2008
APPROVED BY	MCG	9/8/2008
CAD FILE PATH		
SCALE	Full	
DRAWING NO.	4B71CE001C	SHEET 1 OF 1
PROJECT NO.	FB4010	