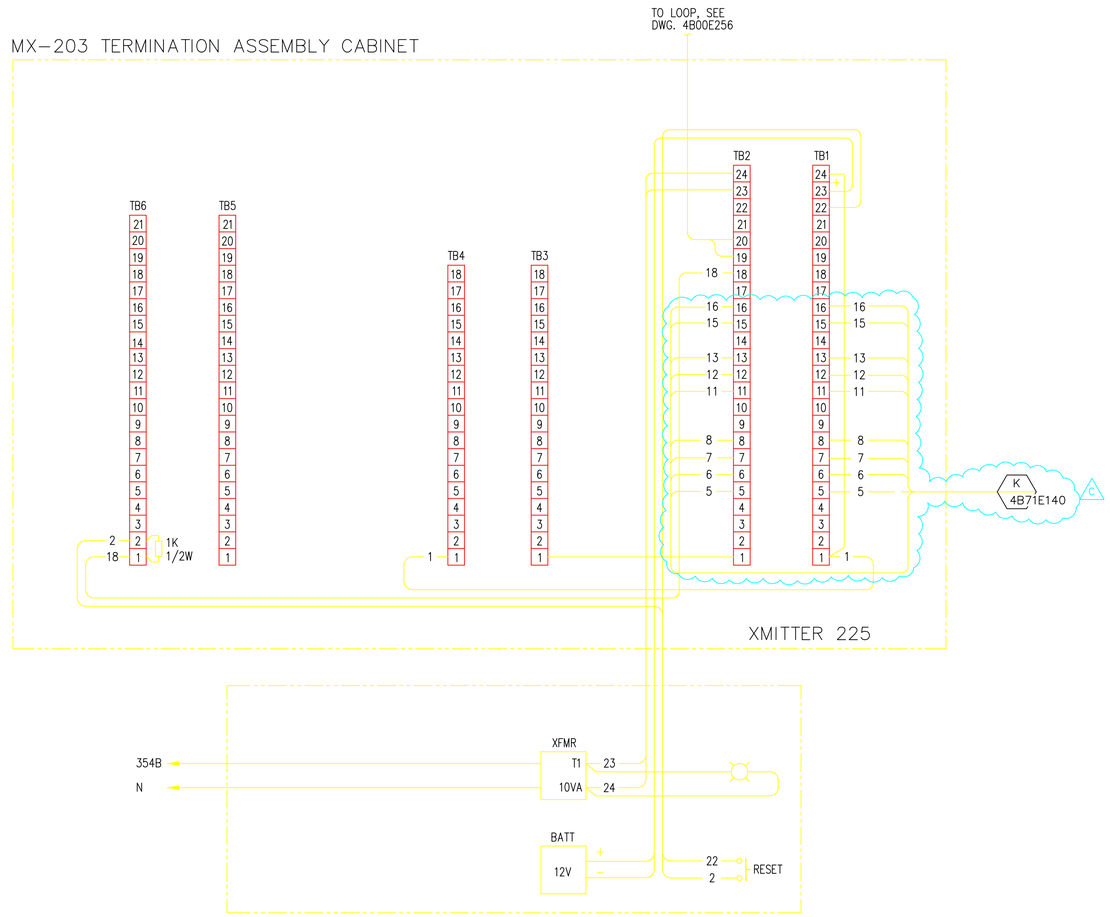

	AS BUILT — 08/12/13						
		—	LDD	LDD	MCD	08/12/13	AS BUILT – WAS 4B71E056C
PROFESSIONAL SEAL (IF REVISION, APPLIES ONLY TO REVISED WORK)	ISSUE (PROGRESS, ESTIMATE, BID, CONSTRUCTION, CONFORMED, REVISION, RECORD)	REVISION NUMBER	DRAWN BY	CHECKED BY	APPR'D BY	DATE	REMARKS

71C TRAILER COMPLEX

FIRE ALARM SYSTEM

XMITTER 225, MX-203 WIRING

UNIVERSITY OF CALIFORNIA
LAWRENCE BERKELEY NATIONAL LABORATORY
FACILITIES DIVISION

DRAWN BY	RG	DATE 3/27/1987
CHECKED BY	BHS	3/27/1987
APPROVED BY	BHS	3/27/1987
CAD FILE PATH		
SCALE	As Noted	
DRAWING NO.	4B71CE004_	SHEET
PROJECT NO.	000000	1 OF 1