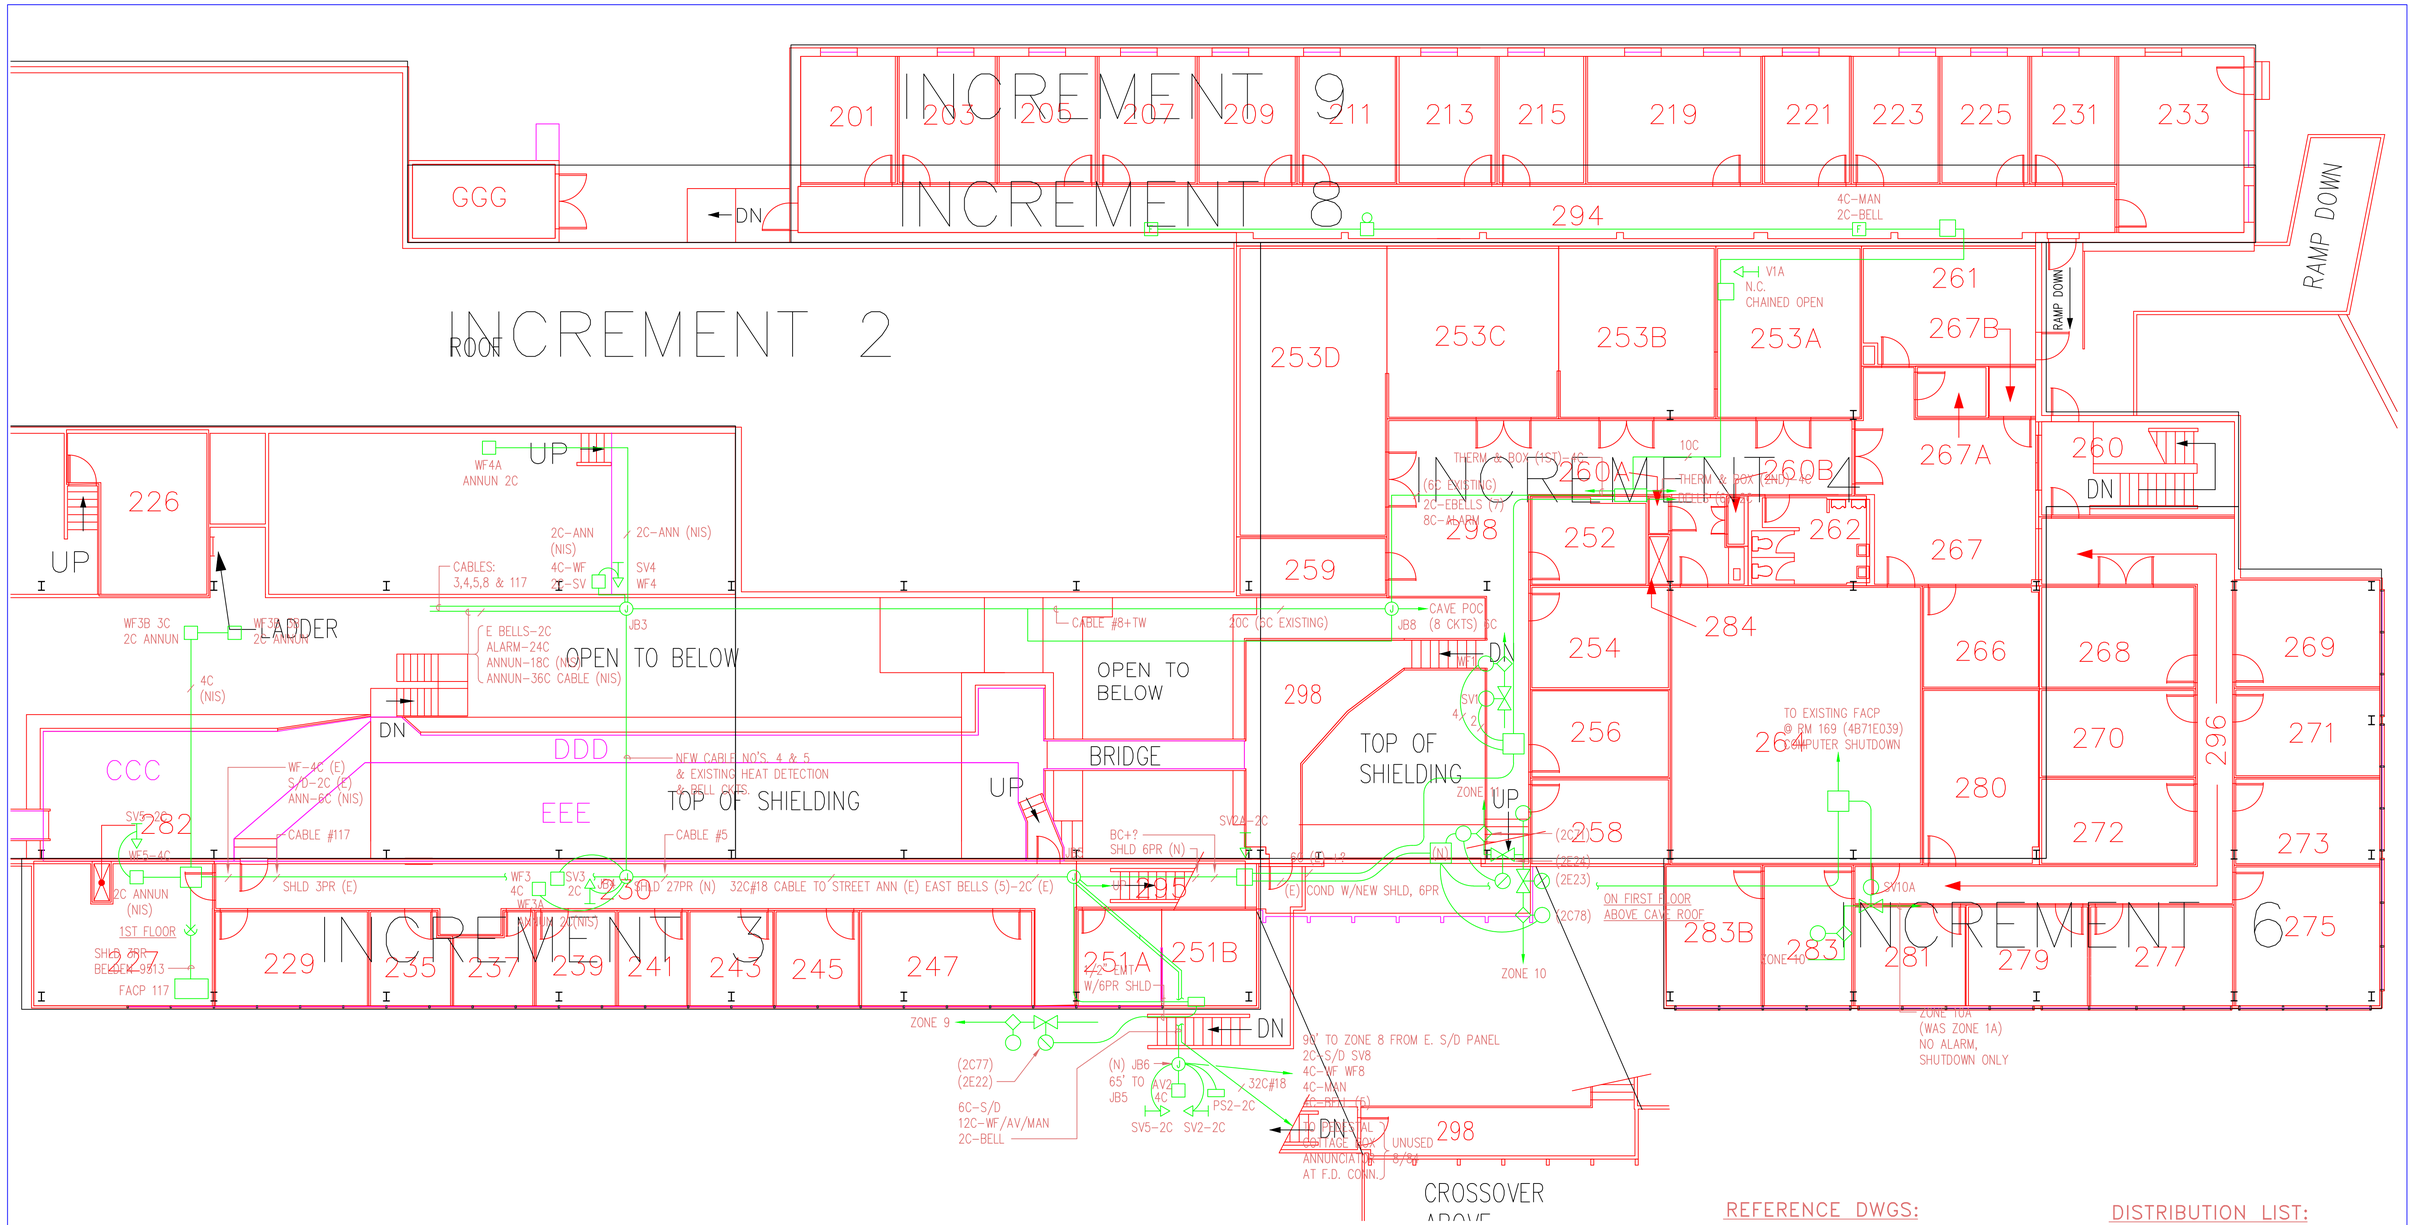

REFERENCE DWGS:

DWG. 6R7754

DISTRIBUTION LIST:

2 – ELECTRIC SHOP B76 (FILE I & II)
1 – B90J (FILE III)
1 – STICK FILE
ORIGINAL – FLAT FILE B90F

WAS DWG. 6R7784

LEGEND:

S/D	SUPERVISED DEVICES
AV	DRY SYSTEM PREACTION OR DELUGE SYSTEM RELEASE
WF	WATER FLOW
PS	PRESSURE SWITCH
SV	SUPERVISED VALVE
THERM	TEMPERATURE SENSOR (FEN WAL)
ANNUN	NON-SUPERVISED SENSOR/ INDICATOR CIRCUIT
MAN	PULL BOX

8' 4' 0 8' 16'
SCALE: 1/8" = 1'-0"

REVISION NUMBER	DRAWN BY	CHECKED BY	APPR'D BY	DATE	REMARKS
C	LM		MCG	7/14/98	AUTOCAD CONVERSION
B	LSR		BHS	7/88	REV A AS BUILT
A	RG		BHS	3/88	ADDED ZONES 9,10 & 11, CHANGED FACP 117

71 FIRE ALARM
EAST END RIGHT OF WAY
HEAVY ION ACCELERATOR

UNIVERSITY OF CALIFORNIA LAWRENCE BERKELEY LABORATORY
FACILITIES DEPARTMENT

		DATE
DRAWN BY	AR	
CHECKED BY	RG	2/17/96
APPROVED BY		2/17/96
CAD FILE PATH	00006856	
SCALE	AS SHOWN	
DRAWING NO.	4B71E049C	SHEET —
PROJECT NO.	FA8040	