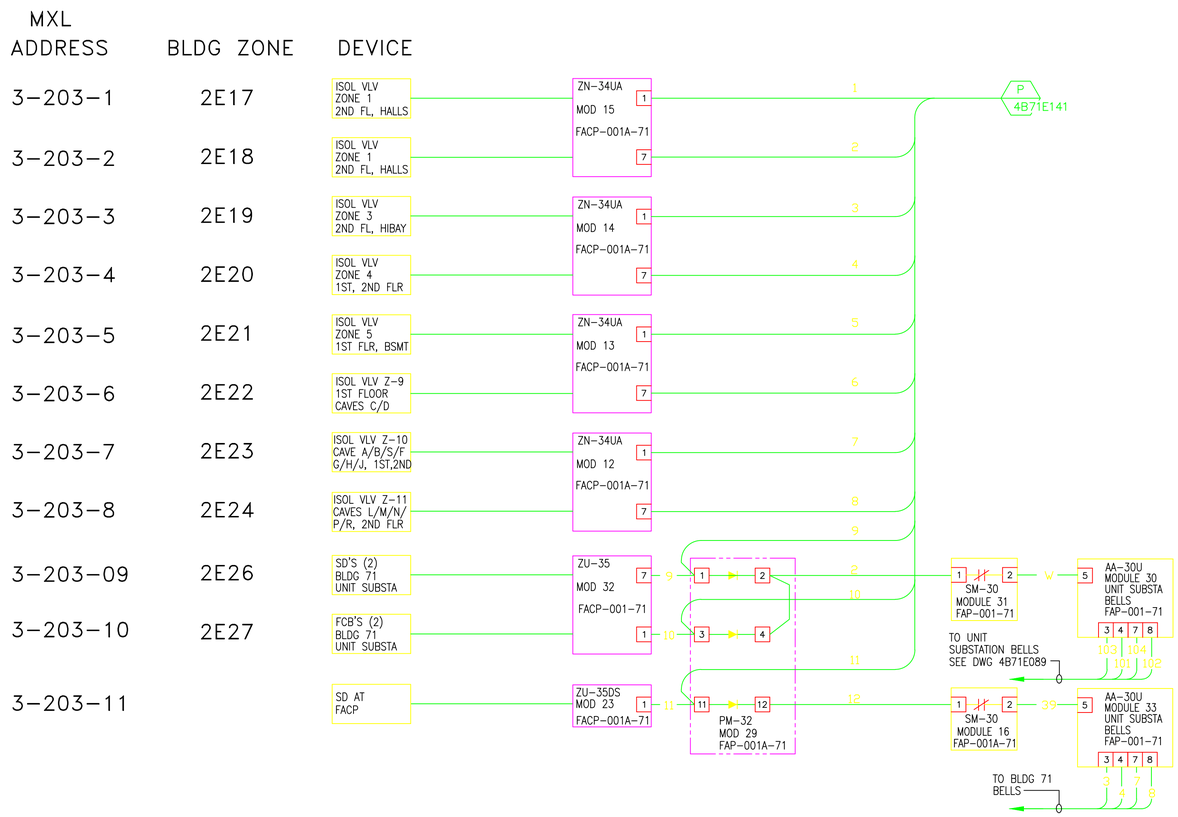

NOTES:

1. SEE DRAWING 4B71E041 FOR COMPLETE REFERENCE DRAWING LIST.

PROFESSIONAL SEAL (IF REVISION, APPLIES ONLY TO REVISED WORK)	ISSUE (PROGRESS, ESTIMATE, BID, CONSTRUCTION, CONFORMED, REVISION, RECORD)	REVISION NUMBER	DRAWN BY	CHECKED BY	APPR'D BY	DATE	REMARKS
	ASBUILT REVISION F 12/5/2007	F	AD	LDD	MCD	12/05/07	AS-BUILT RECORD DRAWING
		E	MRC	AD	MCG	10/12/04	PHASE III FIRE ALARM SYSTEM UP-GRADE

71
FIRE ALARM SYSTEM
LOGIC DIAGRAM, LOOP NO. 3

UNIVERSITY OF CALIFORNIA
LAWRENCE BERKELEY NATIONAL LABORATORY
FACILITIES DIVISION

DRAWN BY	RG	DATE	8/1/1984
CHECKED BY			
APPROVED BY	BHS		8/1/1984
CAD FILE PATH	00022541		
SCALE	As Noted		
DRAWING NO.	4B71E052F	SHEET	1 OF 1
PROJECT NO.	FB4010		