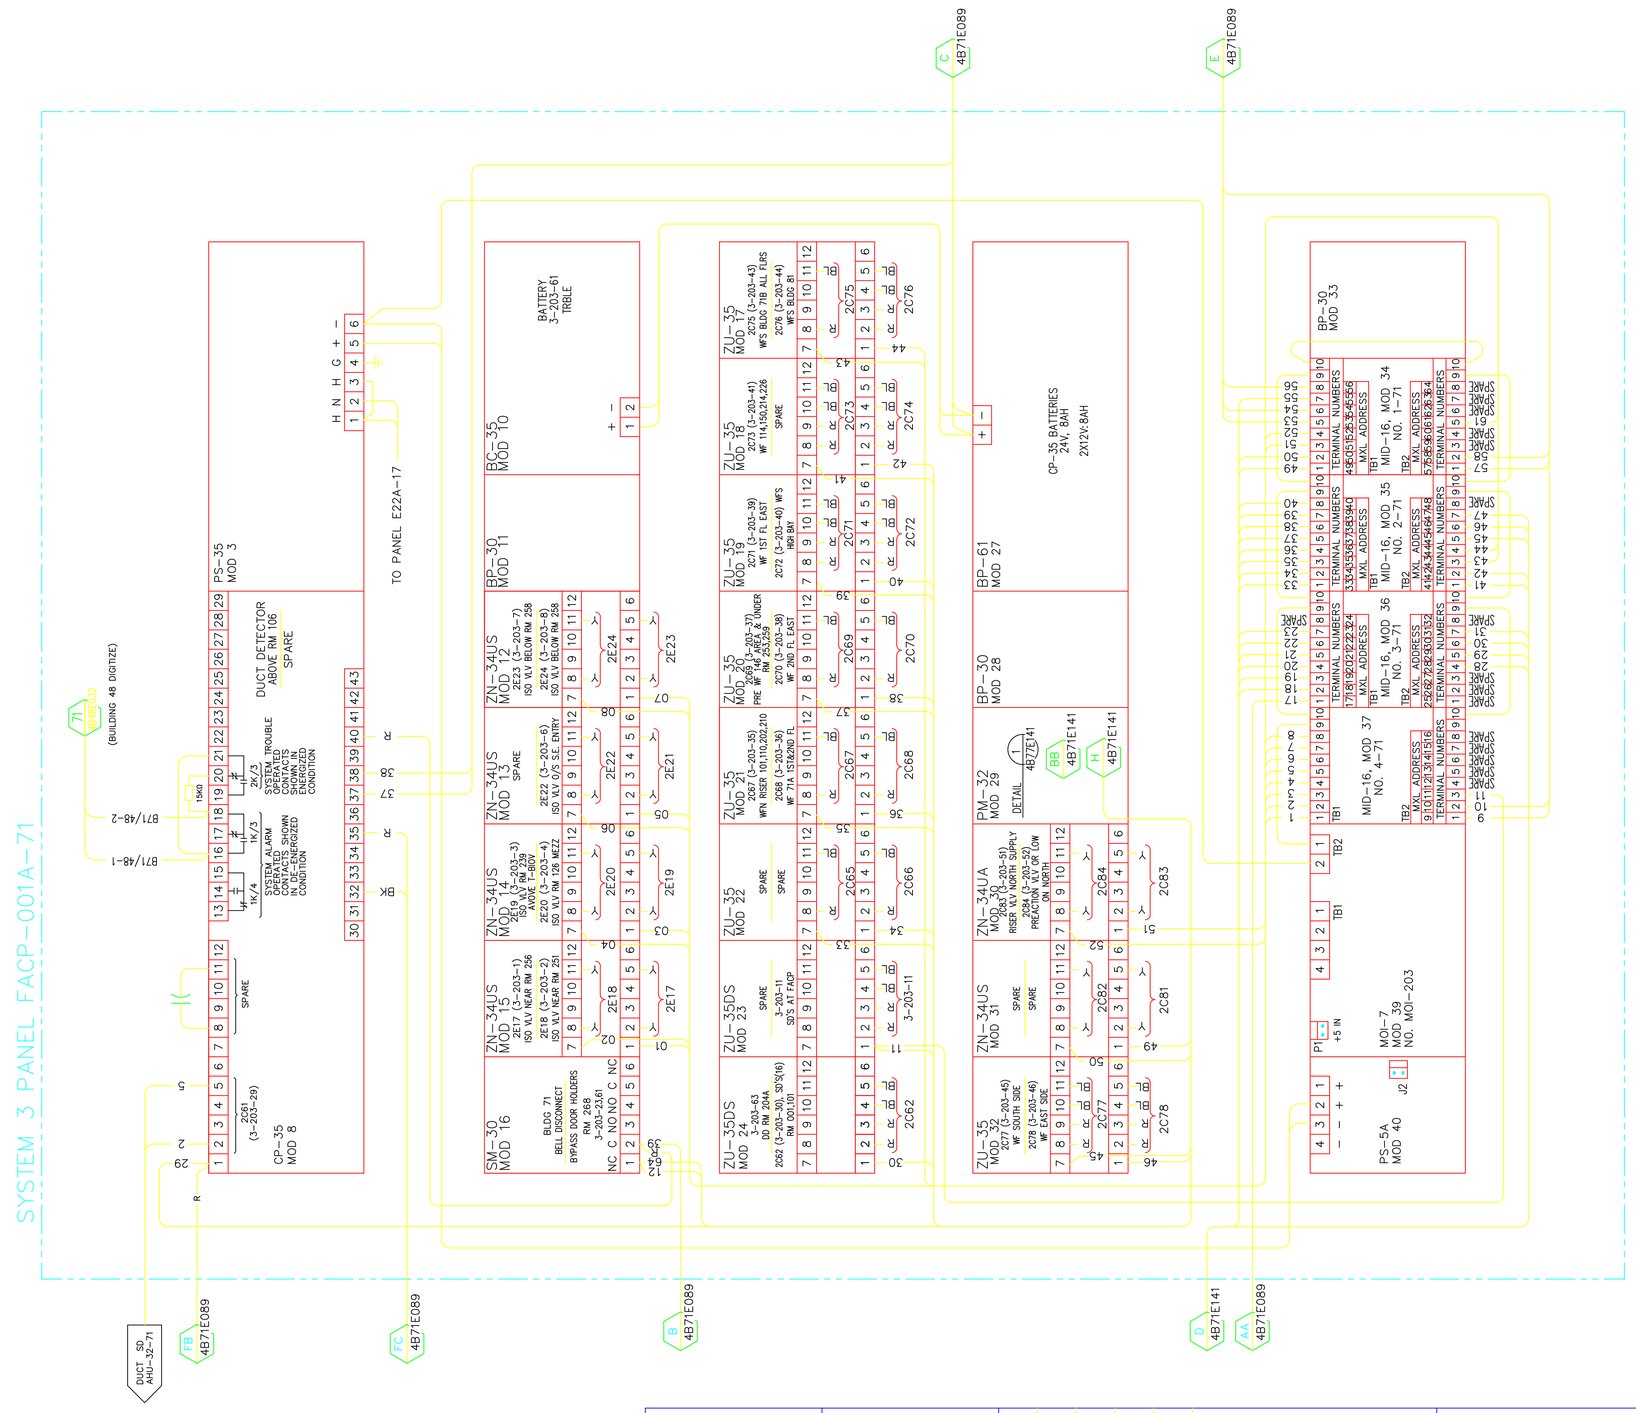

AS BUILT

C
6/13/13

REVISION NUMBER	DRAWN BY	CHECKED BY	APPR'D BY	DATE	REMARKS
C	DSV	LDD	MCD	6/13/13	AS BUILT PER FIELD VERIFICATION
B	AD	LDD	MCD	12/10/07	AS-BUILT RECORD DRAWING
A	AD	LDD	MCD	4/19/06	REVISED FOR MXL COPPER LOOP

PROFESSIONAL SEAL (IF REVISION, APPLIES ONLY TO REVISED WORK)

ISSUE (PROGRESS, ESTIMATE, BID, CONSTRUCTION, CONFORMED, REVISION, RECORD)

71 FIRE ALARM SYSTEM
SYSTEM 3 PANEL FAP-001A-71
INTERCONNECTION DIAGRAM

UNIVERSITY OF CALIFORNIA
LAWRENCE BERKELEY NATIONAL LABORATORY
FACILITIES DIVISION

		DATE
DRAWN BY	MRC	9/8/2004
CHECKED BY	AD	9/8/2004
APPROVED BY	MCG	9/8/2004
CAD FILE PATH		
SCALE	Full	
DRAWING NO.	4B71E139C	
PROJECT NO.	FB4010	
SHEET	1 OF 1	