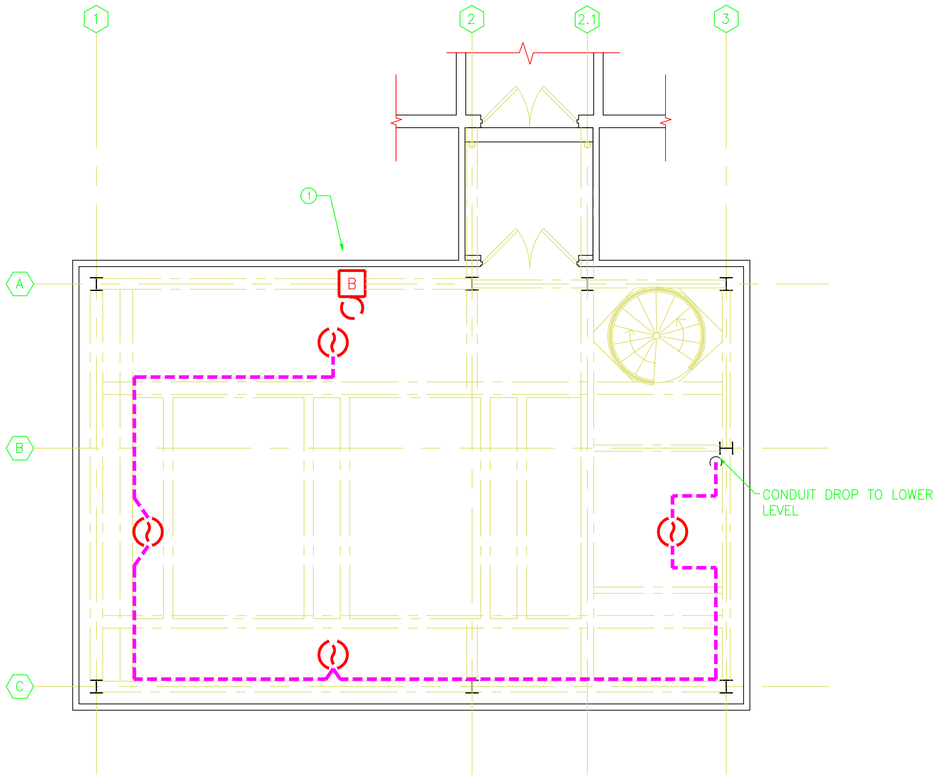

DEMOLITION MAIN FLOOR PLAN 2
1/4" = 1'-0"

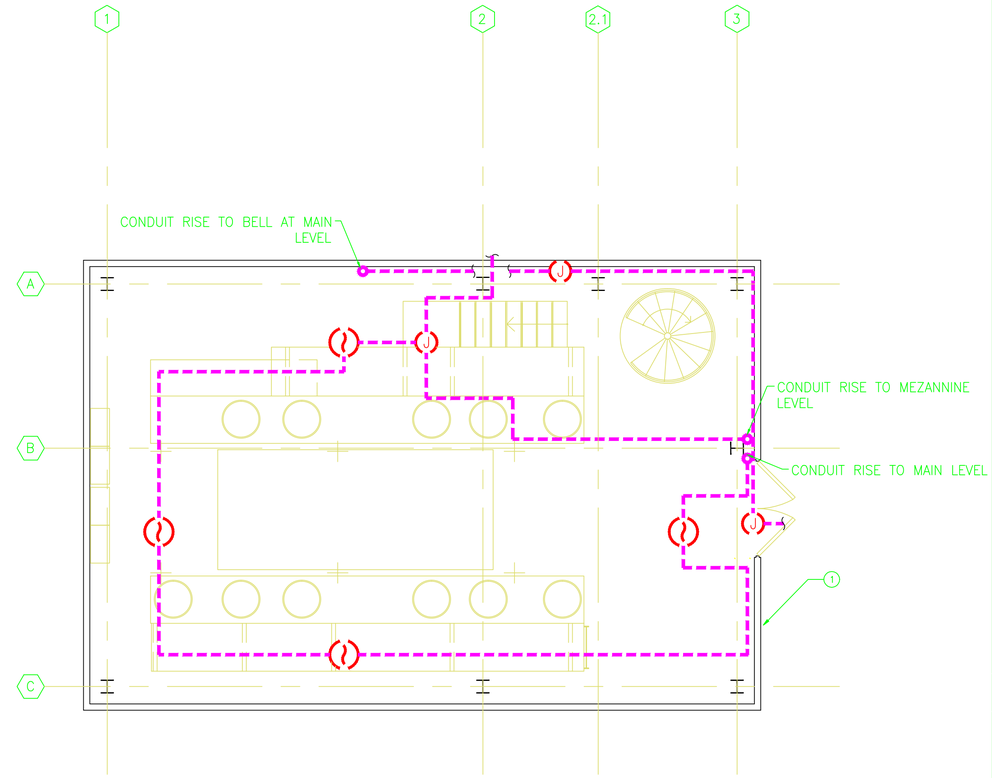

DEMOLITION LOWER FLOOR PLAN 1
1/4" = 1'-0"

LEGEND

- FACP EXISTING FIRE ALARM CONTROL PANEL
- EXISTING SMOKE DETECTOR
- NEW SMOKE DETECTOR
- HSSD NEW HSSD DETECTOR
- PWR NEW POWER SUPPLY
- DISP NEW HSSD ALARM DISPLAY
- WF PRESSURE OPER WATERFLOW SWITCH
- VS VALVE POSITION SUPERVISORY SWITCH
- PS SPRINKLER LOW AIR SUPERVISION
- A EPO ABORT (ENCLOSURE)
- L1 HSSD LEVEL 1 ALARM (ENCLOSURE)
- L2 HSSD LEVEL 2 ALARM (ENCLOSURE)
- B NEW BELL/STROBE
- S NEW STROBE
- B EXISTING BELL
- RACEWAY JUNCTION BOX
- EXISTING FIRE ALARM CONDUIT
- —C— NEW ¾ INCH FIRE ALARM CONDUIT
- HSSD SAMPLE ORIFACE
- —H— HSSD SAMPLE PIPE

KEYNOTES

1. REMOVE EXISTING SMOKE DETECTORS, BELL, BOXES, AND RACEWAY.

KEYPLAN–BLDG 72A FLOOR PLAN

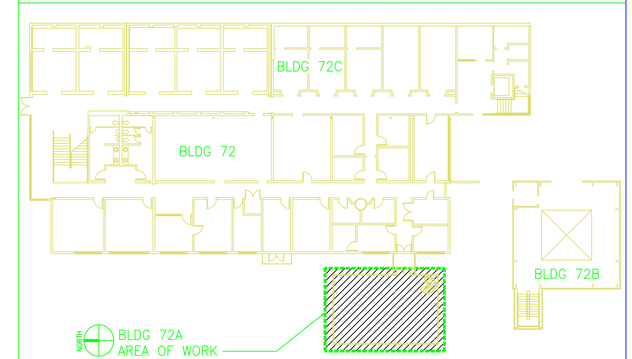

NORTH

4' 2' 0' 4' 8'
GRAPHIC SCALE: 1/4" = 1'-0"

HYT Corporation
Fire Protection Engineers and Consultants
3498 Clayton Road - Suite 101 Concord, California 94519
Phone: (925) 681-2731 FAX: (925) 681-2733
CONSULTING FIRM

TECTONICS
architects • planners • engineers
1500 PARK AVENUE
EMERYVILLE, CA 94608-3551
TEL: (510) 740-2400
CONSULTING A/E FIRM

REGISTERED PROFESSIONAL ENGINEER BRET B. TRESIDDER No. 1165 Exp. 9/30/06 FIRE PROTECTION STATE OF CALIFORNIA
PROFESSIONAL SEAL (IF REVISION, APPLIES ONLY TO REVISED WORK)

RECORD DRAWING
AS-BUILT
28 SEPT 2012
AS PER CONTRACTOR'S MARK-UPS

ISSUED FOR CONSTRUCTION
07/25/06

ISSUE (PROGRESS, ESTIMATE, BID, CONSTRUCTION, CONFORMED, REVISION, AS-BUILT)

REVISION NUMBER	DRAWN BY	CHECKED BY	APPR'D BY	DATE	REMARKS

BUILDING 72A
NCEM RENOVATION – TEAM 0.5
FIRE ALARM DEMOLITION

UNIVERSITY OF CALIFORNIA
LAWRENCE BERKELEY NATIONAL LABORATORY
BERKELEY LAB
FACILITIES DIVISION

DRAWN BY	DWH	DATE	3/20/2006
CHECKED BY	BBT		3/21/2006
APPROVED BY			
CAD FILE PATH	00021172		
SCALE	As Noted		
DRAWING NO.	4B72AE010	SHEET	FA1-1
PROJECT NO.	FM6100	OF	