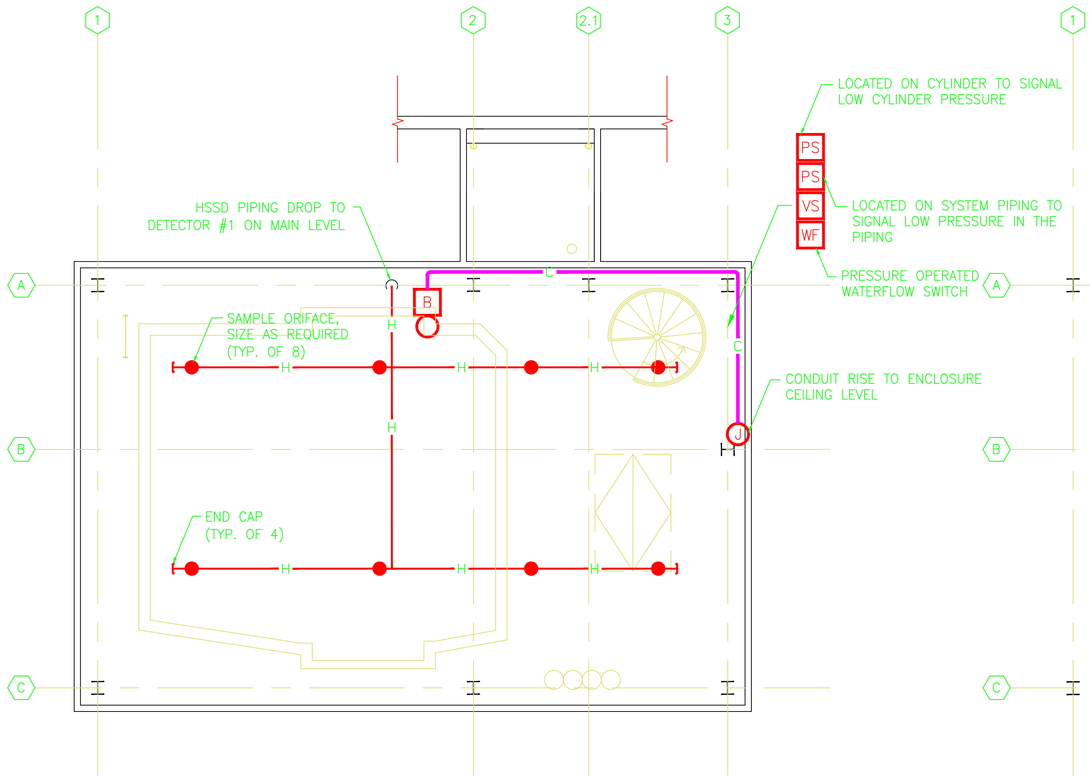

FIRE ALARM FLOOR PLAN – MEZZANINE LEVEL (2)

1/4" = 1'-0"

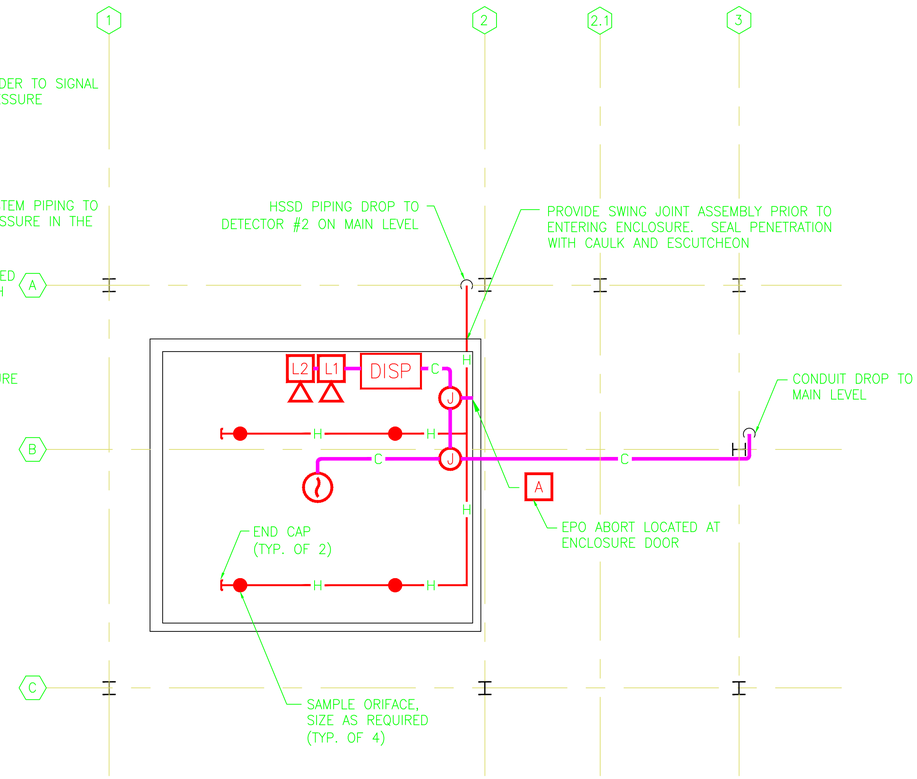

FIRE ALARM FLOOR PLAN – ENCLOSURE (1)

1/4" = 1'-0"

LEGEND

- EXISTING FIRE ALARM CONTROL PANEL
- EXISTING SMOKE DETECTOR
- NEW SMOKE DETECTOR
- NEW HSSD DETECTOR
- NEW POWER SUPPLY
- NEW HSSD ALARM DISPLAY
- PRESSURE OPER WATERFLOW SWITCH
- VALVE POSITION SUPERVISORY SWITCH
- SPRINKLER LOW AIR SUPERVISION
- EPO ABORT (ENCLOSURE)
- HSSD LEVEL 1 ALARM (ENCLOSURE)
- HSSD LEVEL 2 ALARM (ENCLOSURE)
- NEW BELL/STROBE
- NEW STROBE
- EXISTING BELL
- RACEWAY JUNCTION BOX
- EXISTING FIRE ALARM CONDUIT
- NEW ¾ INCH FIRE ALARM CONDUIT
- HSSD SAMPLE ORIFACE
- HSSD SAMPLE PIPE

KEYPLAN–BLDG 72A FLOOR PLAN

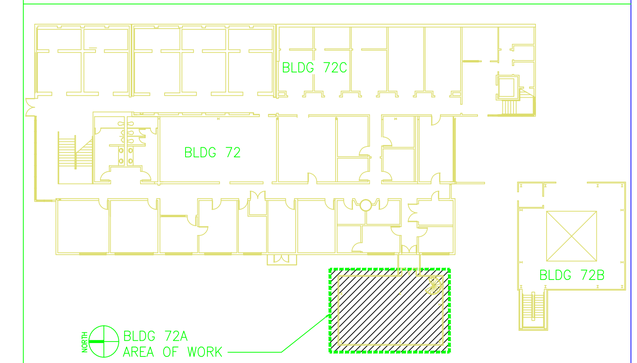

NORTH

4' 2' 0' 4' 8'

GRAPHIC SCALE: 1/4" = 1'-0"

HYT Corporation
Fire Protection Engineers and Consultants
3498 Clayton Road - Suite 101 Concord, California 94519
Phone: (925) 681-2731 FAX: (925) 681-2733

TECTONICS
architects • planners • engineers
1500 PARK AVENUE
EMERYVILLE, CA 94608-3551
TEL: (510) 740-2400

REGISTERED PROFESSIONAL ENGINEER BRET B. TRESSLER No. 1165 Exp. 9/30/06 FIRE PROTECTION STATE OF CALIFORNIA

RECORD DRAWING
AS-BUILT
28 SEPT 2012
AS PER CONTRACTOR'S MARK-UPS

ISSUED FOR CONSTRUCTION
07/25/06

REVISION NUMBER	DRAWN BY	CHECKED BY	APPR'D BY	DATE	REMARKS

CONSULTING FIRM | CONSULTING FIRM | CONSULTING A/E FIRM | PROFESSIONAL SEAL (IF REVISION, APPLIES ONLY TO REVISED WORK) | ISSUE (PROGRESS, ESTIMATE, BID, CONSTRUCTION, CONFORMED, REVISION, AS-BUILT)

BUILDING 72A
NCEM RENOVATION – TEAM 0.5
FIRE ALARM SYSTEMS

UNIVERSITY OF CALIFORNIA
LAWRENCE BERKELEY NATIONAL LABORATORY
BERKELEY LAB
FACILITIES DIVISION

DRAWN BY DWH	DATE 3/20/2006	
CHECKED BY BBT	3/21/2006	
APPROVED BY		
CAD FILE PATH 00021177		
SCALE As Noted		
DRAWING NO. 4B72AE013	SHEET FA2-2	OF
PROJECT NO. FM6100		