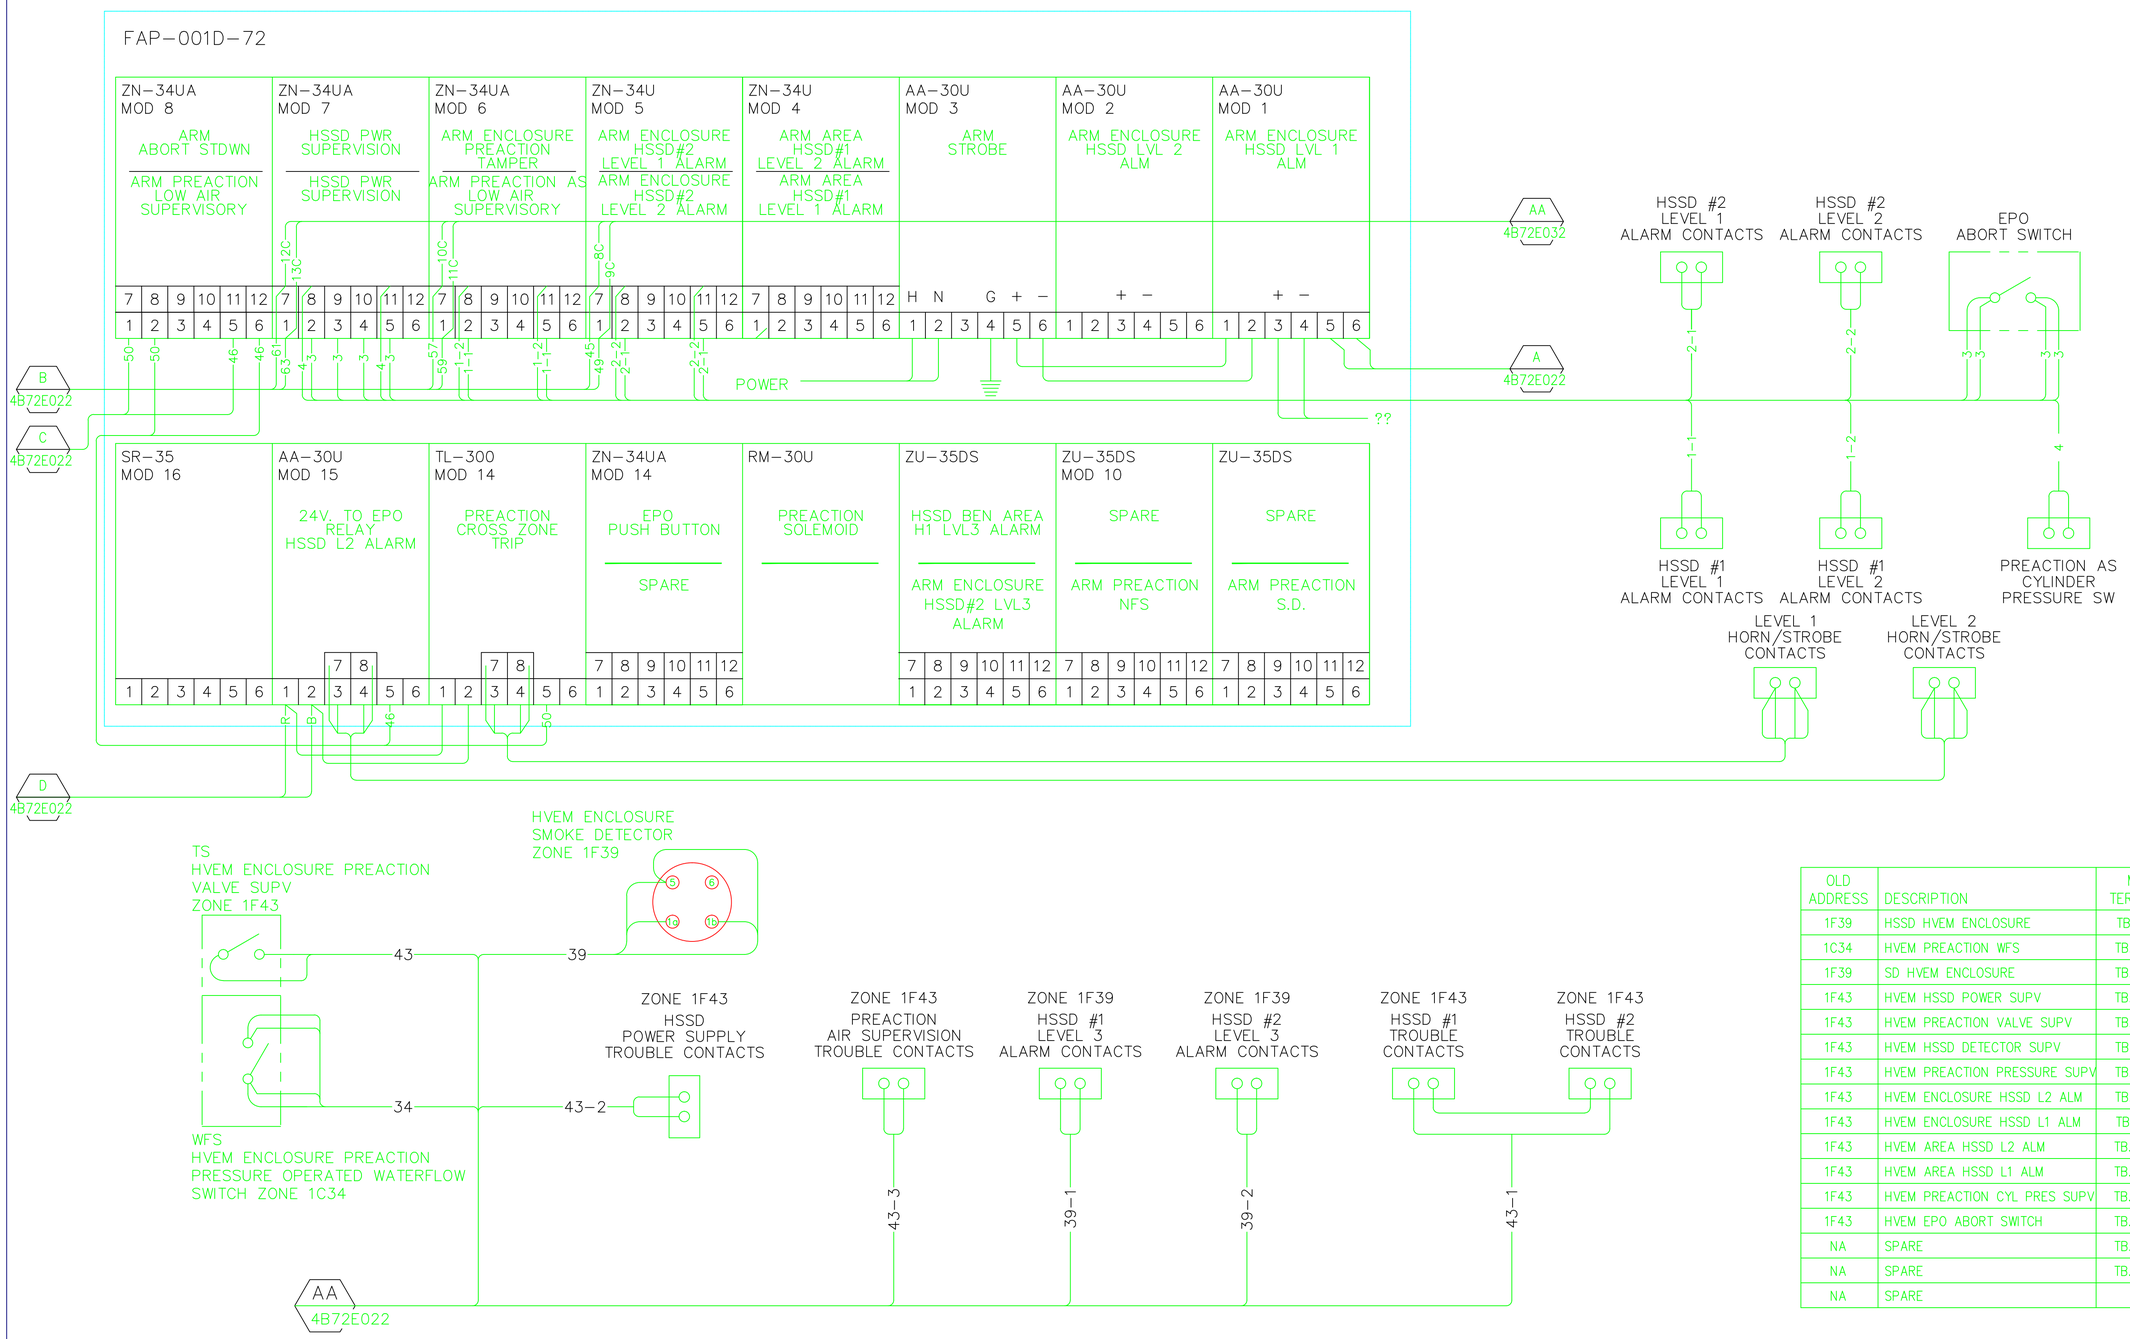

OLD ADDRESS	DESCRIPTION	MID-16 TERMINATION	MODULE TYPE & NO.	MXL NO. 6@B84 ADDRESS
1F39	HSSD HVEM ENCLOSURE	TB. 1 NO. 1	MID-16 NO. 3-72	6-205-32
1C34	HVEM PREACTION WFS	TB. 1 NO. 2	MID-16 NO. 3-72	6-205-33
1F39	SD HVEM ENCLOSURE	TB. 1 NO. 3	MID-16 NO. 3-72	6-205-34
1F43	HVEM HSSD POWER SUPV	TB. 1 NO. 4	MID-16 NO. 3-72	6-205-35
1F43	HVEM PREACTION VALVE SUPV	TB. 1 NO. 5	MID-16 NO. 3-72	6-205-36
1F43	HVEM HSSD DETECTOR SUPV	TB. 1 NO. 6	MID-16 NO. 3-72	6-205-37
1F43	HVEM PREACTION PRESSURE SUPV	TB. 1 NO. 7	MID-16 NO. 3-72	6-205-38
1F43	HVEM ENCLOSURE HSSD L2 ALM	TB. 1 NO. 8	MID-16 NO. 3-72	6-205-39
1F43	HVEM ENCLOSURE HSSD L1 ALM	TB. 2 NO. 1	MID-16 NO. 3-72	6-205-40
1F43	HVEM AREA HSSD L2 ALM	TB. 2 NO. 2	MID-16 NO. 3-72	6-205-41
1F43	HVEM AREA HSSD L1 ALM	TB. 2 NO. 3	MID-16 NO. 3-72	6-205-42
1F43	HVEM PREACTION CYL PRES SUPV	TB. 2 NO. 4	MID-16 NO. 3-72	6-205-43
1F43	HVEM EPO ABORT SWITCH	TB. 2 NO. 5	MID-16 NO. 3-72	6-205-44
NA	SPARE	TB. 2 NO. 6	MID-16 NO. 3-72	6-205-45
NA	SPARE	TB. 2 NO. 7	MID-16 NO. 3-72	6-205-46
NA	SPARE	N/A	N/A	N/A

AS BUILT

A
6/13/13

ISSUE (PROGRESS, ESTIMATE, BID, CONSTRUCTION, CONFORMED, REVISION, RECORD)

PROFESSIONAL SEAL (IF REVISION, APPLIES ONLY TO REVISED WORK)

REVISION NUMBER	DRAWN BY	CHECKED BY	APPR'D BY	DATE	REMARKS
A	DSV	LDD	MCD	6/13/13	AS BUILT PER FIELD VERIFICATION

72 COMPLEX FIRE ALARM
SYSTEM 3 WIRING

UNIVERSITY OF CALIFORNIA
LAWRENCE BERKELEY NATIONAL LABORATORY
FACILITIES DIVISION

DRAWN BY HYT	DATE 4/3/06	
CHECKED BY HYT	4/3/06	
APPROVED BY AS BUILT		
CAD FILE PATH		
SCALE As Noted		
DRAWING NO. 4B72AE015A		SHEET FA0.8
PROJECT NO. FM6100		1 OF 1