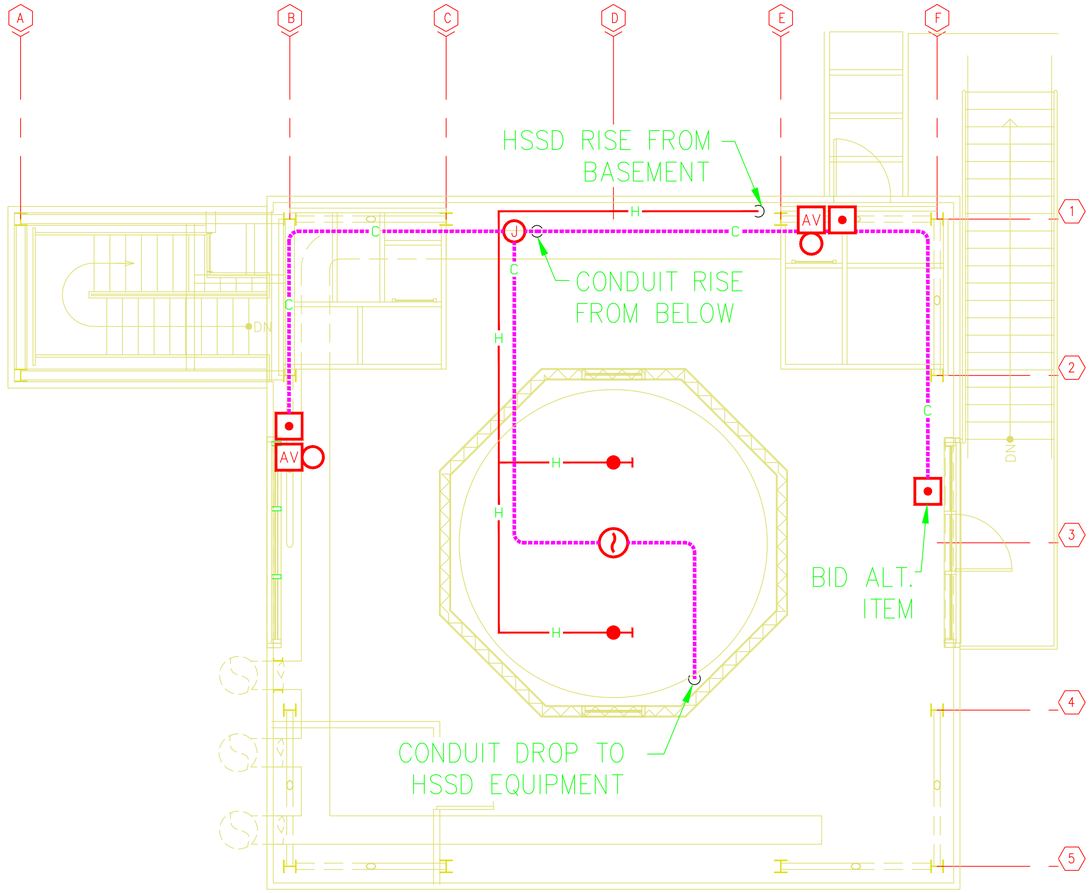

ENCLOSURE PLAN
1/4" = 1'-0"
2 – FA2.1

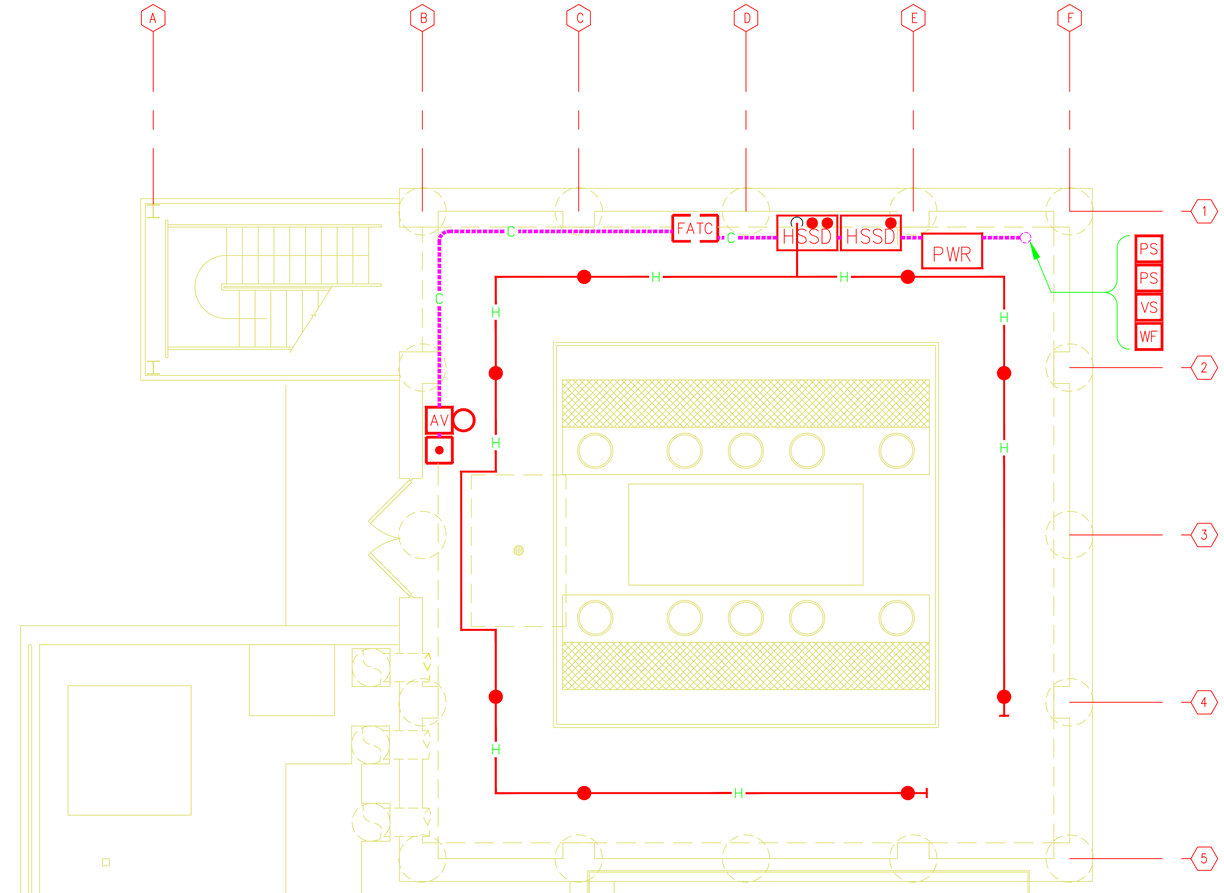

BASEMENT FLOOR LEVEL PLAN
1/4" = 1'-0"
1 – FA2.1

LEGEND

FACP EXISTING FIRE ALARM CONTROL PANEL	DISP NEW HSSD ALARM DISPLAY	L1 HSSD LEVEL 1 ALARM (ENCLOSURE)	RACEWAY JUNCTION BOX
EXISTING SMOKE DETECTOR	WF PRESSURE OPER WATERFLOW SWITCH	L2 HSSD LEVEL 2 ALARM (ENCLOSURE)	EXISTING FIRE ALARM CONDUIT
NEW SMOKE DETECTOR	VS VALVE POSITION SUPERVISORY SWITCH	B NEW BELL/STROBE	—C— NEW ¾ INCH FIRE ALARM CONDUIT
HSSD NEW HSSD DETECTOR	PS SPRINKLER LOW AIR SUPERVISION	S NEW STROBE	HSSD SAMPLE ORIFACE
PWR NEW POWER SUPPLY	A EPO ABORT (ENCLOSURE)	B EXISTING BELL	—H— HSSD SAMPLE PIPE

4' 2' 0' 4' 8'
GRAPHIC SCALE: 1/4" = 1'-0"

PLAN NORTH
MAG NORTH

HYT Corporation
Fire Protection Engineers and Consultants
3498 Clayton Road - Suite 101 Concord, California 94519
Phone: (925) 681-2731 FAX: (925) 681-2733

TECTONICS
architects • planners • engineers
1500 PARK AVENUE
EMERYVILLE, CA 94608-3551
TEL: (510) 740-2400

REGISTERED PROFESSIONAL ENGINEER
BRET B. TRESSIDER
No. 1165
Exp. 9/30/08
FIRE PROTECTION
STATE OF CALIFORNIA

RECORD DRAWING
AS-BUILT
28 SEPT 2012
AS PER CONTRACTOR'S MARK-UPS

ISSUED FOR CONSTRUCTION
05/27/2008

REVISION NUMBER	DRAWN BY	CHECKED BY	APPR'D BY	DATE	REMARKS
1	DWH	BBT	--	04/11/08	ENCLOSURE SIZE CHANGE

BUILDING 72B (ARM BUILDING)
RENOVATION – TEAM 1.0
FIRE ALARM SYSTEMS – MODIFICATIONS

UNIVERSITY OF CALIFORNIA
LAWRENCE BERKELEY NATIONAL LABORATORY
BERKELEY LAB FACILITIES DIVISION

DRAWN BY DWH	DATE 8/21/2007		
CHECKED BY BBT	8/21/2007		
APPROVED BY			
CAD FILE PATH 00022611			
SCALE As Noted			
DRAWING NO. 4B72BE016		SHEET FA2.1	OF
PROJECT NO. FM7200			

CONSULTING FIRM | CONSULTING FIRM | CONSULTING A/E FIRM | PROFESSIONAL SEAL (IF REVISION, APPLIES ONLY TO REVISED WORK) | ISSUE (PROGRESS, ESTIMATE, BID, CONSTRUCTION, CONFORMED, REVISION, AS-BUILT)