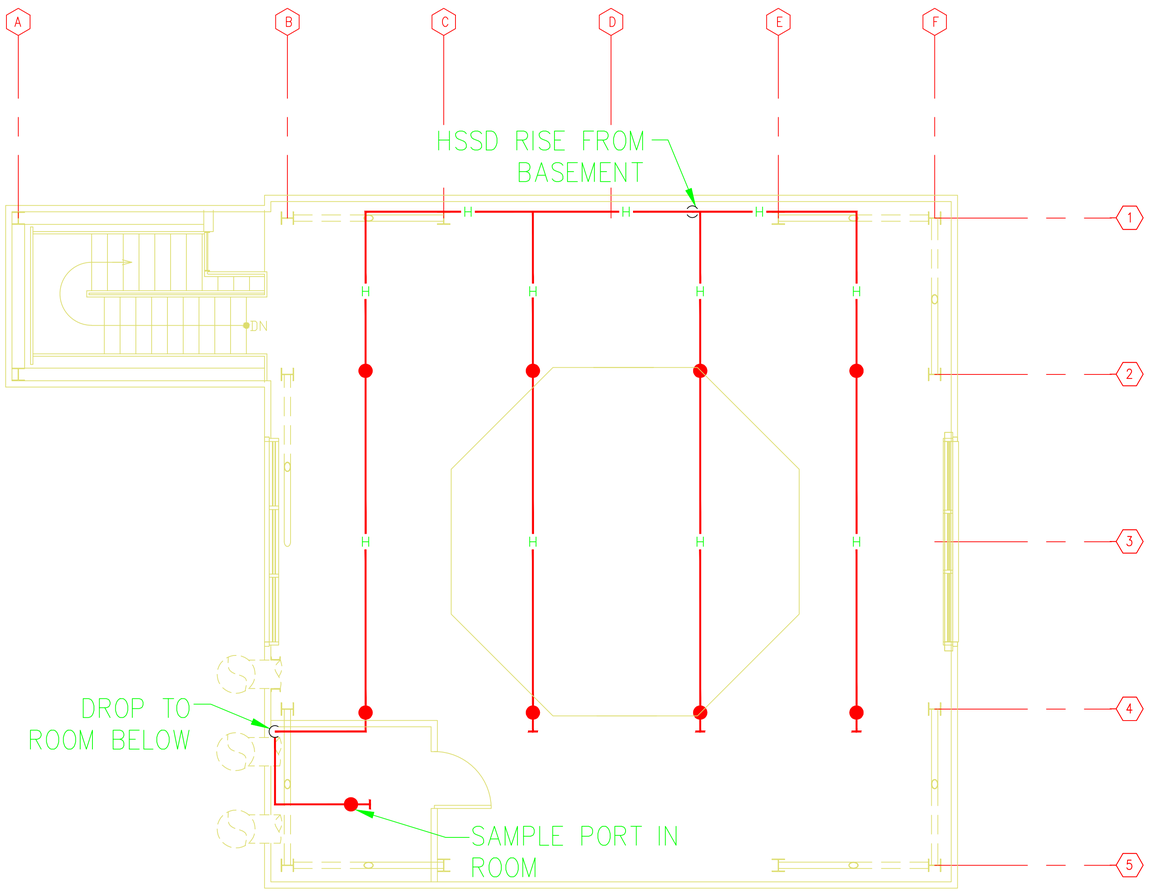

SECOND LEVEL PLAN
1/4" = 1'-0"
2 – FA2.2

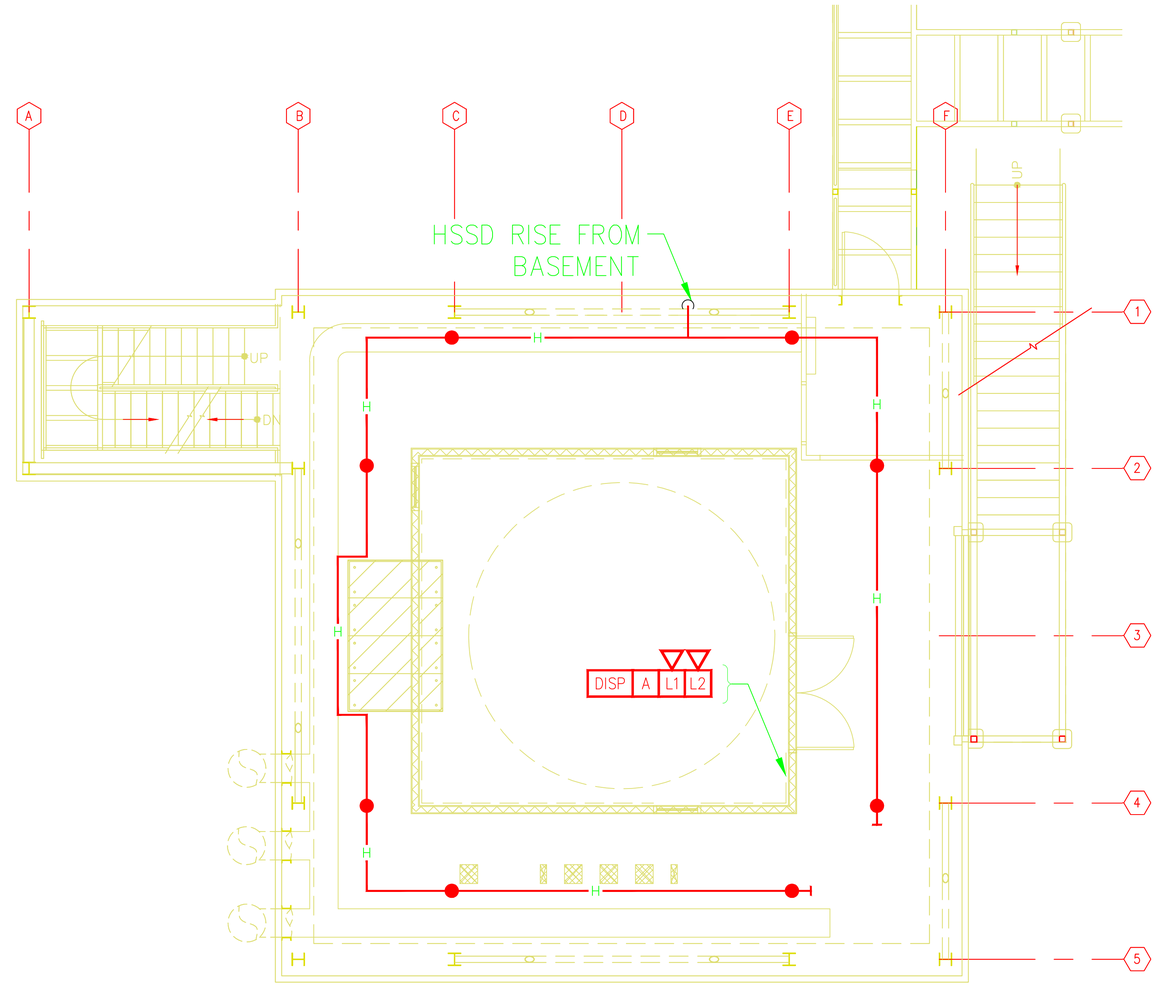

GROUND LEVEL PLAN
1/4" = 1'-0"
1 – FA2.2

LEGEND

- FACP — EXISTING FIRE ALARM CONTROL PANEL
- EXISTING SMOKE DETECTOR
- NEW SMOKE DETECTOR
- HSSD — NEW HSSD DETECTOR
- PWR — NEW POWER SUPPLY
- DISP — NEW HSSD ALARM DISPLAY
- WF — PRESSURE OPER WATERFLOW SWITCH
- VS — VALVE POSITION SUPERVISORY SWITCH
- PS — SPRINKLER LOW AIR SUPERVISION
- A — EPO ABORT (ENCLOSURE)
- L1 — HSSD LEVEL 1 ALARM (ENCLOSURE)
- L2 — HSSD LEVEL 2 ALARM (ENCLOSURE)
- B — NEW BELL/STROBE
- S — NEW STROBE
- B — EXISTING BELL
- RACEWAY JUNCTION BOX
- EXISTING FIRE ALARM CONDUIT
- —C— NEW ¾ INCH FIRE ALARM CONDUIT
- HSSD SAMPLE ORIFACE
- —H— HSSD SAMPLE PIPE

4' 2' 0' 4' 8'
GRAPHIC SCALE: 1/4" = 1'-0"

PLAN NORTH
MAG NORTH

HYT Corporation
Fire Protection Engineers and Consultants
3498 Clayton Road - Suite 101 Concord, California 94519
Phone: (925) 681-2731 FAX: (925) 681-2733
CONSULTING FIRM

TECTONICS
architects • planners • engineers
1500 PARK AVENUE
EMERYVILLE, CA 94608-3551
TEL: (510) 740-2400
CONSULTING FIRM

CONSULTING A/E FIRM

REGISTERED PROFESSIONAL ENGINEER
BRET B. TRESIDDER
No. 1165
Exp. 9/30/08
FIRE PROTECTION
STATE OF CALIFORNIA
PROFESSIONAL SEAL (IF REVISION, APPLIES ONLY TO REVISED WORK)

RECORD DRAWING
AS-BUILT
28 SEPT 2012
AS PER CONTRACTOR'S MARK-UPS

ISSUED FOR CONSTRUCTION
05/27/2008
ISSUE (PROGRESS, ESTIMATE, BID, CONSTRUCTION, CONFORMED, REVISION, AS-BUILT)

REVISION NUMBER	DRAWN BY	CHECKED BY	APPR'D BY	DATE	REMARKS
1	DWH	BBT	--	04/11/08	ENCLOSURE SIZE CHANGE

BUILDING 72B (ARM BUILDING)
RENOVATION – TEAM 1.0
FIRE ALARM SYSTEMS – MODIFICATIONS

UNIVERSITY OF CALIFORNIA
LAWRENCE BERKELEY NATIONAL LABORATORY
BERKELEY LAB
FACILITIES DIVISION

DRAWN BY	DWH	DATE	8/21/2007
CHECKED BY	BBT		8/21/2007
APPROVED BY			
CAD FILE PATH	00022629		
SCALE	As Noted		
DRAWING NO.	4B72BE017	SHEET	FA2.2
PROJECT NO.	FM7200	OF	