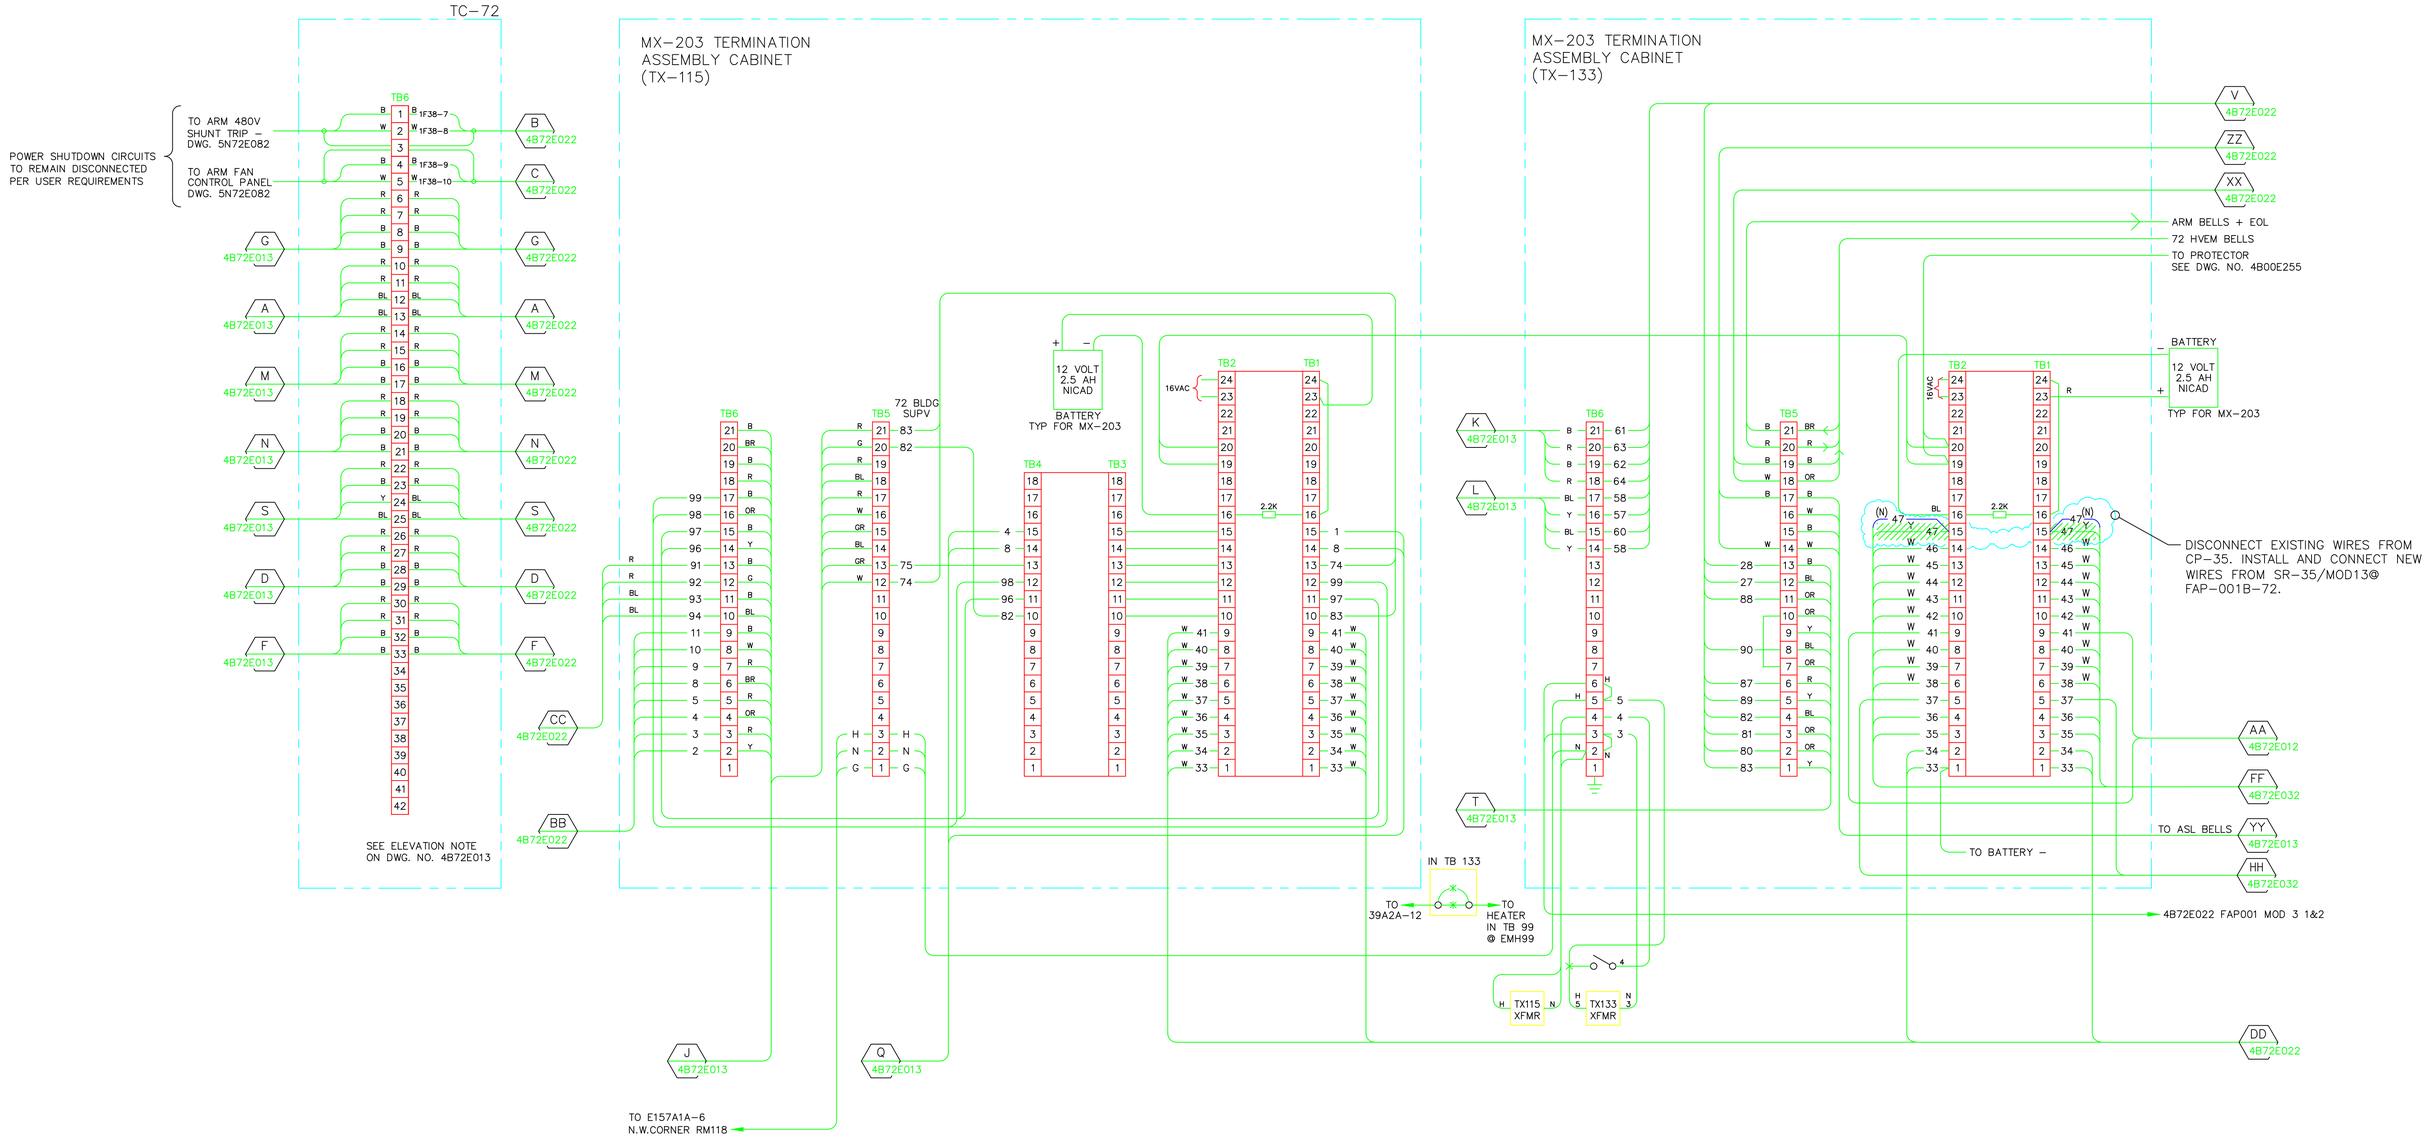

DISTRIBUTION LIST

2-ELECTRIC SHOP B76 (FILE I & II)
1-B90J (FILE III)
1-STICK FILE B90J

REFERENCE DRAWINGS

4B72E013 FIRE ALARM SYSTEM ELEVATION & MISC. WIRING
4B72E017 FIRE ALARM SYSTEM LOGIC
4B72E022 FIRE ALARM SYSTEM-SYSTEM 3 WIRING PANEL FAP-001, 001A, 001B-072
4B72E032 FIRE ALARM SYSTEM-SYSTEM 3 WIRING PANEL FAP-001C-072

ASBUILT REVISION G 3/30/2005

REVISION NUMBER	DRAWN BY	CHECKED BY	APPR'D BY	DATE	REMARKS
G	RZT	MCG	MCG	3/28/05	MODIFIED TROUBLE ZONE FOR DIGITIZE SYSTEM.
F	AD	AD	MCG	02/10/04	AS-BUILT, PHASE II FA UPGRADE
E	LDD	MCG	MCG	5/23/02	
D	FWD	MCG	MCG	10/28/97	
C					
B	RG	RMG		4/90	
A	LSR				ADDED SR-33

PROFESSIONAL SEAL (IF REVISION, APPLIES ONLY TO REVISED WORK)
ISSUE (PROGRESS, ESTIMATE, BID, CONSTRUCTION, CONFORMED, REVISION, RECORD)

72 COMPLEX
FIRE ALARM SYSTEM
INTERCONNECTION DIAGRAM

UNIVERSITY OF CALIFORNIA
LAWRENCE BERKELEY NATIONAL LABORATORY
FACILITIES DIVISION

DRAWN BY FWD	DATE 9/4/1997	
CHECKED BY MCG	11/6/1997	
APPROVED BY MCG	11/6/1997	
CAD FILE PATH 00019148		
SCALE As Noted		
DRAWING NO. 4B72E012G	SHEET 1 OF 1	
PROJECT NO. 120102		