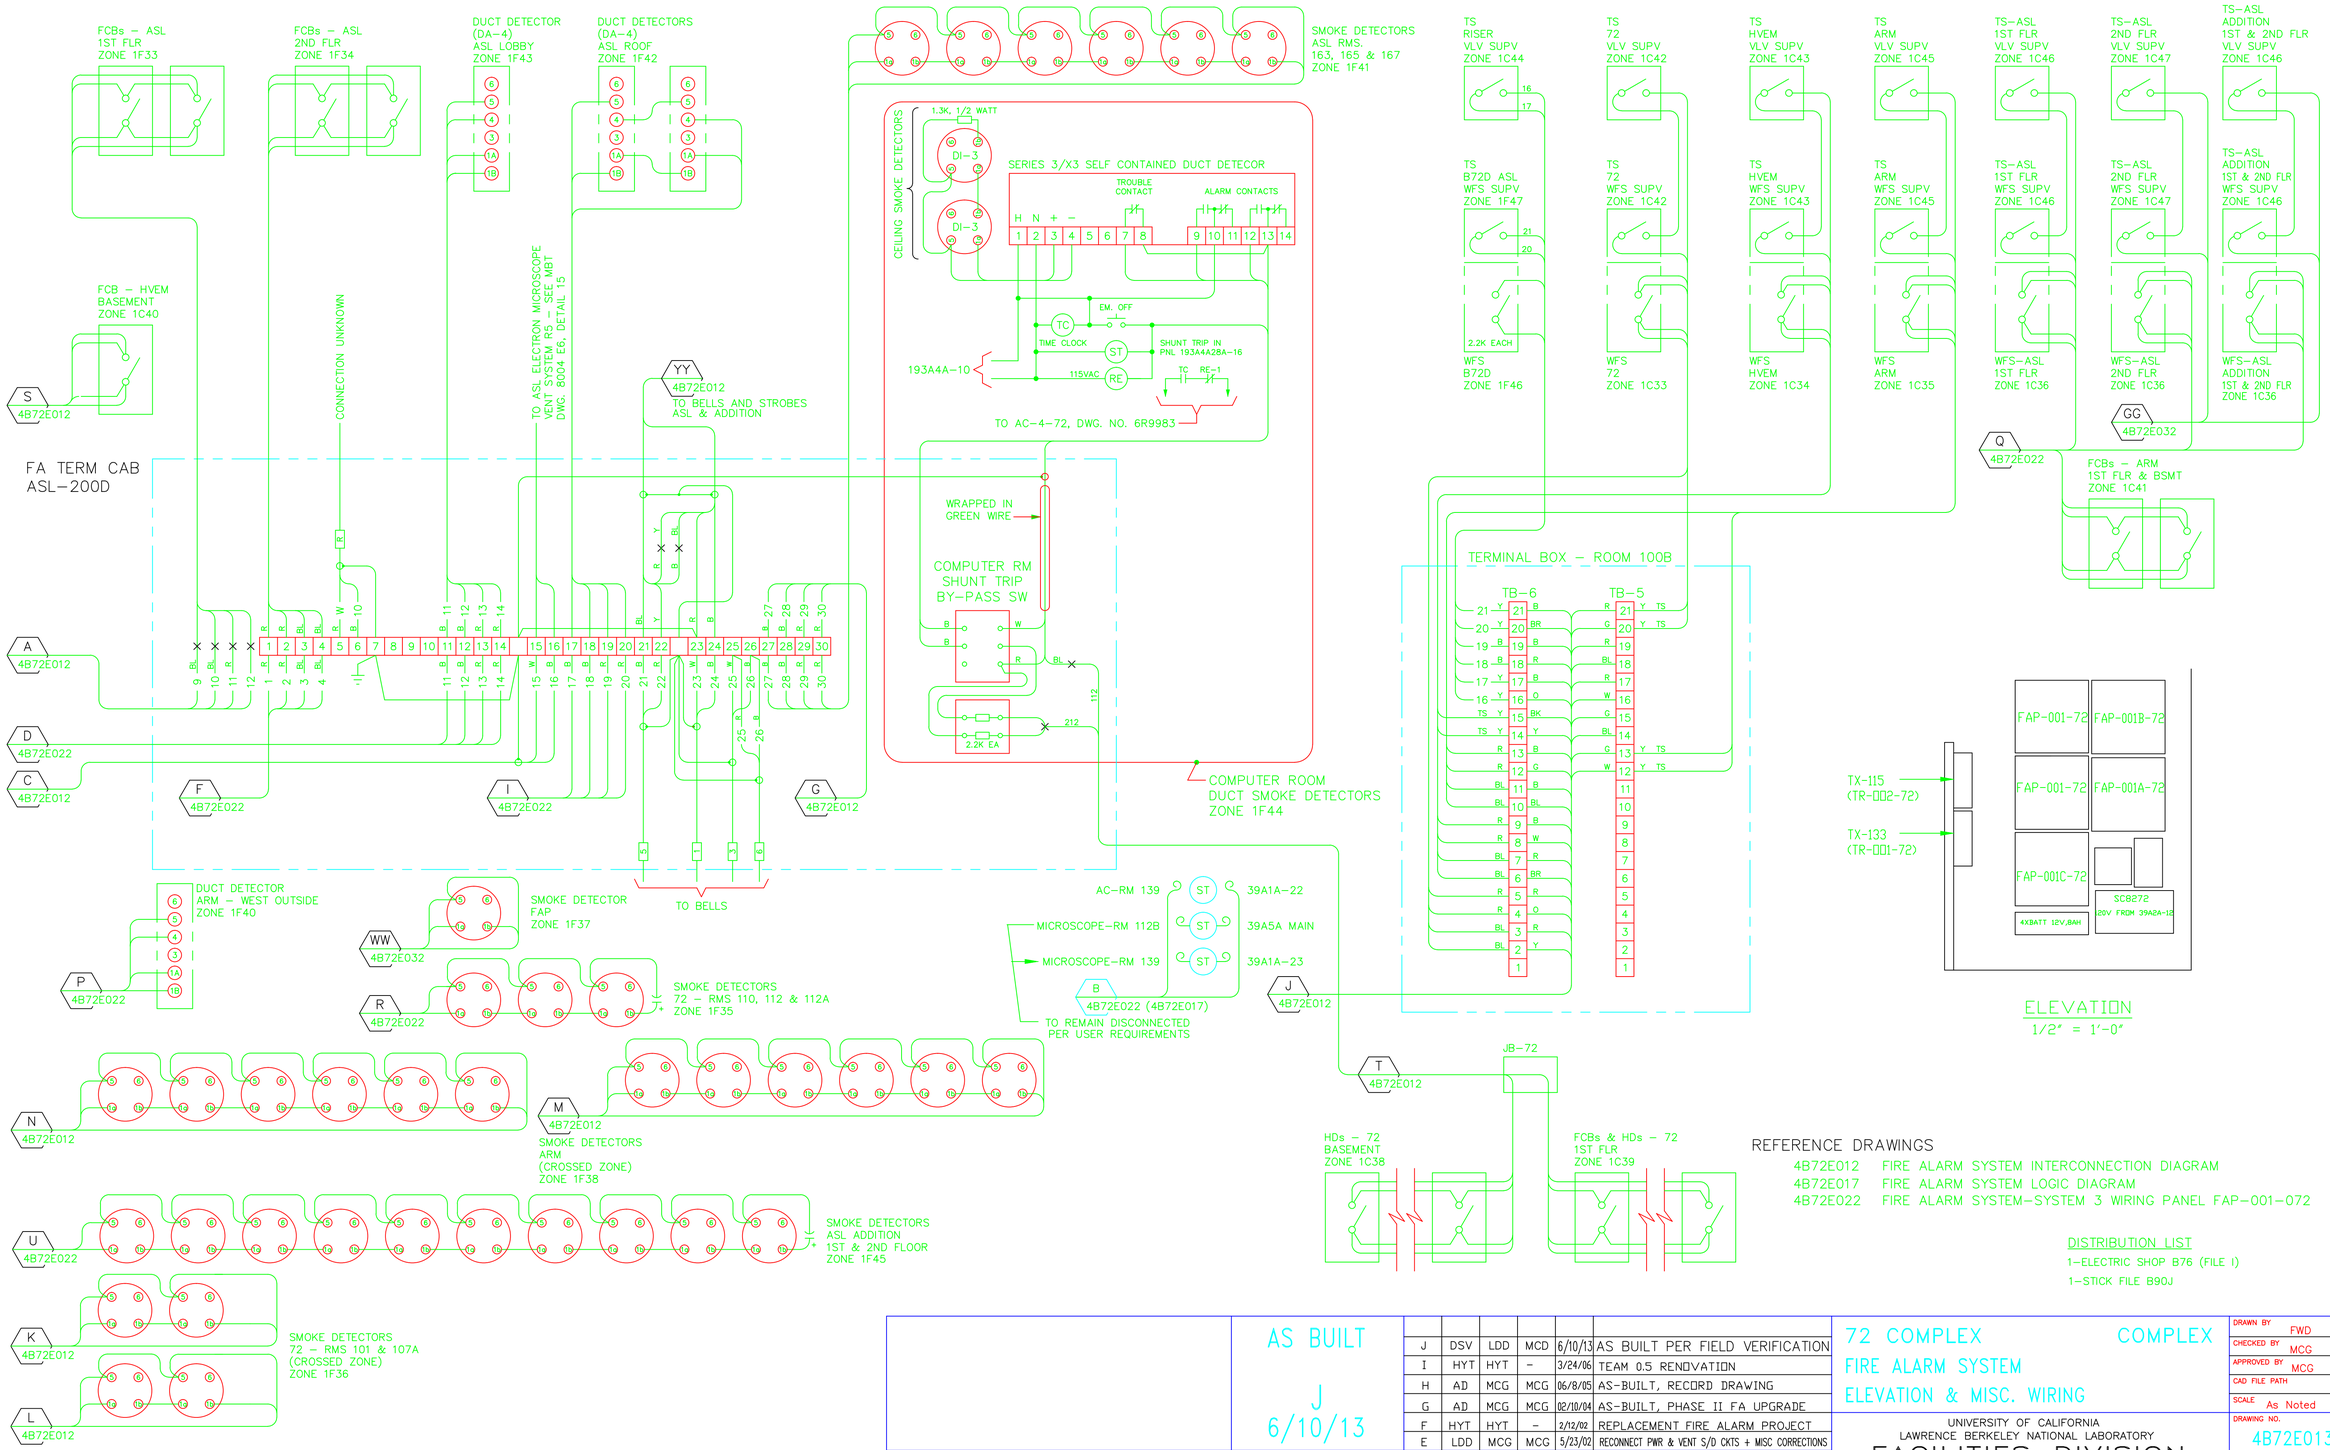


## REFERENCE DRAWINGS

4B72E012 FIRE ALARM SYSTEM INTERCONNECTION DIAGRAM
4B72E017 FIRE ALARM SYSTEM LOGIC DIAGRAM
4B72E022 FIRE ALARM SYSTEM–SYSTEM 3 WIRING PANEL FAP–001–072

## DISTRIBUTION LIST

1–ELECTRIC SHOP B76 (FILE I)
1–STICK FILE B90J

AS BUILT
J
6/10/13

| REVISION NUMBER | DRAWN BY | CHECKED BY | APPR'D BY | DATE | REMARKS |
|---|---|---|---|---|---|
| J | DSV | LDD | MCD | 6/10/13 | AS BUILT PER FIELD VERIFICATION |
| I | HYT | HYT | – | 3/24/06 | TEAM 0.5 RENOVATION |
| H | AD | MCG | MCG | 06/8/05 | AS-BUILT, RECORD DRAWING |
| G | AD | MCG | MCG | 02/10/04 | AS-BUILT, PHASE II FA UPGRADE |
| F | HYT | HYT | – | 2/12/02 | REPLACEMENT FIRE ALARM PROJECT |
| E | LDD | MCG | MCG | 5/23/02 | RECONNECT PWR & VENT S/D CKTS + MISC CORRECTIONS |

PROFESSIONAL SEAL (IF REVISION, APPLIES ONLY TO REVISED WORK)
ISSUE (PROGRESS, ESTIMATE, BID, CONSTRUCTION, CONFORMED, REVISION, RECORD)

72 COMPLEX — COMPLEX
FIRE ALARM SYSTEM
ELEVATION & MISC. WIRING

UNIVERSITY OF CALIFORNIA
LAWRENCE BERKELEY NATIONAL LABORATORY
FACILITIES DIVISION

| | | | |
|---|---|---|---|
| DRAWN BY | FWD | DATE | 9/4/1997 |
| CHECKED BY | MCG | | 11/6/1997 |
| APPROVED BY | MCG | | 11/6/1997 |
| CAD FILE PATH | | | |
| SCALE | As Noted | | |
| DRAWING NO. | 4B72E013J | SHEET | FA0.4 |
| PROJECT NO. | FM6100 | | 1 OF 1 |