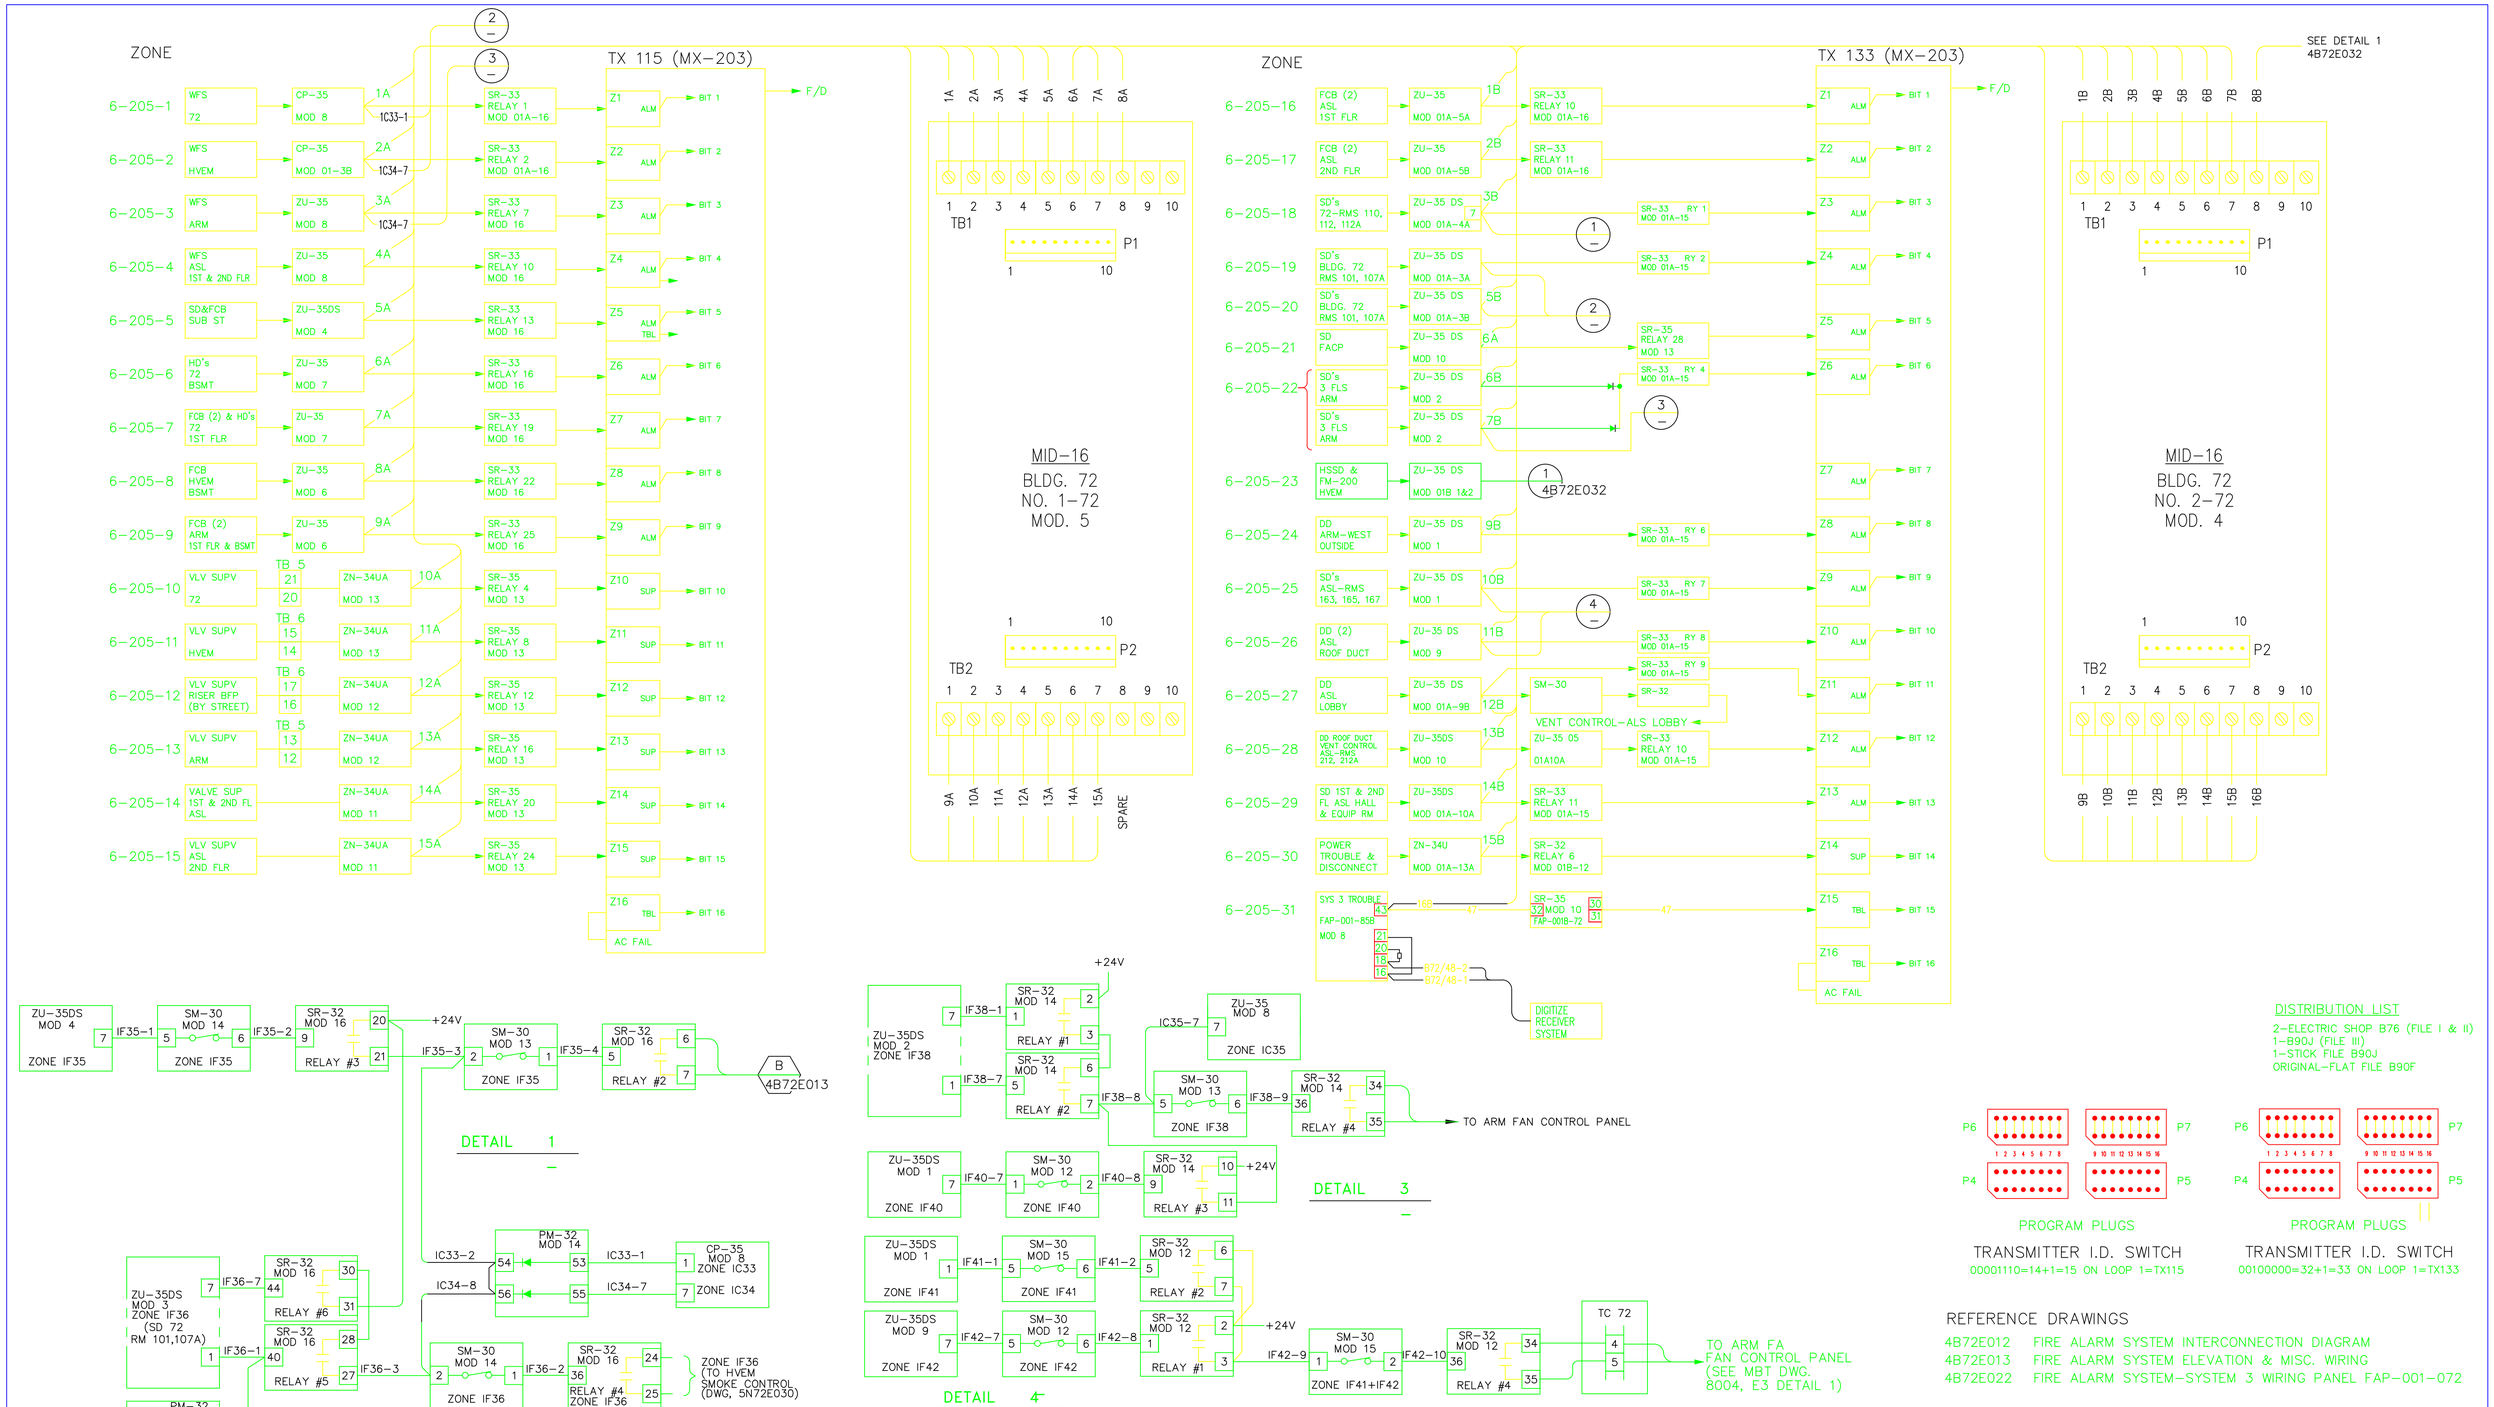


AS BUILT

L

6/10/13

| REVISION NUMBER | DRAWN BY | CHECKED BY | APPR'D BY | DATE | REMARKS |
|---|---|---|---|---|---|
| L | DSV | LDD | MCD | 6/10/13 | AS BUILT PER FIELD VERIFICATION |
| K | HYT | HYT | – | 3/24/06 | TEAM 0.5 RENOVATION |
| J | RZT | MCG | MCG | 3/29/05 | MODIFIED FOR DIGITIZE SYSTEM. |
| I | MRC | AD | MCG | 02/10/03 | AS-BUILT, PHASE II FA UPDATE |
| H | MRC | MCG | MCG | 10/27/03 | AS-BUILT, PHASE II FA UPGRADE |
| G | HYT | HYT | – | 2/12/02 | REPLACEMENT FIRE ALARM PROJECT |
| F | LDD | MCG | MCG | 5/23/02 | REPLCMNT FA PROJ + RECONNECT PWR & VENT S/D CKTS |

PROFESSIONAL SEAL (IF REVISION, APPLIES ONLY TO REVISED WORK)

ISSUE (PROGRESS, ESTIMATE, BID, CONSTRUCTION, CONFORMED, REVISION, RECORD)

# 72 COMPLEX
# FIRE ALARM SYSTEM
# LOGIC DIAGRAM

UNIVERSITY OF CALIFORNIA
LAWRENCE BERKELEY NATIONAL LABORATORY
FACILITIES DIVISION

| | | |
|---|---|---|
| DRAWN BY | FWD | DATE 9/4/1997 |
| CHECKED BY | MCG | 11/6/1997 |
| APPROVED BY | MCG | 11/6/1997 |
| CAD FILE PATH | | |
| SCALE | As Noted | |
| DRAWING NO. | 4B72E017L | SHEET FA0.5 |
| PROJECT NO. | FM6100 | 1 OF 1 |