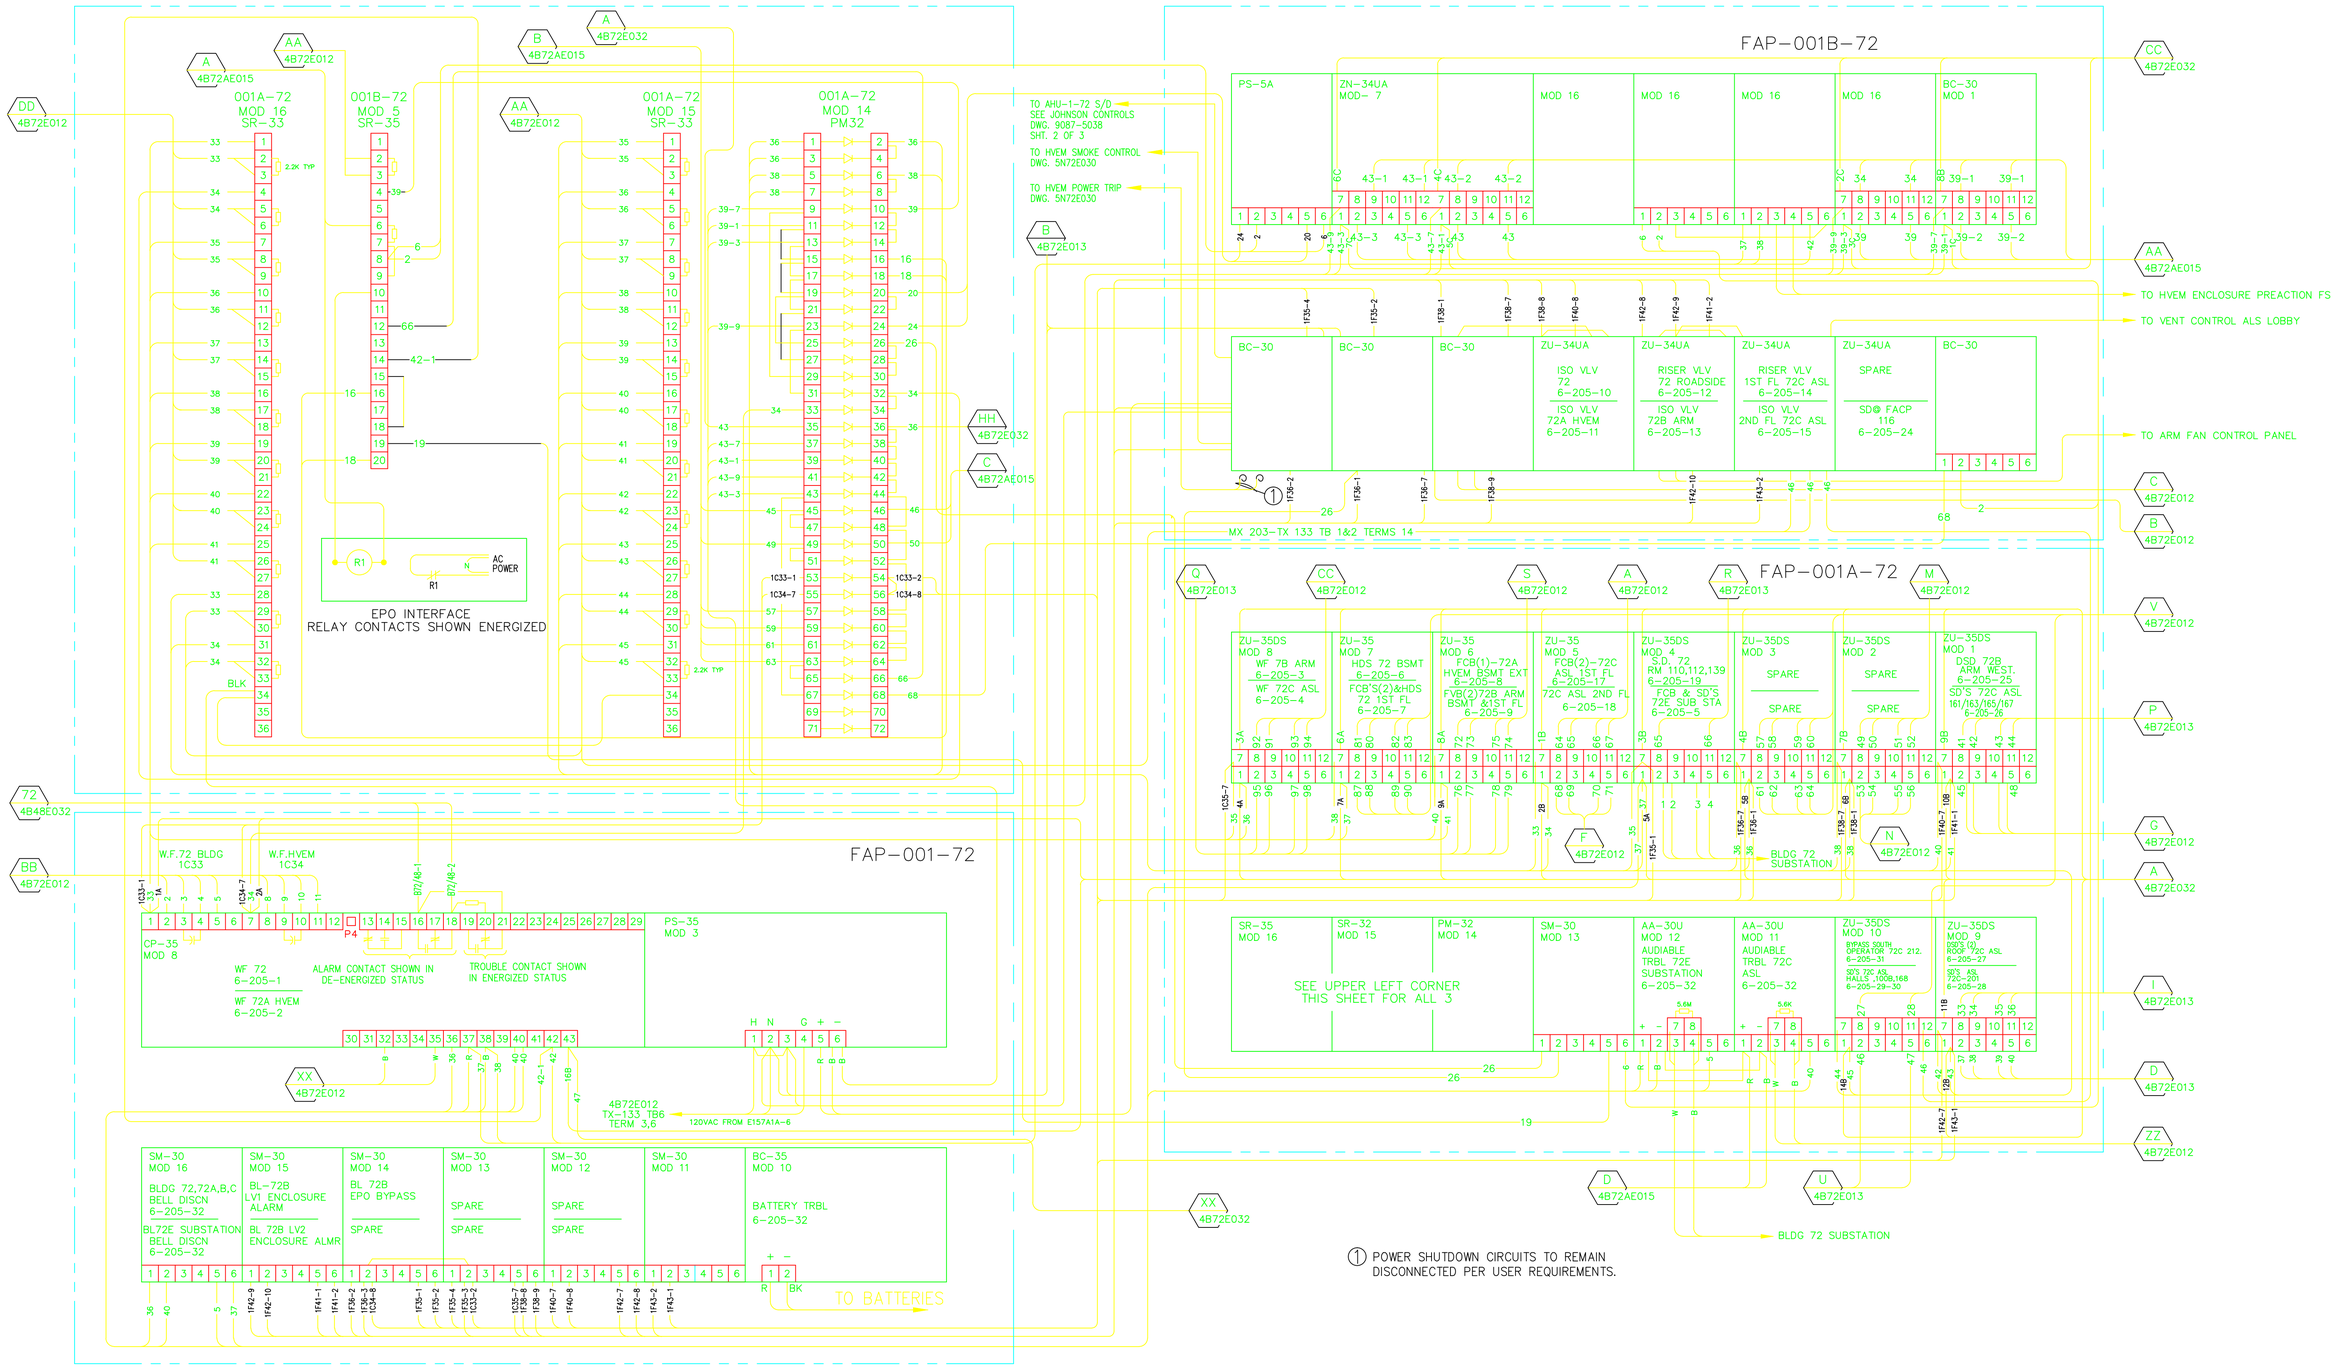

REFERENCE DRAWINGS

4B72E012	FIRE ALARM SYSTEM INTERCONNECTION DIAGRAM
4B72E013	FIRE ALARM SYSTEM ELEVATION & MISC. WIRING
4B72E017	FIRE ALARM SYSTEM LOGIC
4B72E032	FIRE ALARM SYSTEM-SYS 3 WIRING PANEL FAP-001C-72

AS BUILT
G
6/10/13

REVISION NUMBER	DRAWN BY	CHECKED BY	APPR'D BY	DATE	REMARKS
G	DSV	LDD	MCD	6/10/13	AS BUILT PER FIELD VERIFICATION
F	HYT	HYT	–	3/24/06	TEAM 0.5 RENOVATION
E	RZT	MCD	MCG	3/29/05	REVISED FOR DIGITIZE RECEIVER.
D	AD	AD	MCG	02/10/04	AS-BUILT PHASE II FA UPGRADE
C	HYT	HYT	–	5/23/02	REPLACEMENT FIRE ALARM PROJECT
B	LDD	MCG	MCG	5/23/02	REPLCMNT FA PROJ + RECONNECT PWR & VENT S/D CKTS
A	FWD	MCG	MCG	10/28/97	AS BUILT-EAST CANYON SW. STATION PROJECT

PROFESSIONAL SEAL (IF REVISION, APPLIES ONLY TO REVISED WORK)

ISSUE (PROGRESS, ESTIMATE, BID, CONSTRUCTION, CONFORMED, REVISION, RECORD)

72 COMPLEX FIRE ALARM SYSTEM
SYSTEM 3 WIRING
PANEL FAP-001-072

UNIVERSITY OF CALIFORNIA
LAWRENCE BERKELEY NATIONAL LABORATORY
FACILITIES DIVISION

DRAWN BY	FWD	DATE 9/4/1997
CHECKED BY	MCG	11/6/1997
APPROVED BY	MCG	11/6/1997
CAD FILE PATH		
SCALE	As Noted	
DRAWING NO.	4B72E022G	SHEET FA0.6
PROJECT NO.	FM6100	1 OF 1