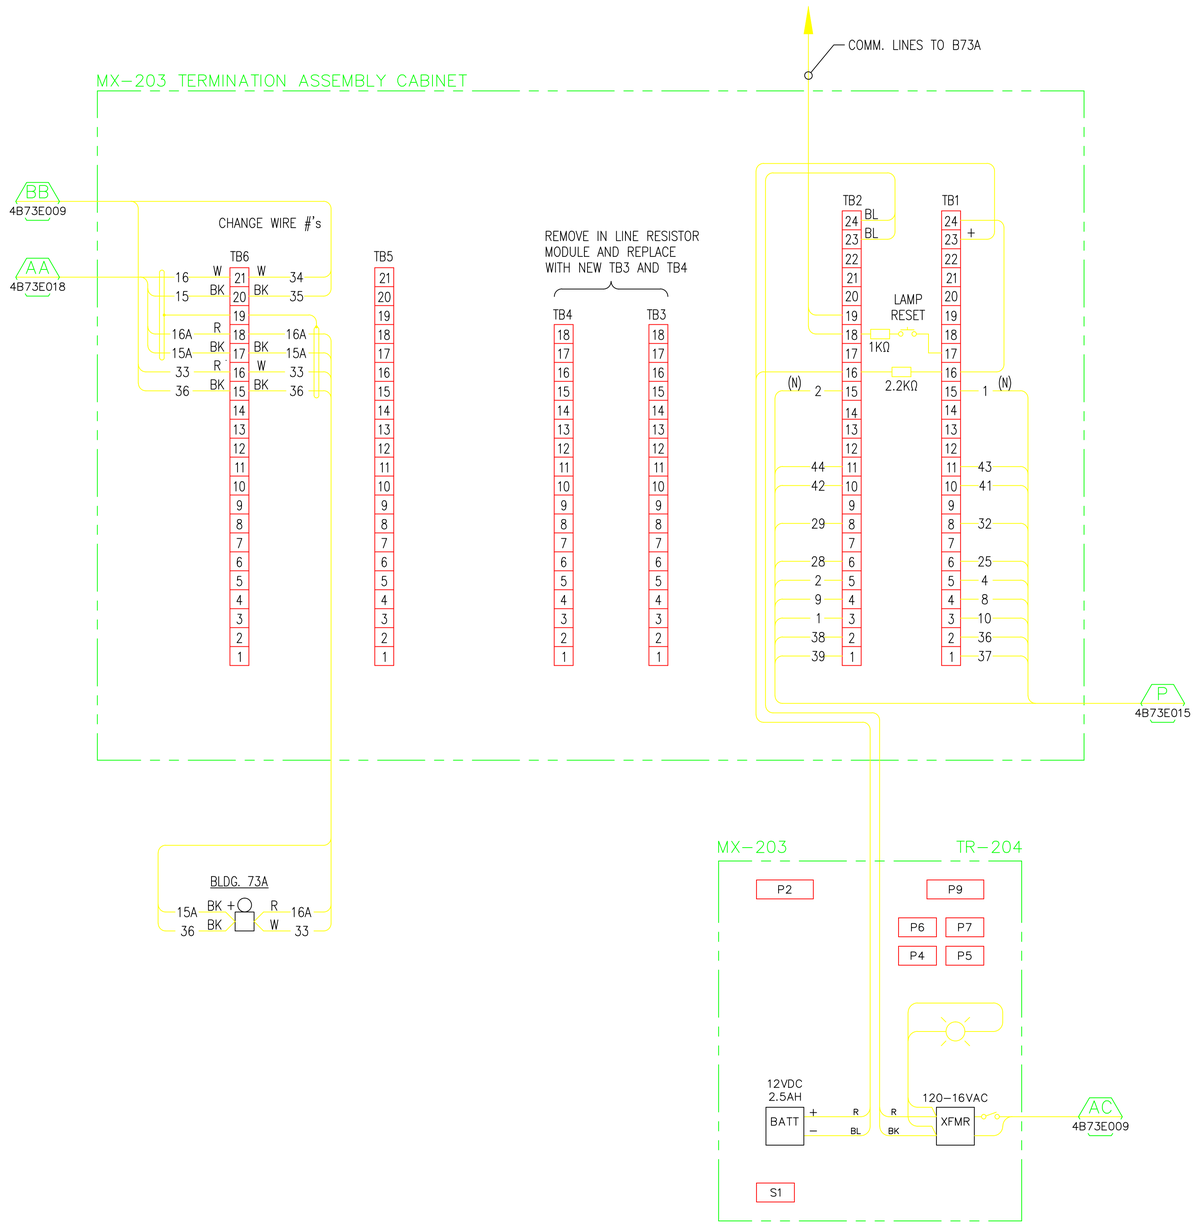

NOTES:

1. REFERENCE DRAWINGS:
   4B73E009
   4B73E010
   4B73E015
   4B73E016
   4B73E018
2. BECAUSE OF SPLICES BETWEEN TERMINATIONS. AN INDIVIDUAL CONDUCTOR MAY HAVE DIFFERENT COLOR DESIGNATIONS.
3. TS – TAMPER SWITCH
   FCB – FIRE CALL BOX
   WFS – WATER FLOW SWITCH

AS BUILT
D
6/7/13

REVISION NUMBER	DRAWN BY	CHECKED BY	APPR'D BY	DATE	REMARKS
D	DSV	LDD	MCD	6/7/13	AS BUILT PER FIELD VERIFICATION
C	RZT	MCG	MCG	5/6/05	REVISED FOR MXL/DIGITIZE SYSTEMS
B	LM		MG	5/23/97	AUTOCAD CONVERTION
A	LSR		RMG		ADDED SR-33

PROFESSIONAL SEAL (IF REVISION, APPLIES ONLY TO REVISED WORK)
ISSUE (PROGRESS, ESTIMATE, BID, CONSTRUCTION, CONFORMED, REVISION, RECORD)

73 & 73A FIRE ALARM SYSSTEM
SYSTEM 3 AND MX-203 INTERCONNECTION DIAGRAM

UNIVERSITY OF CALIFORNIA
LAWRENCE BERKELEY NATIONAL LABORATORY
FACILITIES DIVISION

DRAWN BY LSR	DATE 4/25/1984	
CHECKED BY BHS	6/1/1984	
APPROVED BY		
CAD FILE PATH		
SCALE As Noted		
DRAWING NO. 4B73E006D		SHEET 1 OF1
PROJECT NO. WG0721		