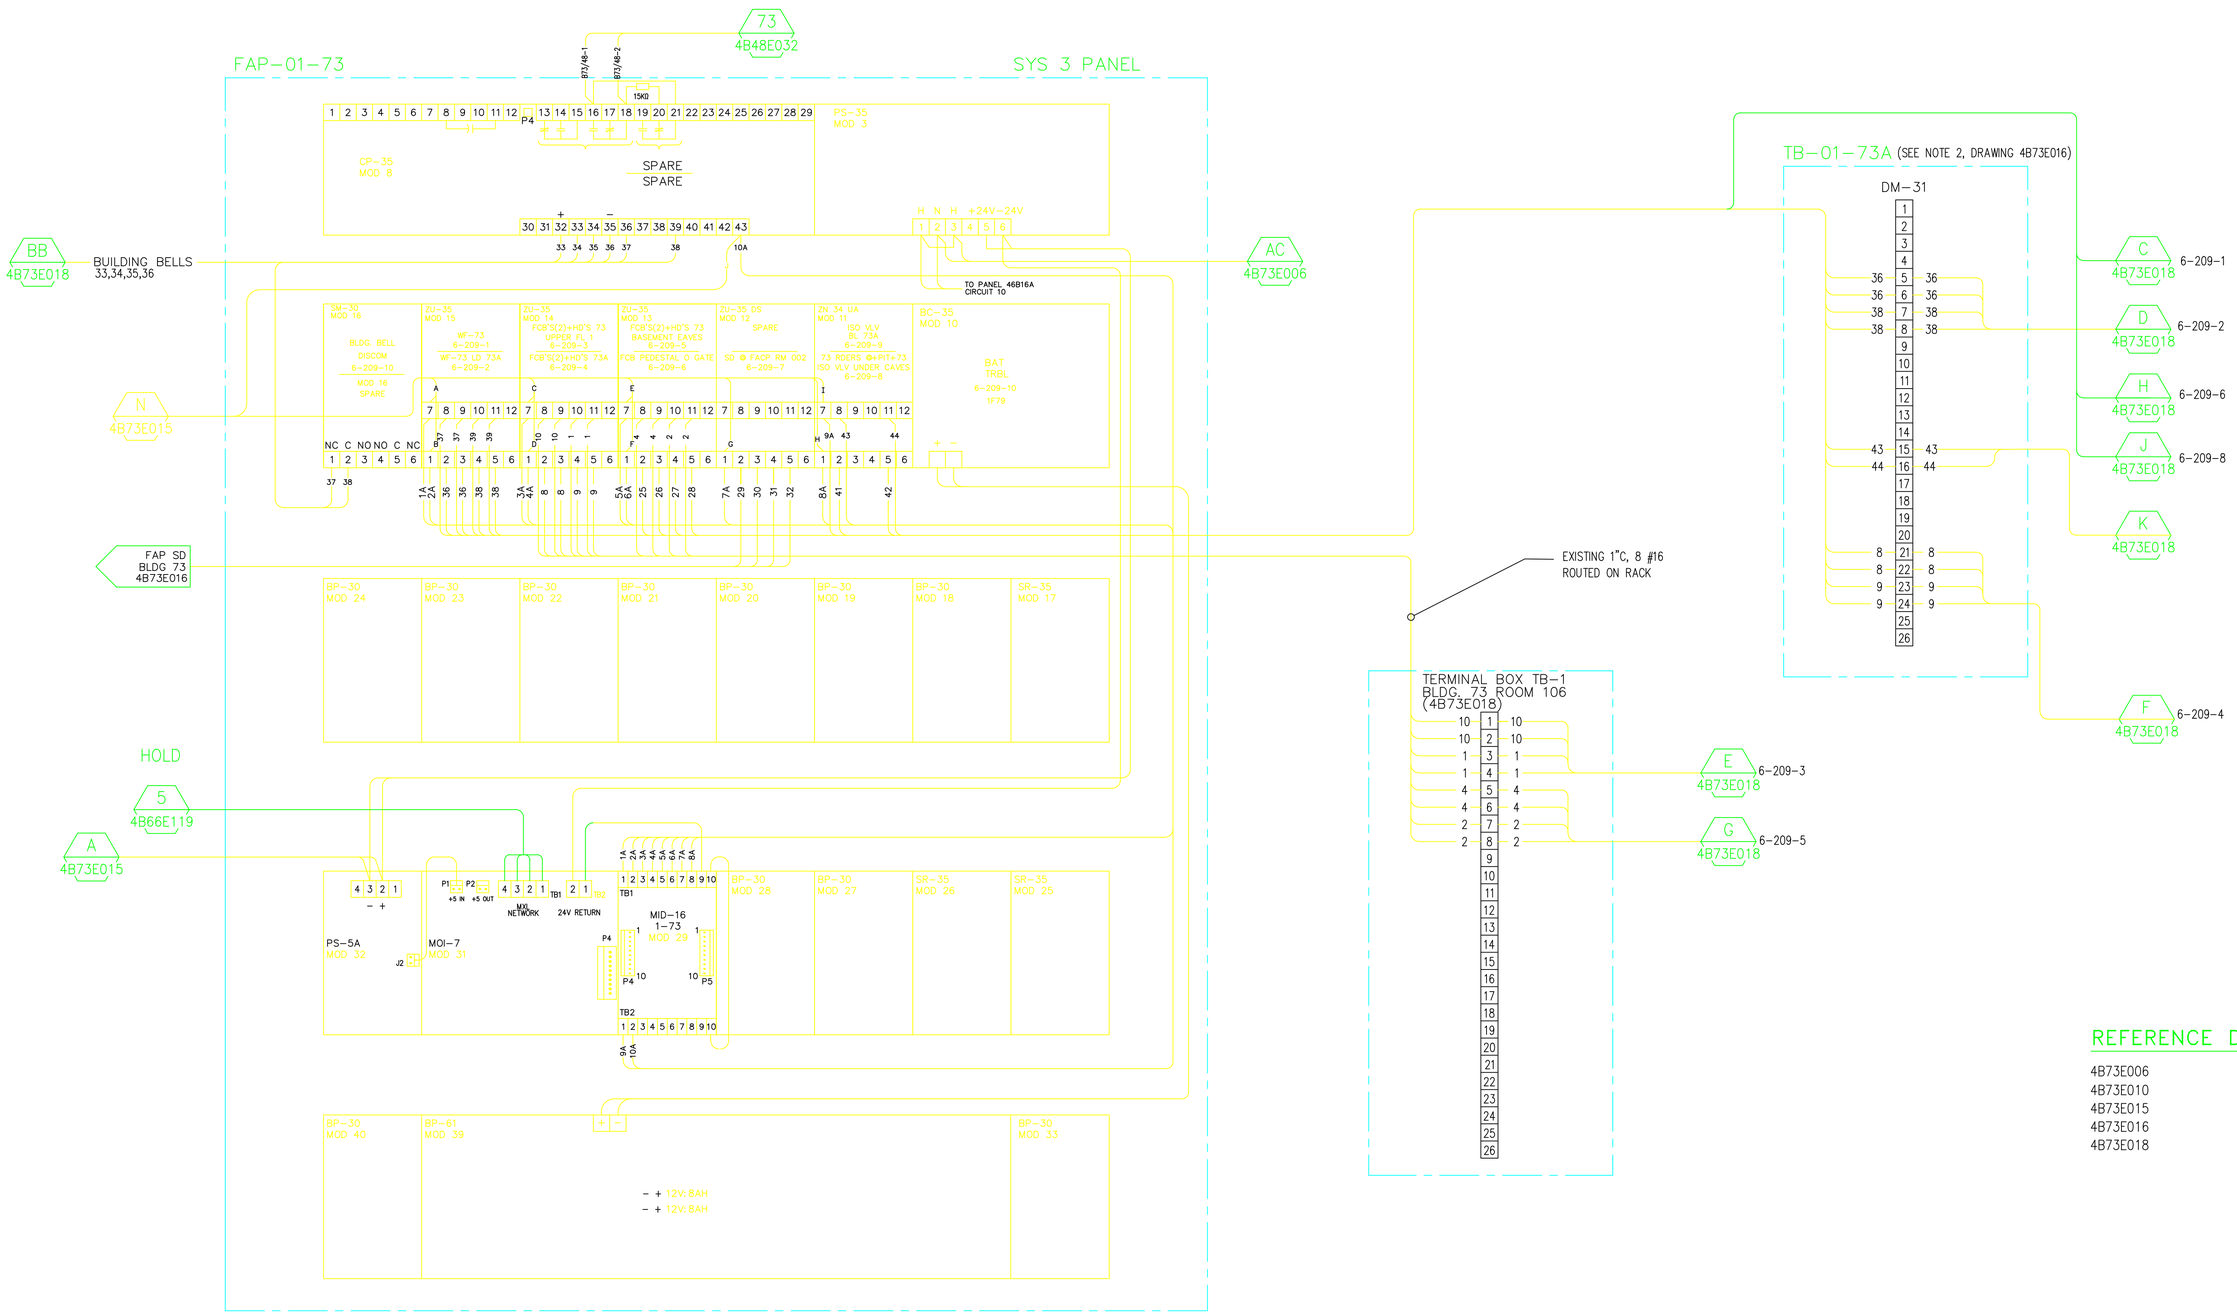

REFERENCE DRAWINGS:

4B73E006
4B73E010
4B73E015
4B73E016
4B73E018

	AS BUILT						
	C						
	6/7/13						
		C	DSV	LDD	MCD	6/7/13	AS BUILT PER FIELD VERIFICATION
		B	RZT	MCG	MCG	5/06/05	REVISED FOR MXL/DIGITIZE SYSTEMS
		A	MRC	AD	MCG	8/8/03	PHASE II FIRE ALARM SYSTEM UPGRADE
PROFESSIONAL SEAL (IF REVISION, APPLIES ONLY TO REVISED WORK)	ISSUE (PROGRESS, ESTIMATE, BID, CONSTRUCTION, CONFORMED, REVISION, RECORD)	REVISION NUMBER	DRAWN BY	CHECKED BY	APPR'D BY	DATE	REMARKS

73 BUILDING 73 & 73A
SYSTEM 3 PANEL FAP-01-73
INTERCONNECTION DIAGRAM

UNIVERSITY OF CALIFORNIA
LAWRENCE BERKELEY NATIONAL LABORATORY
FACILITIES DIVISION

DRAWN BY HYT	DATE 2/12/2002	
CHECKED BY HYT	2/12/2002	
APPROVED BY		
CAD FILE PATH		
SCALE As Noted		
DRAWING NO. 4B73E009C		SHEET 1 OF 1
PROJECT NO. WG0721		