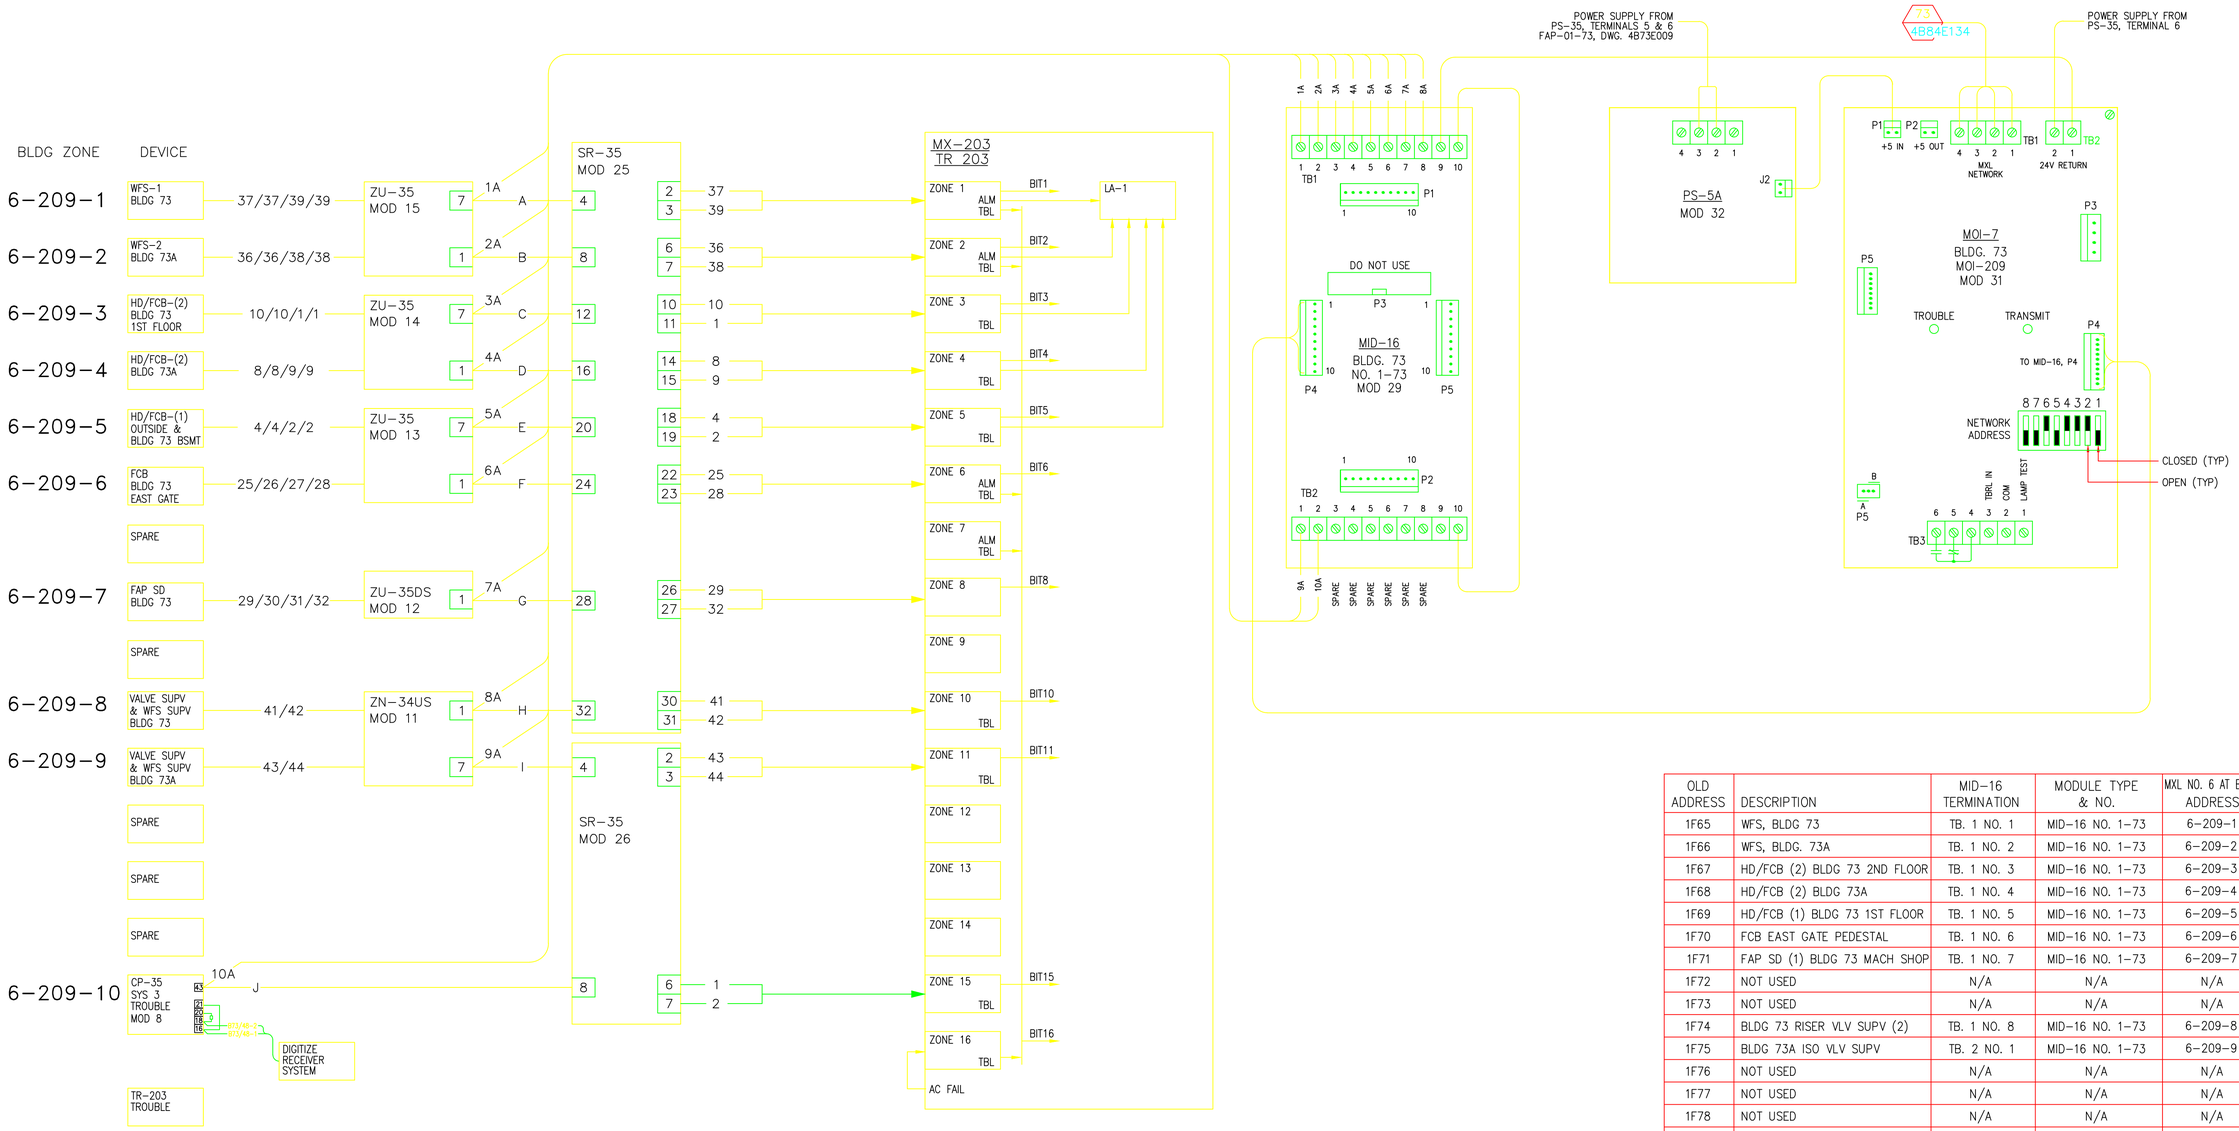

OLD ADDRESS	DESCRIPTION	MID-16 TERMINATION	MODULE TYPE & NO.	MXL NO. 6 AT B. 84 ADDRESS
1F65	WFS, BLDG 73	TB. 1 NO. 1	MID-16 NO. 1-73	6-209-1
1F66	WFS, BLDG. 73A	TB. 1 NO. 2	MID-16 NO. 1-73	6-209-2
1F67	HD/FCB (2) BLDG 73 2ND FLOOR	TB. 1 NO. 3	MID-16 NO. 1-73	6-209-3
1F68	HD/FCB (2) BLDG 73A	TB. 1 NO. 4	MID-16 NO. 1-73	6-209-4
1F69	HD/FCB (1) BLDG 73 1ST FLOOR	TB. 1 NO. 5	MID-16 NO. 1-73	6-209-5
1F70	FCB EAST GATE PEDESTAL	TB. 1 NO. 6	MID-16 NO. 1-73	6-209-6
1F71	FAP SD (1) BLDG 73 MACH SHOP	TB. 1 NO. 7	MID-16 NO. 1-73	6-209-7
1F72	NOT USED	N/A	N/A	N/A
1F73	NOT USED	N/A	N/A	N/A
1F74	BLDG 73 RISER VLV SUPV (2)	TB. 1 NO. 8	MID-16 NO. 1-73	6-209-8
1F75	BLDG 73A ISO VLV SUPV	TB. 2 NO. 1	MID-16 NO. 1-73	6-209-9
1F76	NOT USED	N/A	N/A	N/A
1F77	NOT USED	N/A	N/A	N/A
1F78	NOT USED	N/A	N/A	N/A
1F79	SYSTEM 3 TROUBLE	TB. 2 NO. 2	MID-16 NO. 1-73	6-209-10
1F80	MX-203 (TR-203) TROUBLE	N/A	N/A	N/A

FORMERLY MX-203 (TR 203)

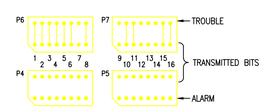

PROGRAM PLUGS

TRANSMITTER ID SWITCH

00100010=(34+1)=35

AS BUILT

D

6/7/13

REVISION NUMBER	DRAWN BY	CHECKED BY	APPR'D BY	DATE	REMARKS
D	DSV	LDD	MCD	6/7/13	AS BUILT PER FIELD VERIFICATIONS
C	AD	LDD	MCD	7/25/06	REVISED FOR MXL COPPER LOOP
B	RZT	MCG	MCG	5/06/05	REVISED FOR MXL/DIGITIZE SYSTEMS
A	MRC	MCG	MCG	8/1/03	PHASE II FIRE ALARM SYSTEM UPGRADE

PROFESSIONAL SEAL (IF REVISION, APPLIES ONLY TO REVISED WORK)

ISSUE (PROGRESS, ESTIMATE, BID, CONSTRUCTION, CONFORMED, REVISION, RECORD)

73 BUILDING 73 & 73A

REPLACEMENT FIRE ALARM SYSTEM

LOGIC DIAGRAM

UNIVERSITY OF CALIFORNIA
LAWRENCE BERKELEY NATIONAL LABORATORY
FACILITIES DIVISION

DRAWN BY	HYT	DATE 2/12/2002
CHECKED BY	HYT	2/12/2002
APPROVED BY		
CAD FILE PATH		
SCALE	As Noted	
DRAWING NO.	4B73E010D	SHEET
PROJECT NO.	WG0721	1 OF 1