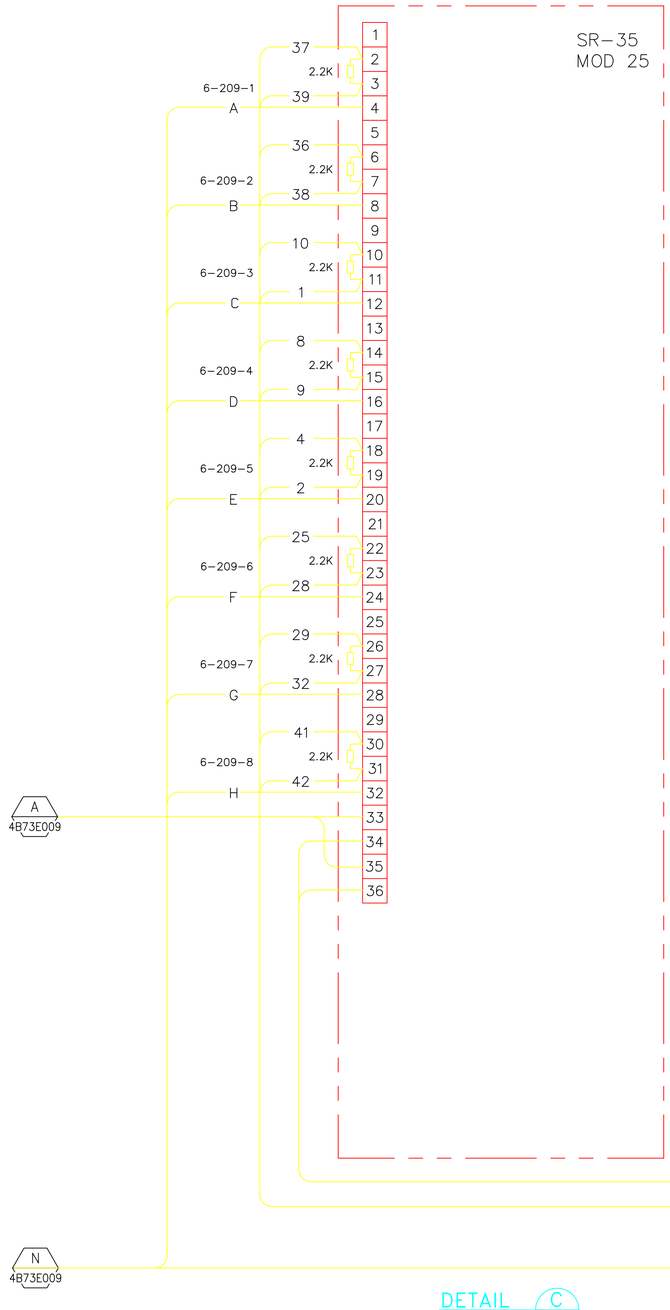

DETAIL C
SCALE: NONE 4B73E009

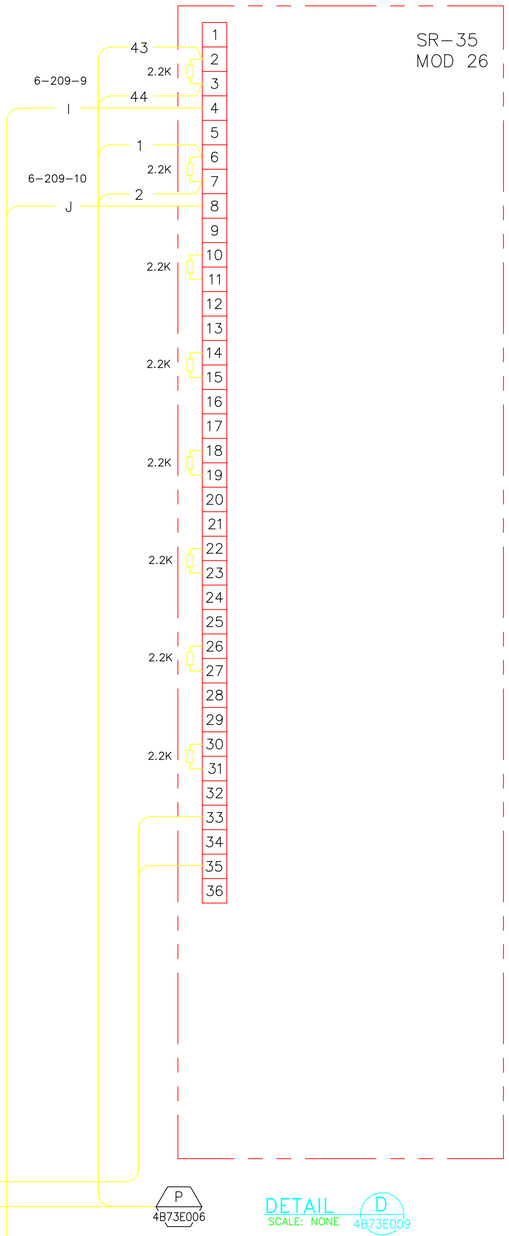

DETAIL D
SCALE: NONE 4B73E009

REFERENCE DRAWINGS:

4B73E006
4B73E009
4B73E010
4B73E016
4B73E018

	AS BUILT B 6/7/13	B	DSV	LDD	MCD	6/7/13	AS BUILT PER FIELD VERIFICATION
		A	RZT	MCG	MCG	5/02/05	REVISED FOR DIGITIZE SYSTEM
PROFESSIONAL SEAL (IF REVISION, APPLIES ONLY TO REVISED WORK)	ISSUE (PROGRESS, ESTIMATE, BID, CONSTRUCTION, CONFORMED, REVISION, RECORD)	REVISION NUMBER	DRAWN BY	CHECKED BY	APPR'D BY	DATE	REMARKS

73 BUILDING 73 & 73A
PARTIAL PLAN, SECTIONS AND
SR-35 CONNECTION DIAGRAM

UNIVERSITY OF CALIFORNIA
LAWRENCE BERKELEY NATIONAL LABORATORY
FACILITIES DIVISION

DRAWN BY	HYT	DATE	2/12/2002
CHECKED BY	HYT		2/12/2002
APPROVED BY			
CAD FILE PATH			
SCALE	As Noted		
DRAWING NO.	4B73E015B	SHEET	1 OF 1
PROJECT NO.	WG0721		