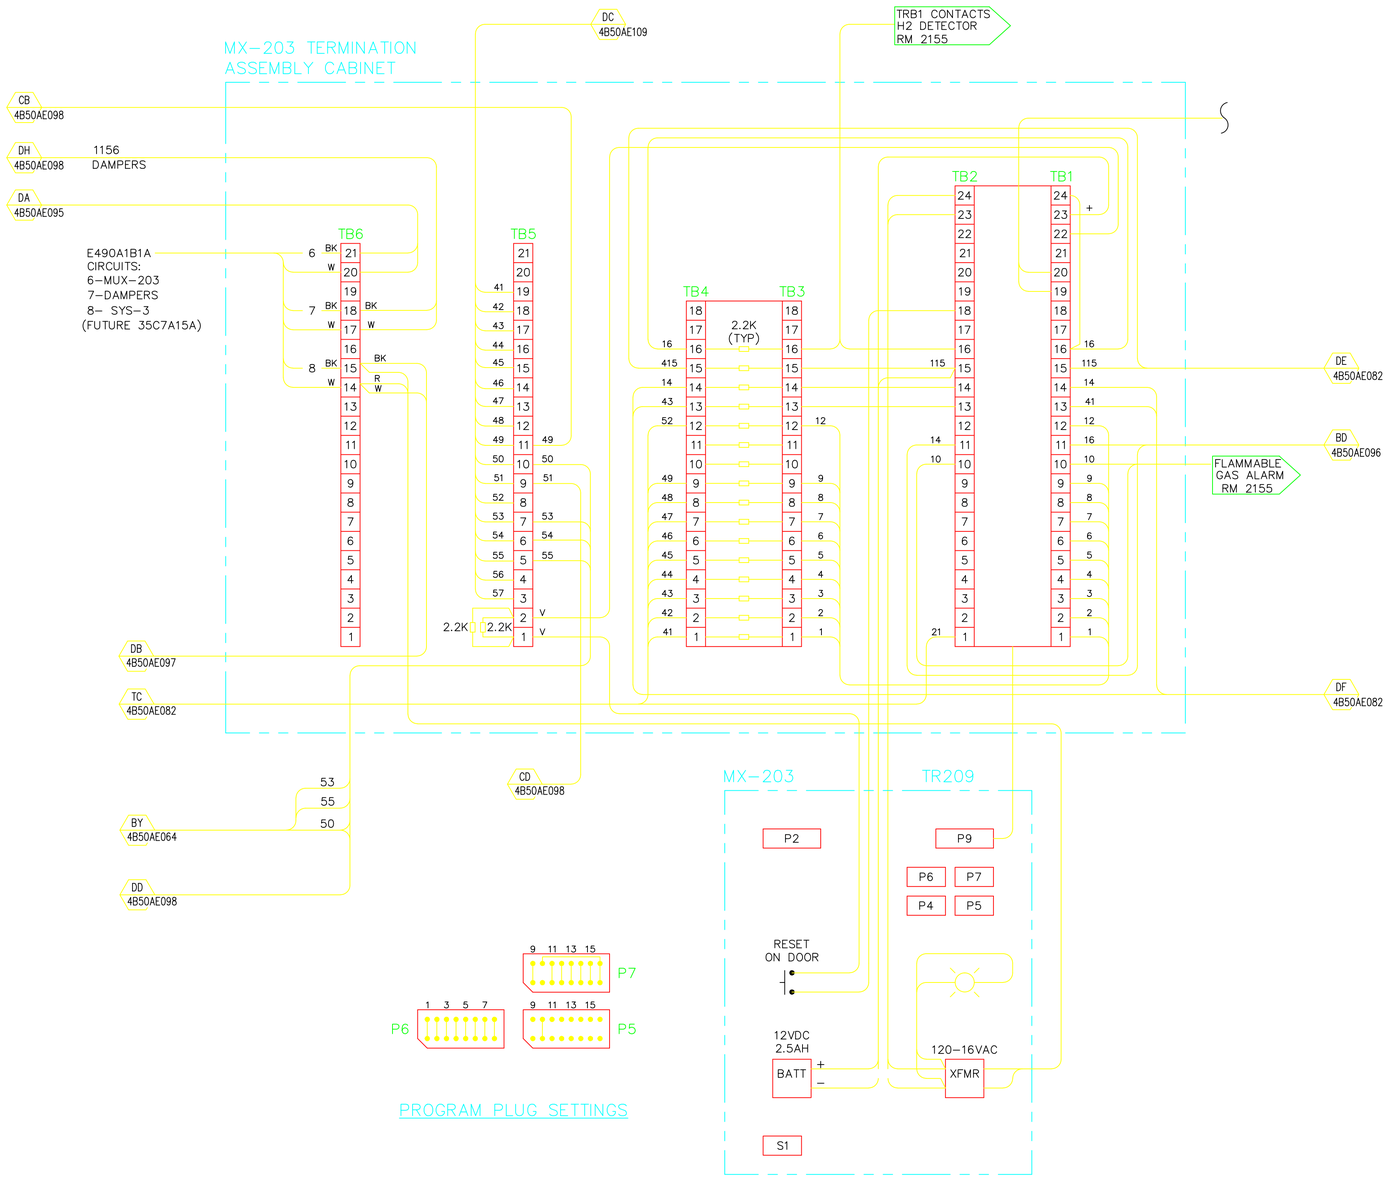

DISTRIBUTION LIST:

2-ELECTRIC SHOP 76 (FILE I & II)
1-FILE III (B90J)
1-STICK FILE (B90J)
ORIGINAL-FLAT FILE (B90F)

REVISION NUMBER	DRAWN BY	CHECKED BY	APPR'D BY	DATE	REMARKS
D	AD	ROB	MCG	7/14/00	AS BUILT
C	SEM	JWD		6/96	CHECKED O.K. 6/24/96 - AS BUILT
B		JWD		10/94	AS BUILT
A		JWD		1/94	

73 BUILDING 73 & 73A
MX-203 TERMINAL CABINET
INTERCONNECTION DIAGRAM

UNIVERSITY OF CALIFORNIA LAWRENCE BERKELEY LABORATORY
FACILITIES DEPARTMENT

DRAWN BY	MRC	DATE 8/8/2003
CHECKED BY	AD	8/8/2003
APPROVED BY	MCG	8/8/2003
CAD FILE PATH	00016246	
SCALE	As Noted	
DRAWING NO.	4B73E017A	SHEET 1 OF 1
PROJECT NO.	WG0721	