MXL-FIRE ALARM CONTROL PANEL
LOCATED AT FLOOR 1 ELECTRICAL ROOM 118A

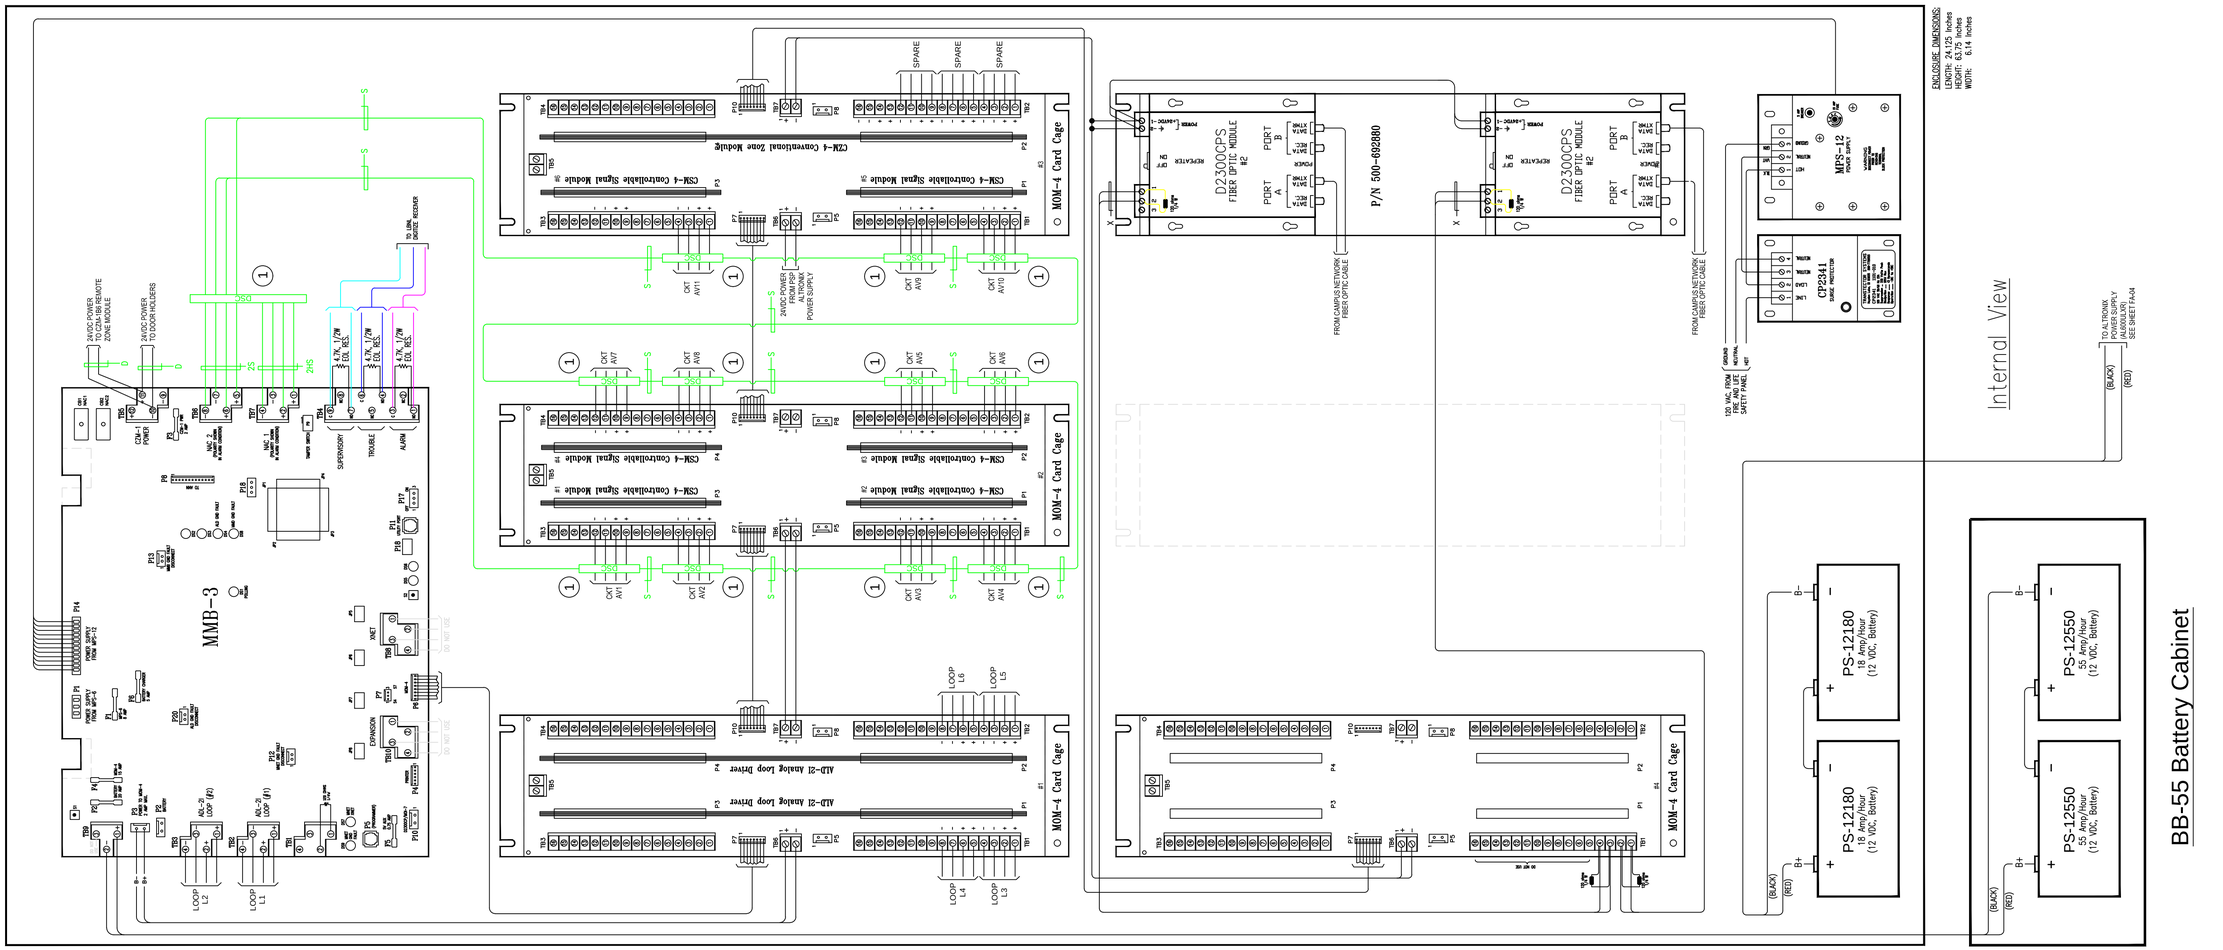

SHEET NOTE:
(1) FOR DUAL SYNCHRONIZATION MODULE POINT TO POINT WIRING DETAILS SEE DWG 4B74E305

PROFESSIONAL SEAL (IF REVISION, APPLIES ONLY TO REVISED WORK)	ISSUE (PROGRESS, ESTIMATE, BID, CONSTRUCTION, CONFORMED, REVISION, RECORD)	REVISION NUMBER	DRAWN BY	CHECKED BY	APPR'D BY	DATE	REMARKS
	AS BUILT — 08/28/13	_	DSV	LDD	MCD	08/28/13	AS BUILT FROM A/E RECORD DWGS

74 FIRE ALARM SYSTEM
FAP-01-074 DETAIL & WIRING
BATTERY & POWER CALCULATIONS

UNIVERSITY OF CALIFORNIA
LAWRENCE BERKELEY NATIONAL LABORATORY
FACILITIES DIVISION

DRAWN BY	DSV	DATE 08/28/13
CHECKED BY	LDD	09/03/2013
APPROVED BY	MCD	09/03/2013
SCALE	AS NOTED	
DRAWING NO.	4B74E303	SHEET 2 OF 20
PROJECT NO.	FN9200	