FLOOR 2 HALLWAY HSSD#3 SCHEMATIC

SCALE: None

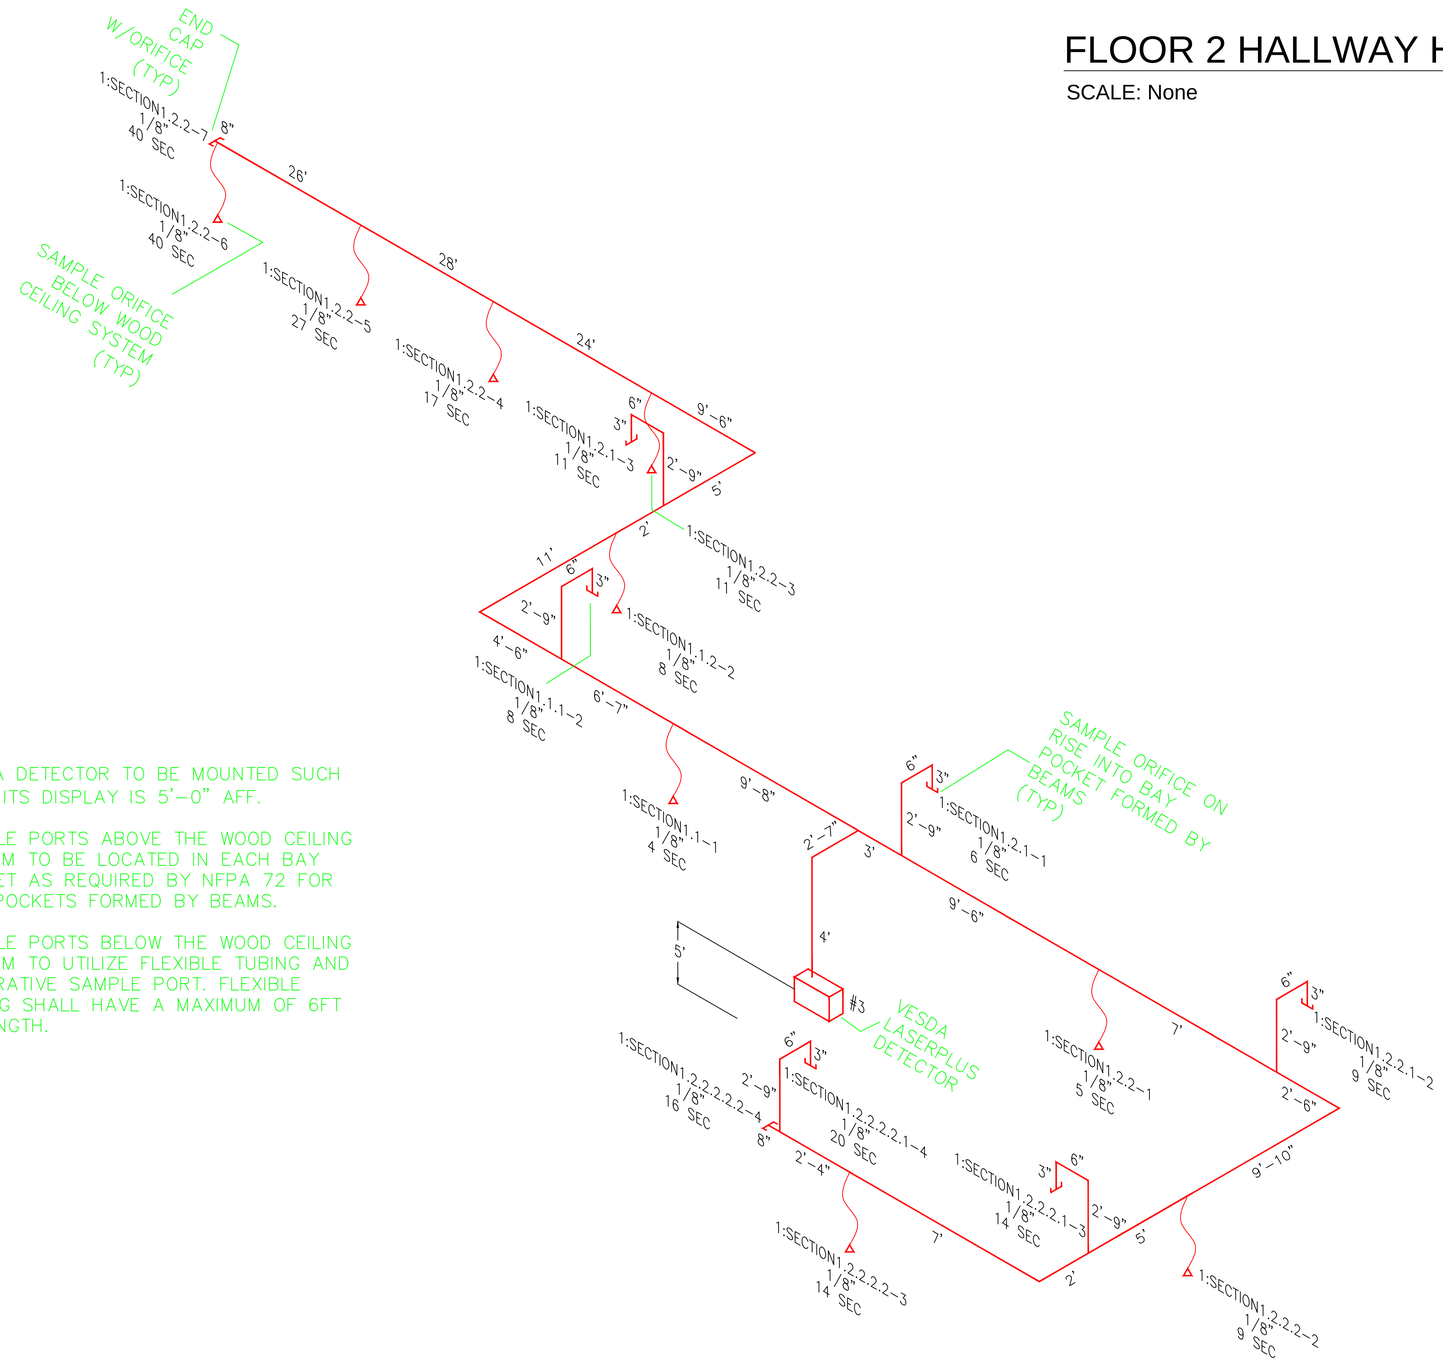

NOTES:

1. VESDA DETECTOR TO BE MOUNTED SUCH THAT ITS DISPLAY IS 5'-0" AFF.
2. SAMPLE PORTS ABOVE THE WOOD CEILING SYSTEM TO BE LOCATED IN EACH BAY POCKET AS REQUIRED BY NFPA 72 FOR BAY POCKETS FORMED BY BEAMS.
3. SAMPLE PORTS BELOW THE WOOD CEILING SYSTEM TO UTILIZE FLEXIBLE TUBING AND DECORATIVE SAMPLE PORT. FLEXIBLE TUBING SHALL HAVE A MAXIMUM OF 6FT IN LENGTH.

PROFESSIONAL SEAL (IF REVISION, APPLIES ONLY TO REVISED WORK)	ISSUE (PROGRESS, ESTIMATE, BID, CONSTRUCTION, CONFORMED, REVISION, RECORD)	REVISION NUMBER	DRAWN BY	CHECKED BY	APPR'D BY	DATE	REMARKS
	AS BUILT — 08/28/13	–	DSV	LDD	MCD	08/28/13	AS BUILT FROM A/E RECORD DWGS

74 FIRE ALARM SYSTEM
2ND FLOOR HSSD PIPING SCHEMATIC

UNIVERSITY OF CALIFORNIA
LAWRENCE BERKELEY NATIONAL LABORATORY
FACILITIES DIVISION

DRAWN BY	DSV	DATE 08/28/13
CHECKED BY	LDD	09/03/2013
APPROVED BY	MCD	09/03/2013
SCALE	AS NOTED	
DRAWING NO.	4B74E320	SHEET 19 OF 20
PROJECT NO.	FN9200	