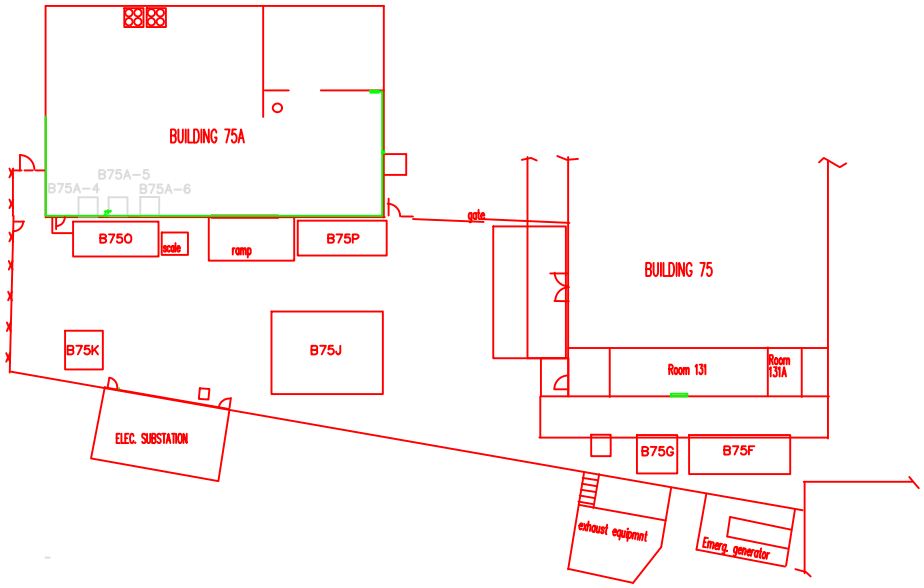

A SITE PLAN

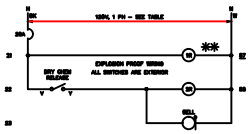

** ADD THIS RELAY

CHEM-STORE B75A-5

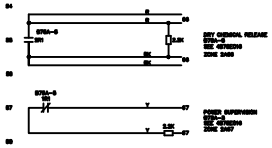

FIRE ALARM CONNECTIONS

STORAGE CONTAINER	FED FROM CIRCUIT	CONNECT TO FIRE ZONE	BLOWER POWER
B75A4	--	--	--
B75A5	334A15	2A59 & 67	--
B75A6	--	--	--

REVISION NUMBER	DRAWN BY	CHECKED BY	APPVD BY	DATE	REMARKS
D	ROB	MCG	MCG	6/6/97	AS-BUILT JO 022959
C	ROB	MCG	MCG	4/11/97	REMOVE 75A1,2,3 & 75H,I,M,N
B	RB	JH		3/30/94	AS-BUILT
A	RB	JH	BHS	12/13/93	ADD R1 CONTACT TO BL-4 STARTER

75A HWHF AREA
PART B PERMIT UPGRADE
ELECTRICAL CONNECTIONS

UNIVERSITY OF CALIFORNIA LAWRENCE BERKELEY LABORATORY
FACILITIES DEPARTMENT

DRAWN BY	ROB	DATE 12/06/93
CHECKED BY	BHS	12/06/93
APPROVED BY	BHS	12/06/93
CAD FILE PATH	00002143	
SCALE	As Noted	
DRAWING NO.	4B75AE005D	SHEET E6 1 OF 1
PROJECT NO.	022959	