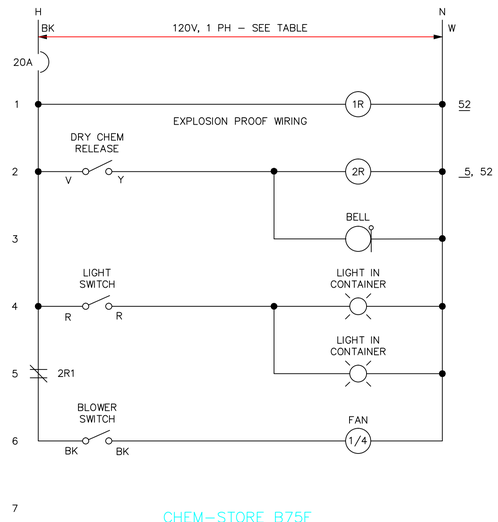

CHEM–STORE B75F

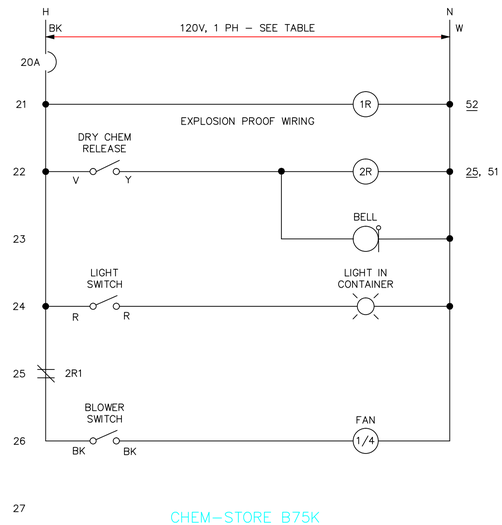

CHEM–STORE B75K

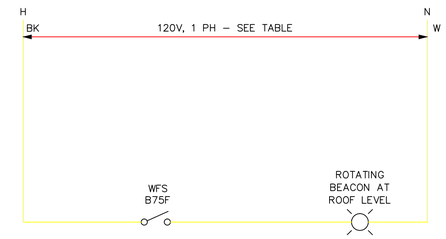

STORAGE CONTAINER	FED FROM CIRCUIT	CONNECT TO FIRE ZONE
B75F	E37A70A–16	7–204–13
B75G	E37A70A–14	7–204–13
B75K	E37A70A–17	7–204–14
B75F LITE	E37A70A–16	

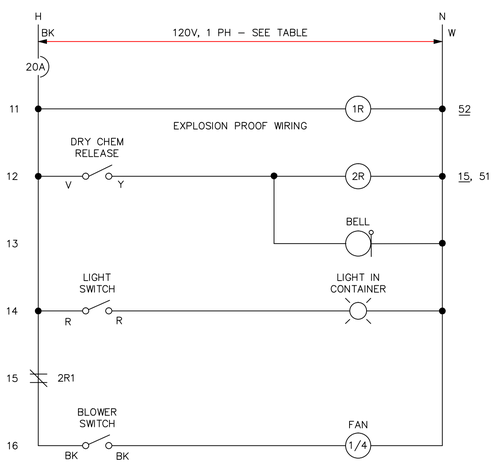

CHEM–STORE B75G

REFERENCE DRAWINGS

1. 4B75E014 XMITTER 205 LOGIC
2. 4B75E015 MX–316 CONNECTIONS
3. 4B75E016 SYS 3 CONNECTIONS
4. 4B75E001 LOGIC AND DEVICES

AS BUILT

E
6/7/13

REVISION NUMBER	DRAWN BY	CHECKED BY	APPR'D BY	DATE	REMARKS
E	DSV	LDD	MCD	6/7/13	AS BUILT PER FIELD VERIFICATION
D	AD	MCG	MCG	05/04/05	ZONE 1H13 & 1H14 SHOWN ON DWG 4B75E001
C	ROB	MCG	MCG	6/6/97	AS–BUILT JO 022959
B	ROB	MCG	MCG	4/11/97	REMOVE CHEM STORE 75L
A	RB	JH		4/1/94	AS–BUILT

PROFESSIONAL SEAL (IF REVISION, APPLIES ONLY TO REVISED WORK)

ISSUE (PROGRESS, ESTIMATE, BID, CONSTRUCTION, CONFORMED, REVISION, RECORD)

75 HWHF AREA

FIRE ALARM SYSTEM WIRING

STORAGE CONTAINER 75F,G & K

UNIVERSITY OF CALIFORNIA
LAWRENCE BERKELEY NATIONAL LABORATORY
FACILITIES DIVISION

DRAWN BY	ROB	DATE 12/6/1993
CHECKED BY	BHS	12/6/1993
APPROVED BY	BHS	12/6/1993
CAD FILE PATH		
SCALE	As Noted	
DRAWING NO.	4B75E023E	SHEET
PROJECT NO.	FE5011	1 OF 1