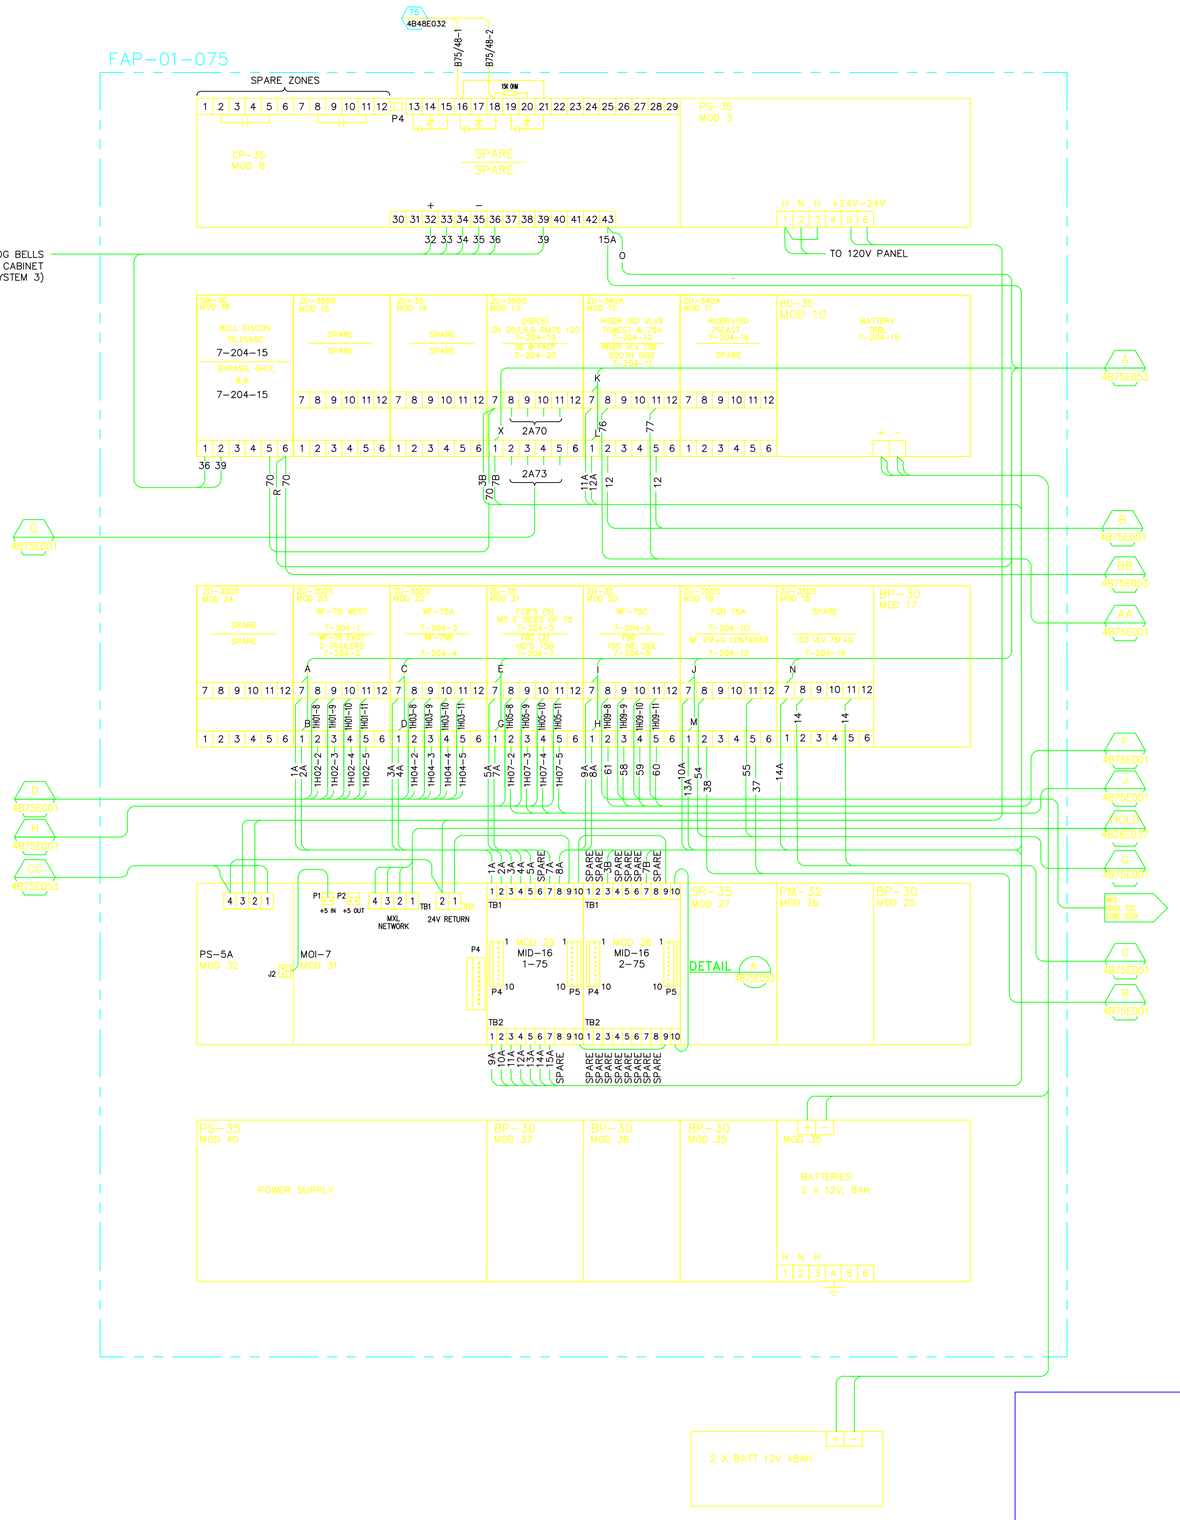

REFERENCE DRAWINGS:

4B75E053	SR-35 RELAY WIRING DIAGRAMS
4B75E023	FIRE ALARM SYSTEM WIRING

AS BUILT

D
6/6/13

REVISION NUMBER	DRAWN BY	CHECKED BY	APPR'D BY	DATE	REMARKS
D	DSV	LDD	MCD	6/7/13	AS BUILT PER FIELD VERIFICATION
C	AD	MCG	MCG	05/04/05	REVISED FOR MXL/DIGITIZE SYSTEMS
B	AD	MCG	MCG	10/13/04	AS BUILT RECORD DRAWING
A	AD	AD	MCG	09/05/03	PHASE II FIRE ALARM SYSTEM UPGRADE

PROFESSIONAL SEAL (IF REVISION, APPLIES ONLY TO REVISED WORK)

ISSUE (PROGRESS, ESTIMATE, BID, CONSTRUCTION, CONFORMED, REVISION, RECORD)

75 FIRE ALARM

REPLACEMENT FIRE ALARM SYSTEM

SYSTEM 3 WIRING DIAGRAM

UNIVERSITY OF CALIFORNIA
LAWRENCE BERKELEY NATIONAL LABORATORY
FACILITIES DIVISION

DRAWN BY	HYT	DATE 2/12/2002
CHECKED BY	HYT	2/12/2002
APPROVED BY		
CAD FILE PATH		
SCALE	As Noted	
DRAWING NO.	4B75E052D	SHEET
PROJECT NO.	FE5011	1 OF 1