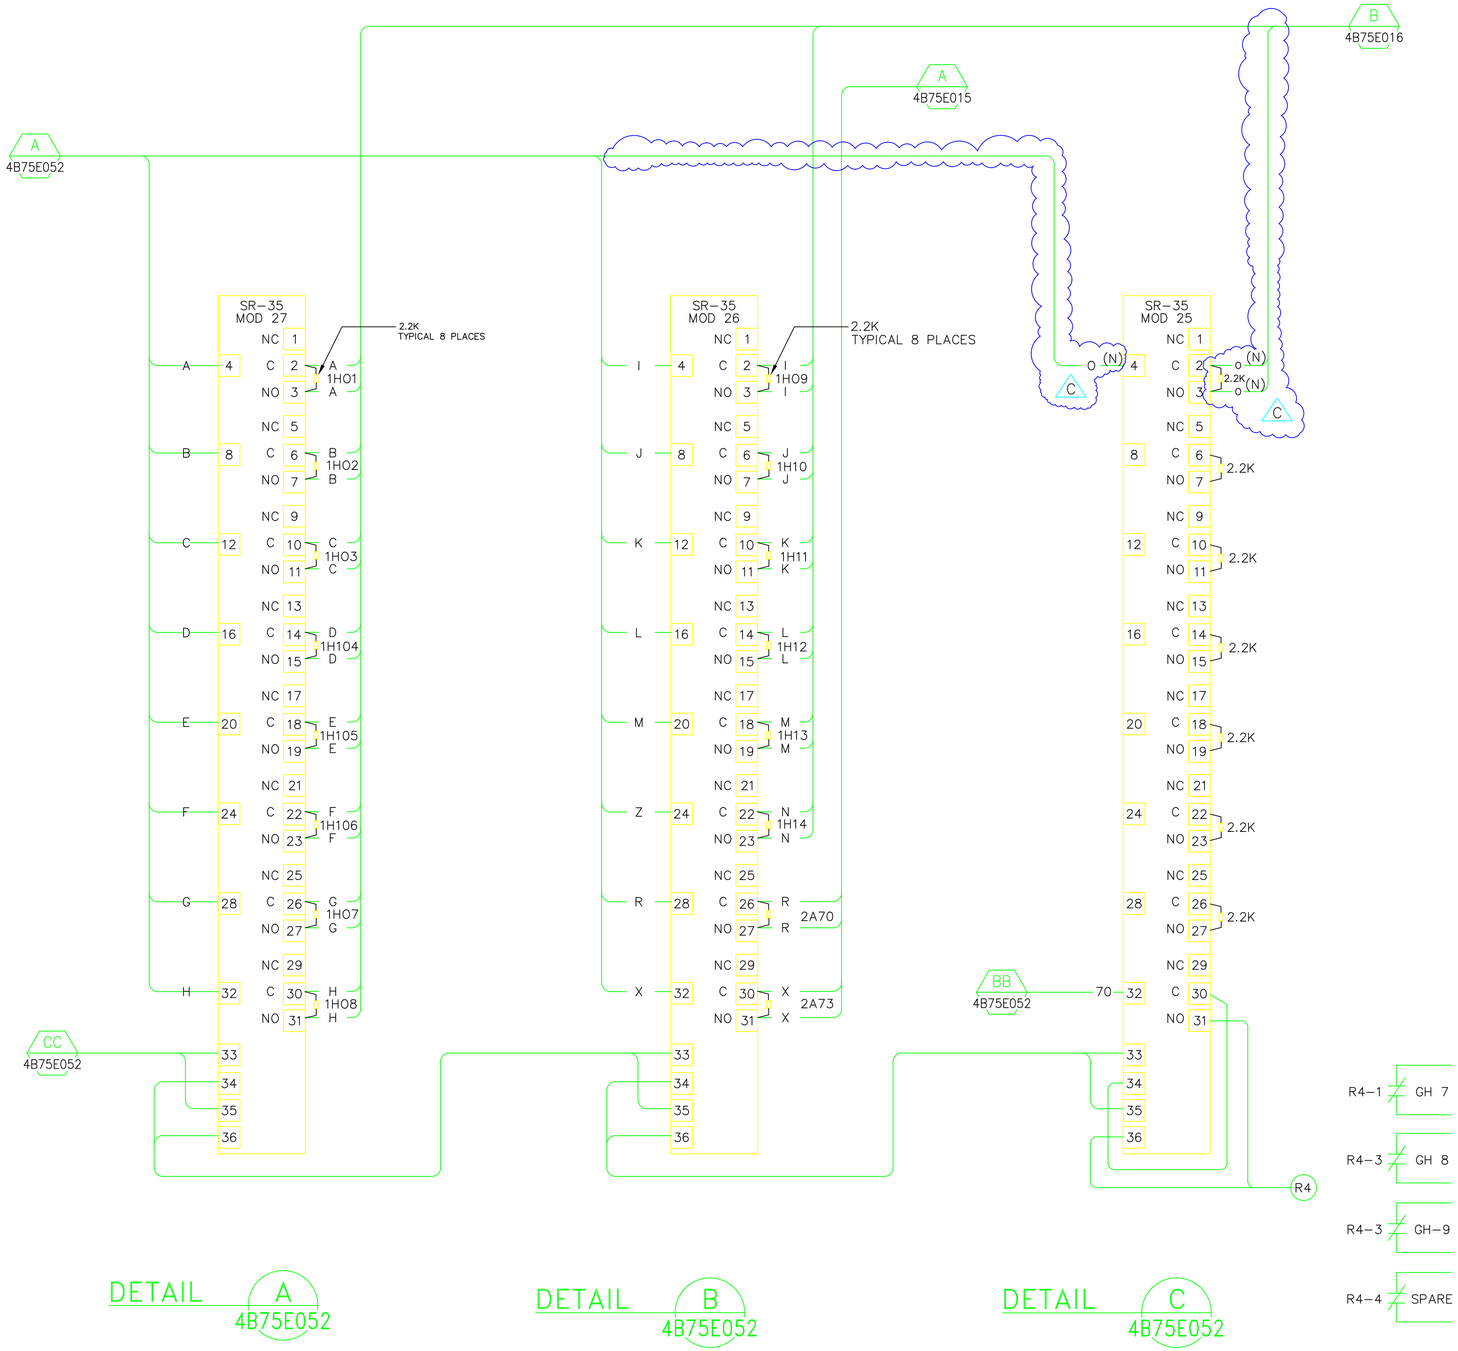

DETAIL A 4B75E052

DETAIL B 4B75E052

DETAIL C 4B75E052

	TITLE 2 CONSTRUCTION C 5/4/2005	C	AD	MCG	MCG	05/04/05	REVISED FOR MXL/DIGITIZE SYSTEMS
		B	AD	MCG	MCG	10/06/04	AS BUILT RECORD DRAWING
		A	MRC	AD	MCG	8/21/03	PHASE II FIRE ALARM SYSTEM UPGRADE
PROFESSIONAL SEAL (IF REVISION, APPLIES ONLY TO REVISED WORK)	ISSUE (PROGRESS, ESTIMATE, BID, CONSTRUCTION, CONFORMED, REVISION, RECORD)	REVISION NUMBER	DRAWN BY	CHECKED BY	APPR'D BY	DATE	REMARKS

75 BUILDING 75
REPLACEMENT FIRE ALARM SYSTEM
SR-35 RELAY WIRING DIAGRAMS

UNIVERSITY OF CALIFORNIA
LAWRENCE BERKELEY NATIONAL LABORATORY
FACILITIES DIVISION

DRAWN BY HYT	DATE 2/12/2003	
CHECKED BY HYT	2/12/2003	
APPROVED BY		
CAD FILE PATH 00019384		
SCALE Full		
DRAWING NO. 4B75E053C		SHEET 1 OF 1
PROJECT NO. FE5011		