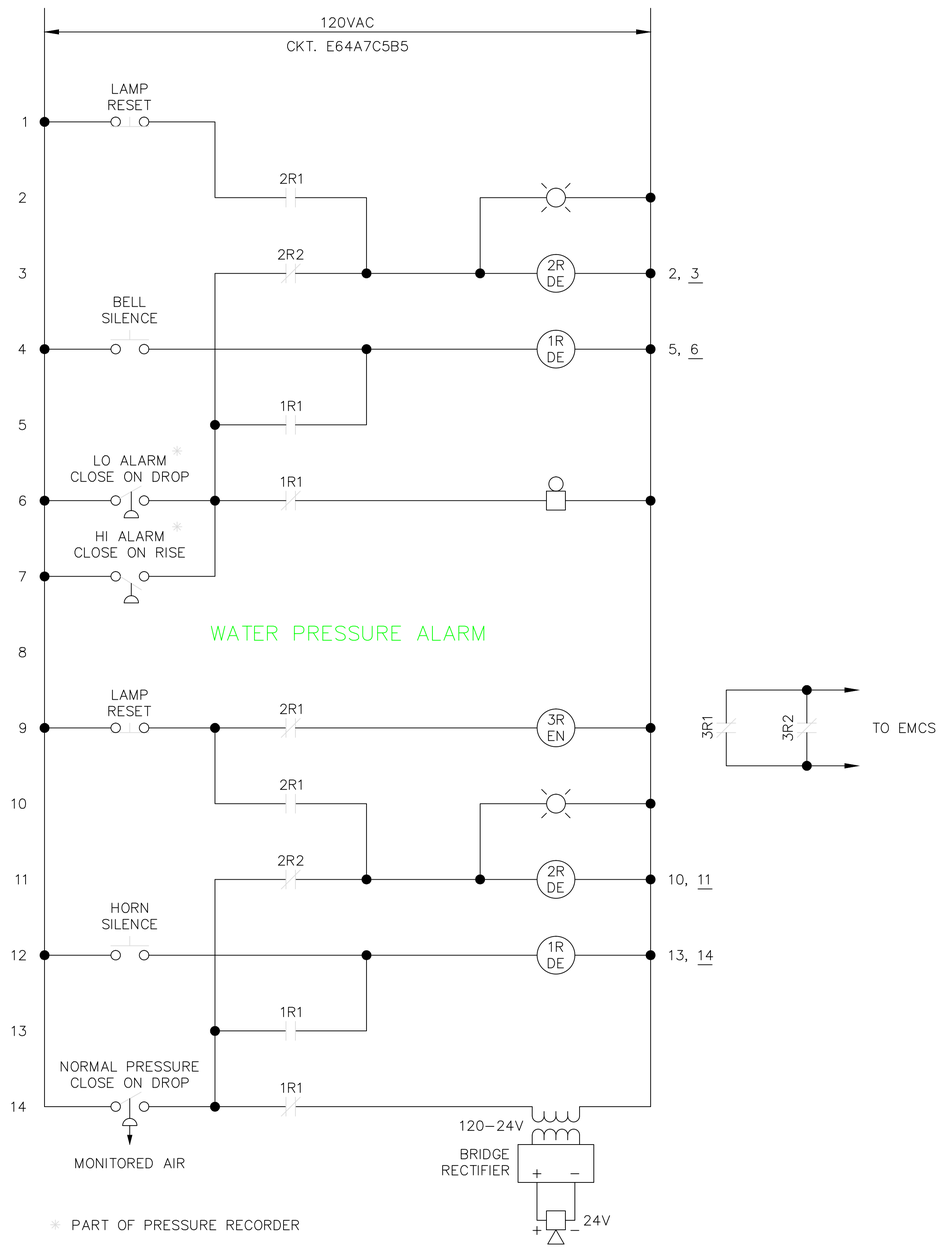

HILL AIR SUPPLY LOW PRESSURE ALARM

ELEMENTARY DIAGRAM

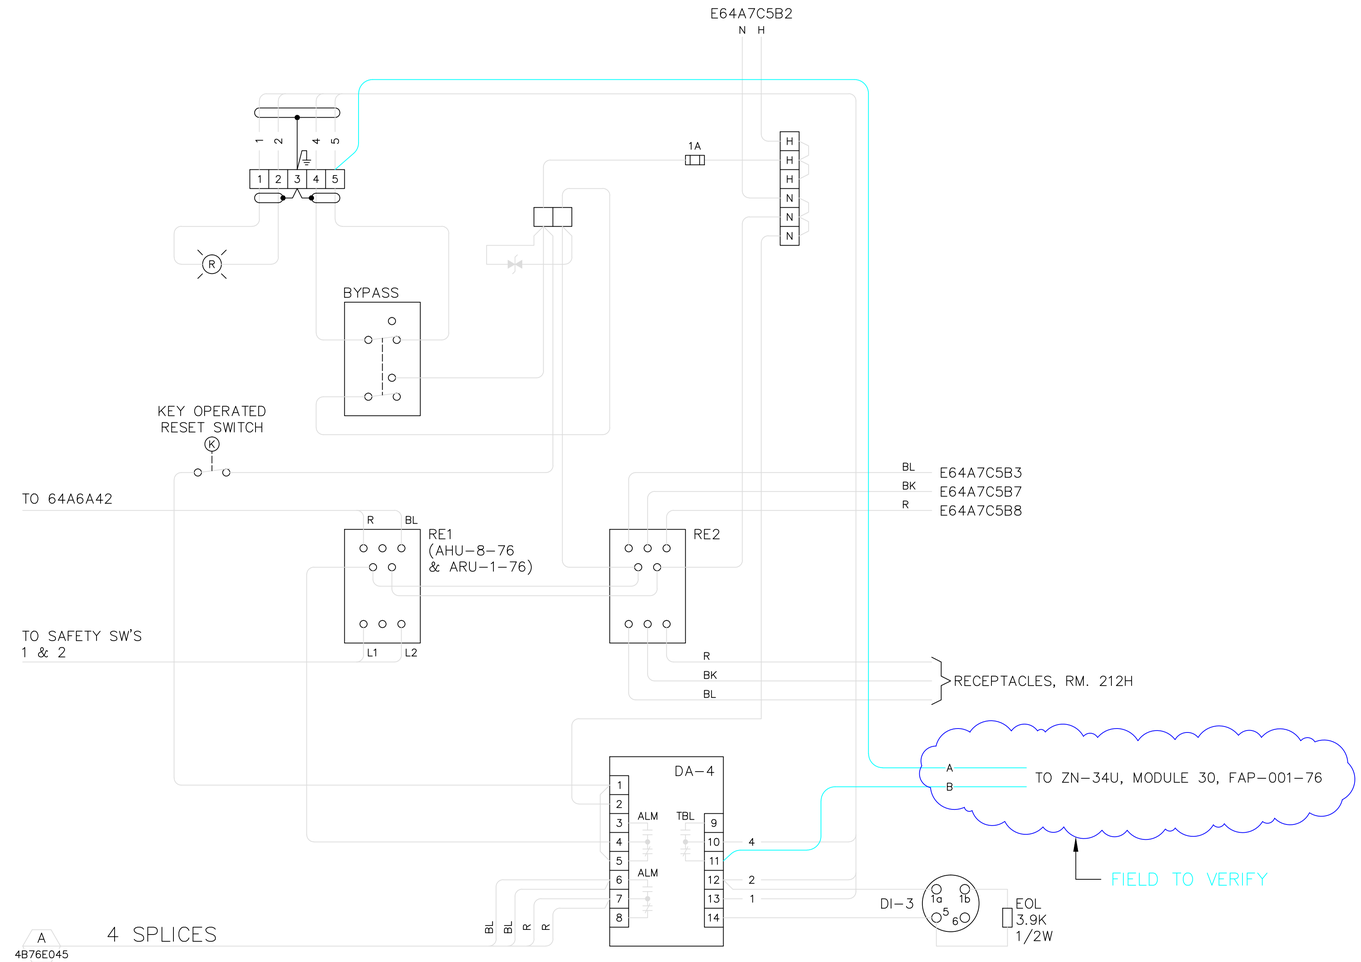

EMCS CONTROL ROOM FIRE DETECTION

NOTE: RE1 & RE2 ARE ARROW–HART AH30 13U1 CONTACTORS

REFERENCE DRAWINGS

4B76E010	INTERCONNECTION DIAGRAM
4B76E043	SYSTEM 3 INTERCONNECTION DIAGRAM
4B76E046	SYSTEM 3 INTERCONNECTION DIAGRAM

ASBUILT REVISION H 10/2/2003

REVISION NUMBER	DRAWN BY	CHECKED BY	APPR'D BY	DATE	REMARKS
H	AD	MCG	MCG	19/2/03	AS–BUILT, PHASE II FA UPGRADE
G	HYT	HYT	–	2/12/02	REPLACEMENT FIRE ALARM PROJECT
F	AD	MCG	MCG	06/29/01	AS BUILT
E	LSR		BHS	5/14/93	REDRAWN ON AUTOCAD AS BUILT

PROFESSIONAL SEAL (IF REVISION, APPLIES ONLY TO REVISED WORK)

ISSUE (PROGRESS, ESTIMATE, BID, CONSTRUCTION, CONFORMED, REVISION, RECORD)

76
FIRE ALARM SYSTEM
INTERCONNECTION DIAGRAM

UNIVERSITY OF CALIFORNIA
LAWRENCE BERKELEY NATIONAL LABORATORY
FACILITIES DIVISION

DRAWN BY G	DATE 3/13/1980	
CHECKED BY		
APPROVED BY TS	6/17/1980	
CAD FILE PATH 00016619		
SCALE FULL		
DRAWING NO. 4B76E006H	SHEET 1 OF 1	
PROJECT NO. FA8040		