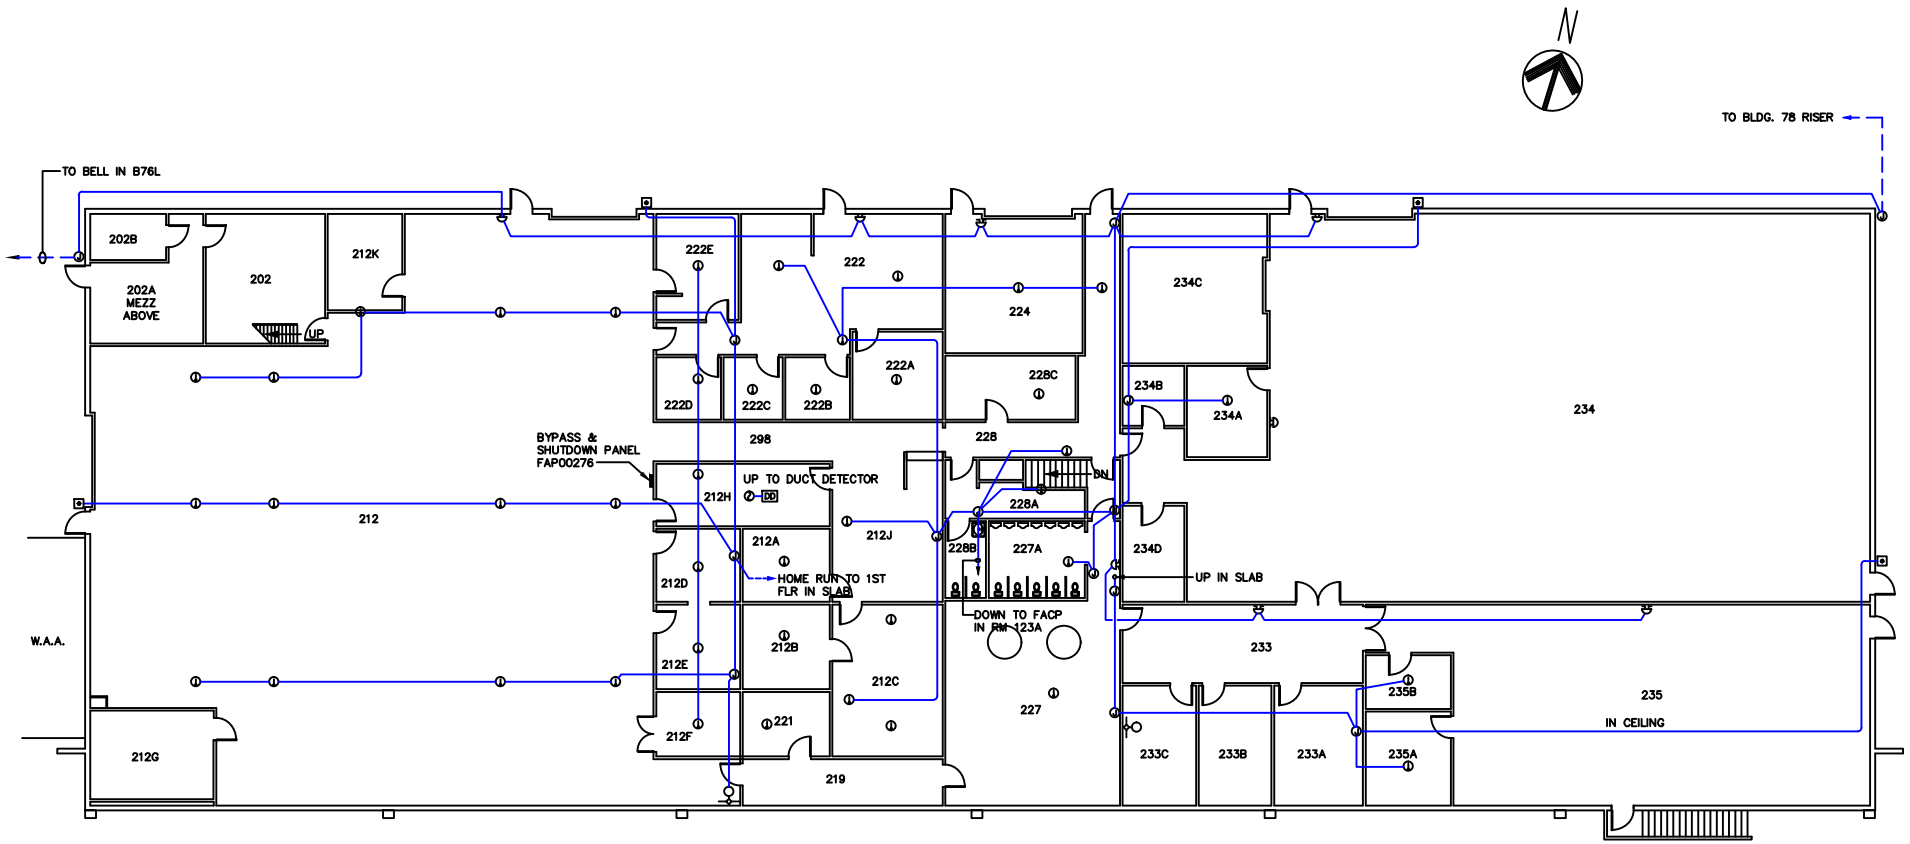

FIRE ALARM SYMBOLS

- MANUAL ALARM BOX (PULL STATION AND PULL BOX)
- HEAT DETECTOR (THERMAL DETECTOR)
- SMOKE DETECTOR
- FLOW DETECTOR/SWITCH
- BELL (GONG)

REVISION NUMBER	DRAWN BY	CHECKED BY	APPV'D BY	DATE	REMARKS
C	AD	MCG	MCG	4/29/01	AS BUILT
B	LM	MCG	MCG	8/25/98	CONSTRUCTION COMPLETE, FIELD TO VERIFY
A	TB	TB	RG	8/16/93	ADD B76L BELL

76
FIRE ALARM SYSTEM
2ND FLOOR PLAN

UNIVERSITY OF CALIFORNIA
LAWRENCE BERKELEY NATIONAL LABORATORY
FACILITIES DEPARTMENT

DRAWN BY	TPB	DATE 06/11/93
CHECKED BY	TPB	06/11/93
APPROVED BY	RMG	06/22/93
CAD FILE PATH	00012530	
SCALE	1/8=1-0	
DRAWING NO.	4B76E017C	SHEET 1 OF 1
PROJECT NO.	FA8040	