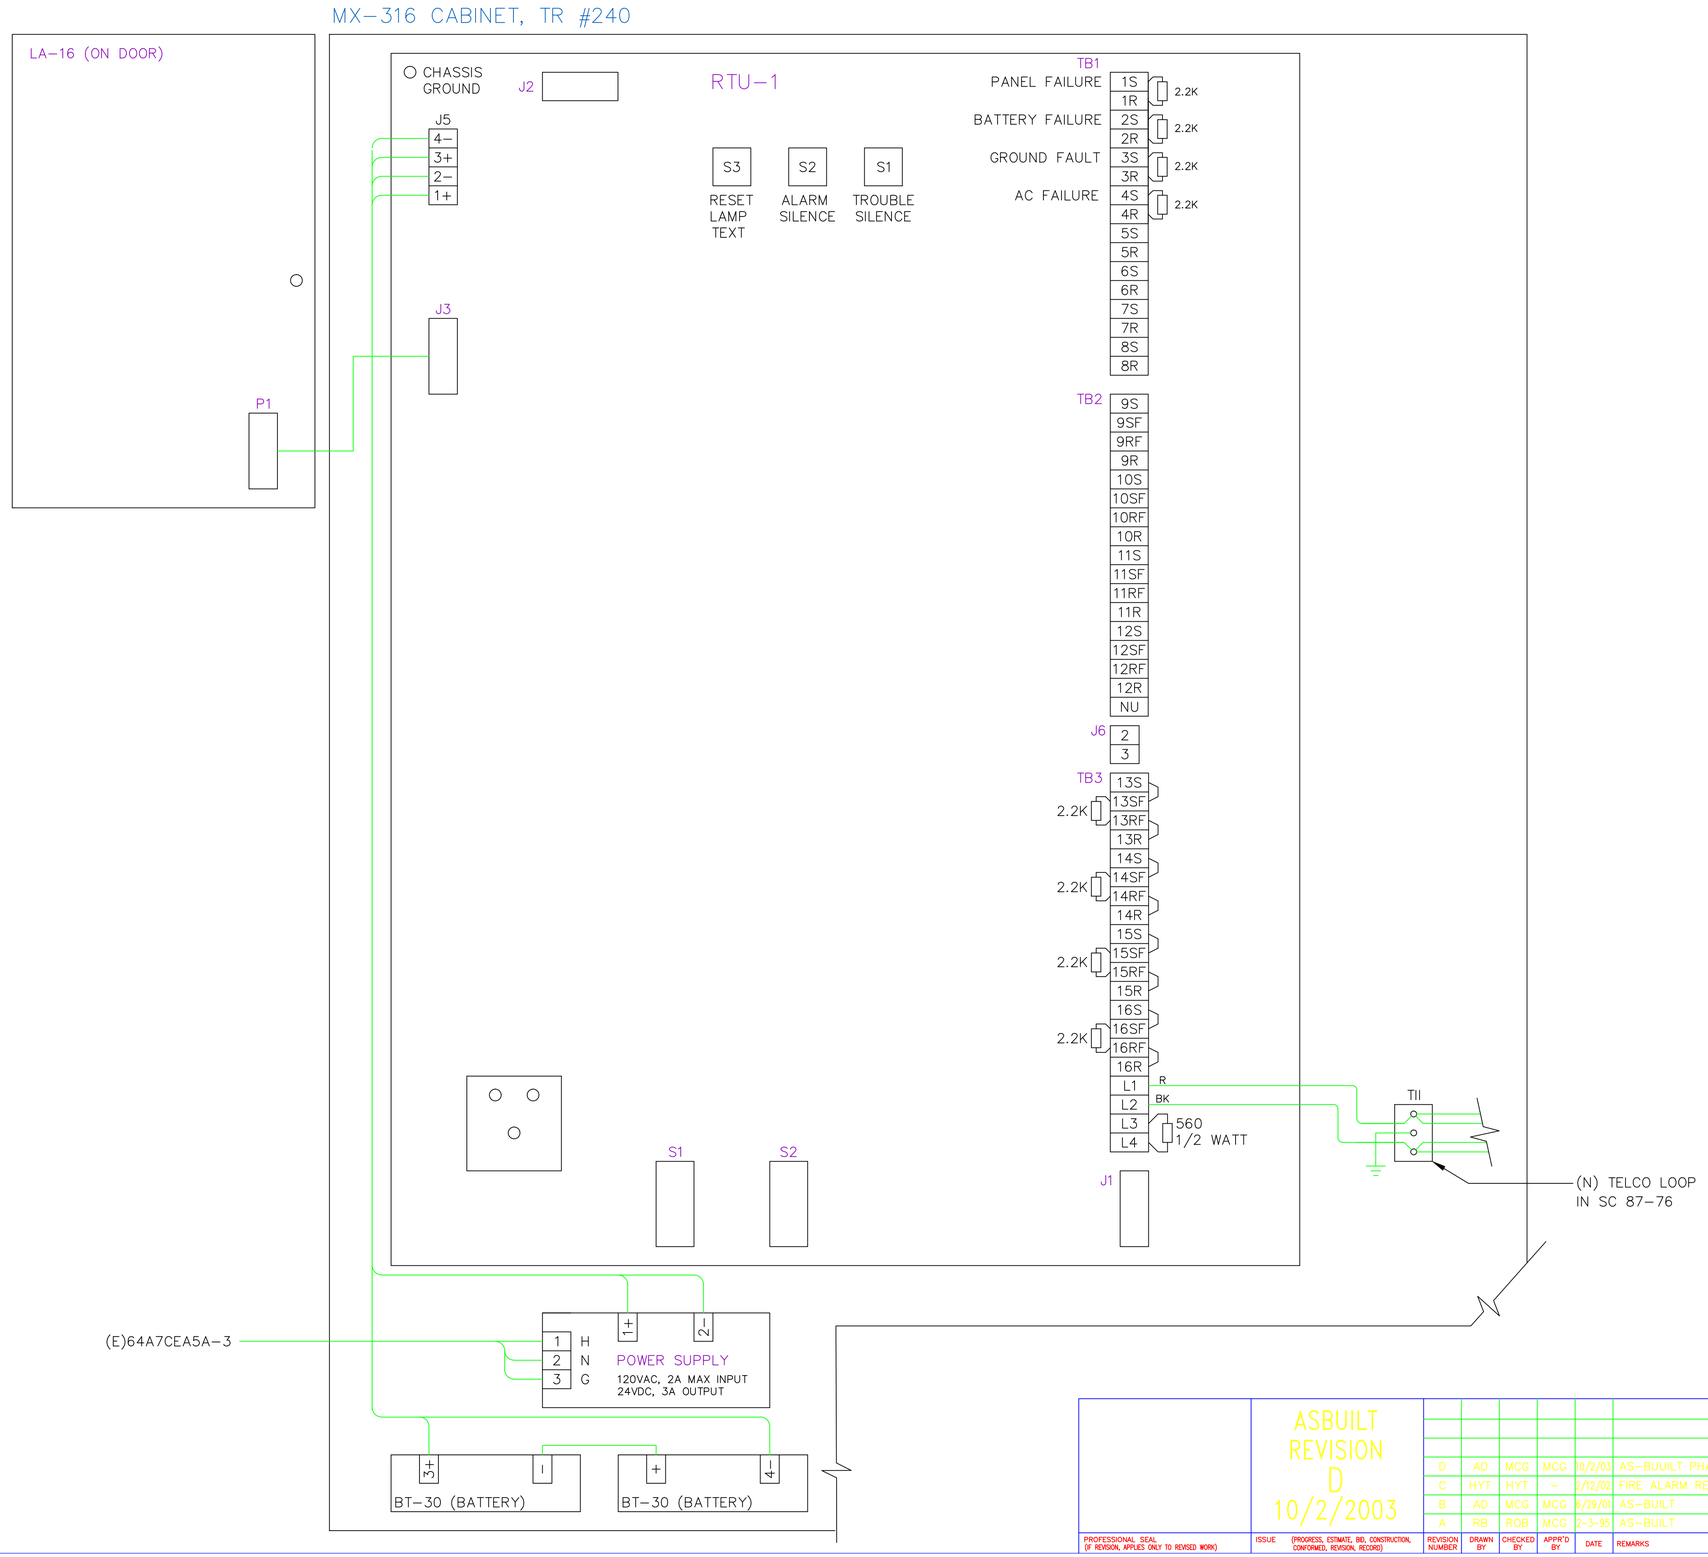

REFERENCE DRAWINGS:

4B76E046 LOGIC DIAGRAM

ASBUILT REVISION D 10/2/2003

REVISION NUMBER	DRAWN BY	CHECKED BY	APPR'D BY	DATE	REMARKS
D	AD	MCG	MCG	10/2/03	AS-BUUILT PHASE II FA UPGRADE
C	HYT	HYT	–	2/12/02	FIRE ALARM REPLACEMENT PROJECT
B	AD	MCG	MCG	6/29/01	AS-BUILT
A	RB	ROB	MCG	2-3-95	AS-BUILT

PROFESSIONAL SEAL (IF REVISION, APPLIES ONLY TO REVISED WORK)

ISSUE (PROGRESS, ESTIMATE, BID, CONSTRUCTION, CONFORMED, REVISION, RECORD)

76 XMITTER 240

FIRE ALARM SYSTEM

MX-316 CONNECTIONS

UNIVERSITY OF CALIFORNIA
LAWRENCE BERKELEY NATIONAL LABORATORY
FACILITIES DIVISION

		DATE
DRAWN BY	ROB	12/21/1993
CHECKED BY	TPB	12/21/1993
APPROVED BY	MG	6/22/1993
CAD FILE PATH	00016617	
SCALE	As Noted	
DRAWING NO.	4B76E022D	SHEET 1 OF 1
PROJECT NO.	FA8040	