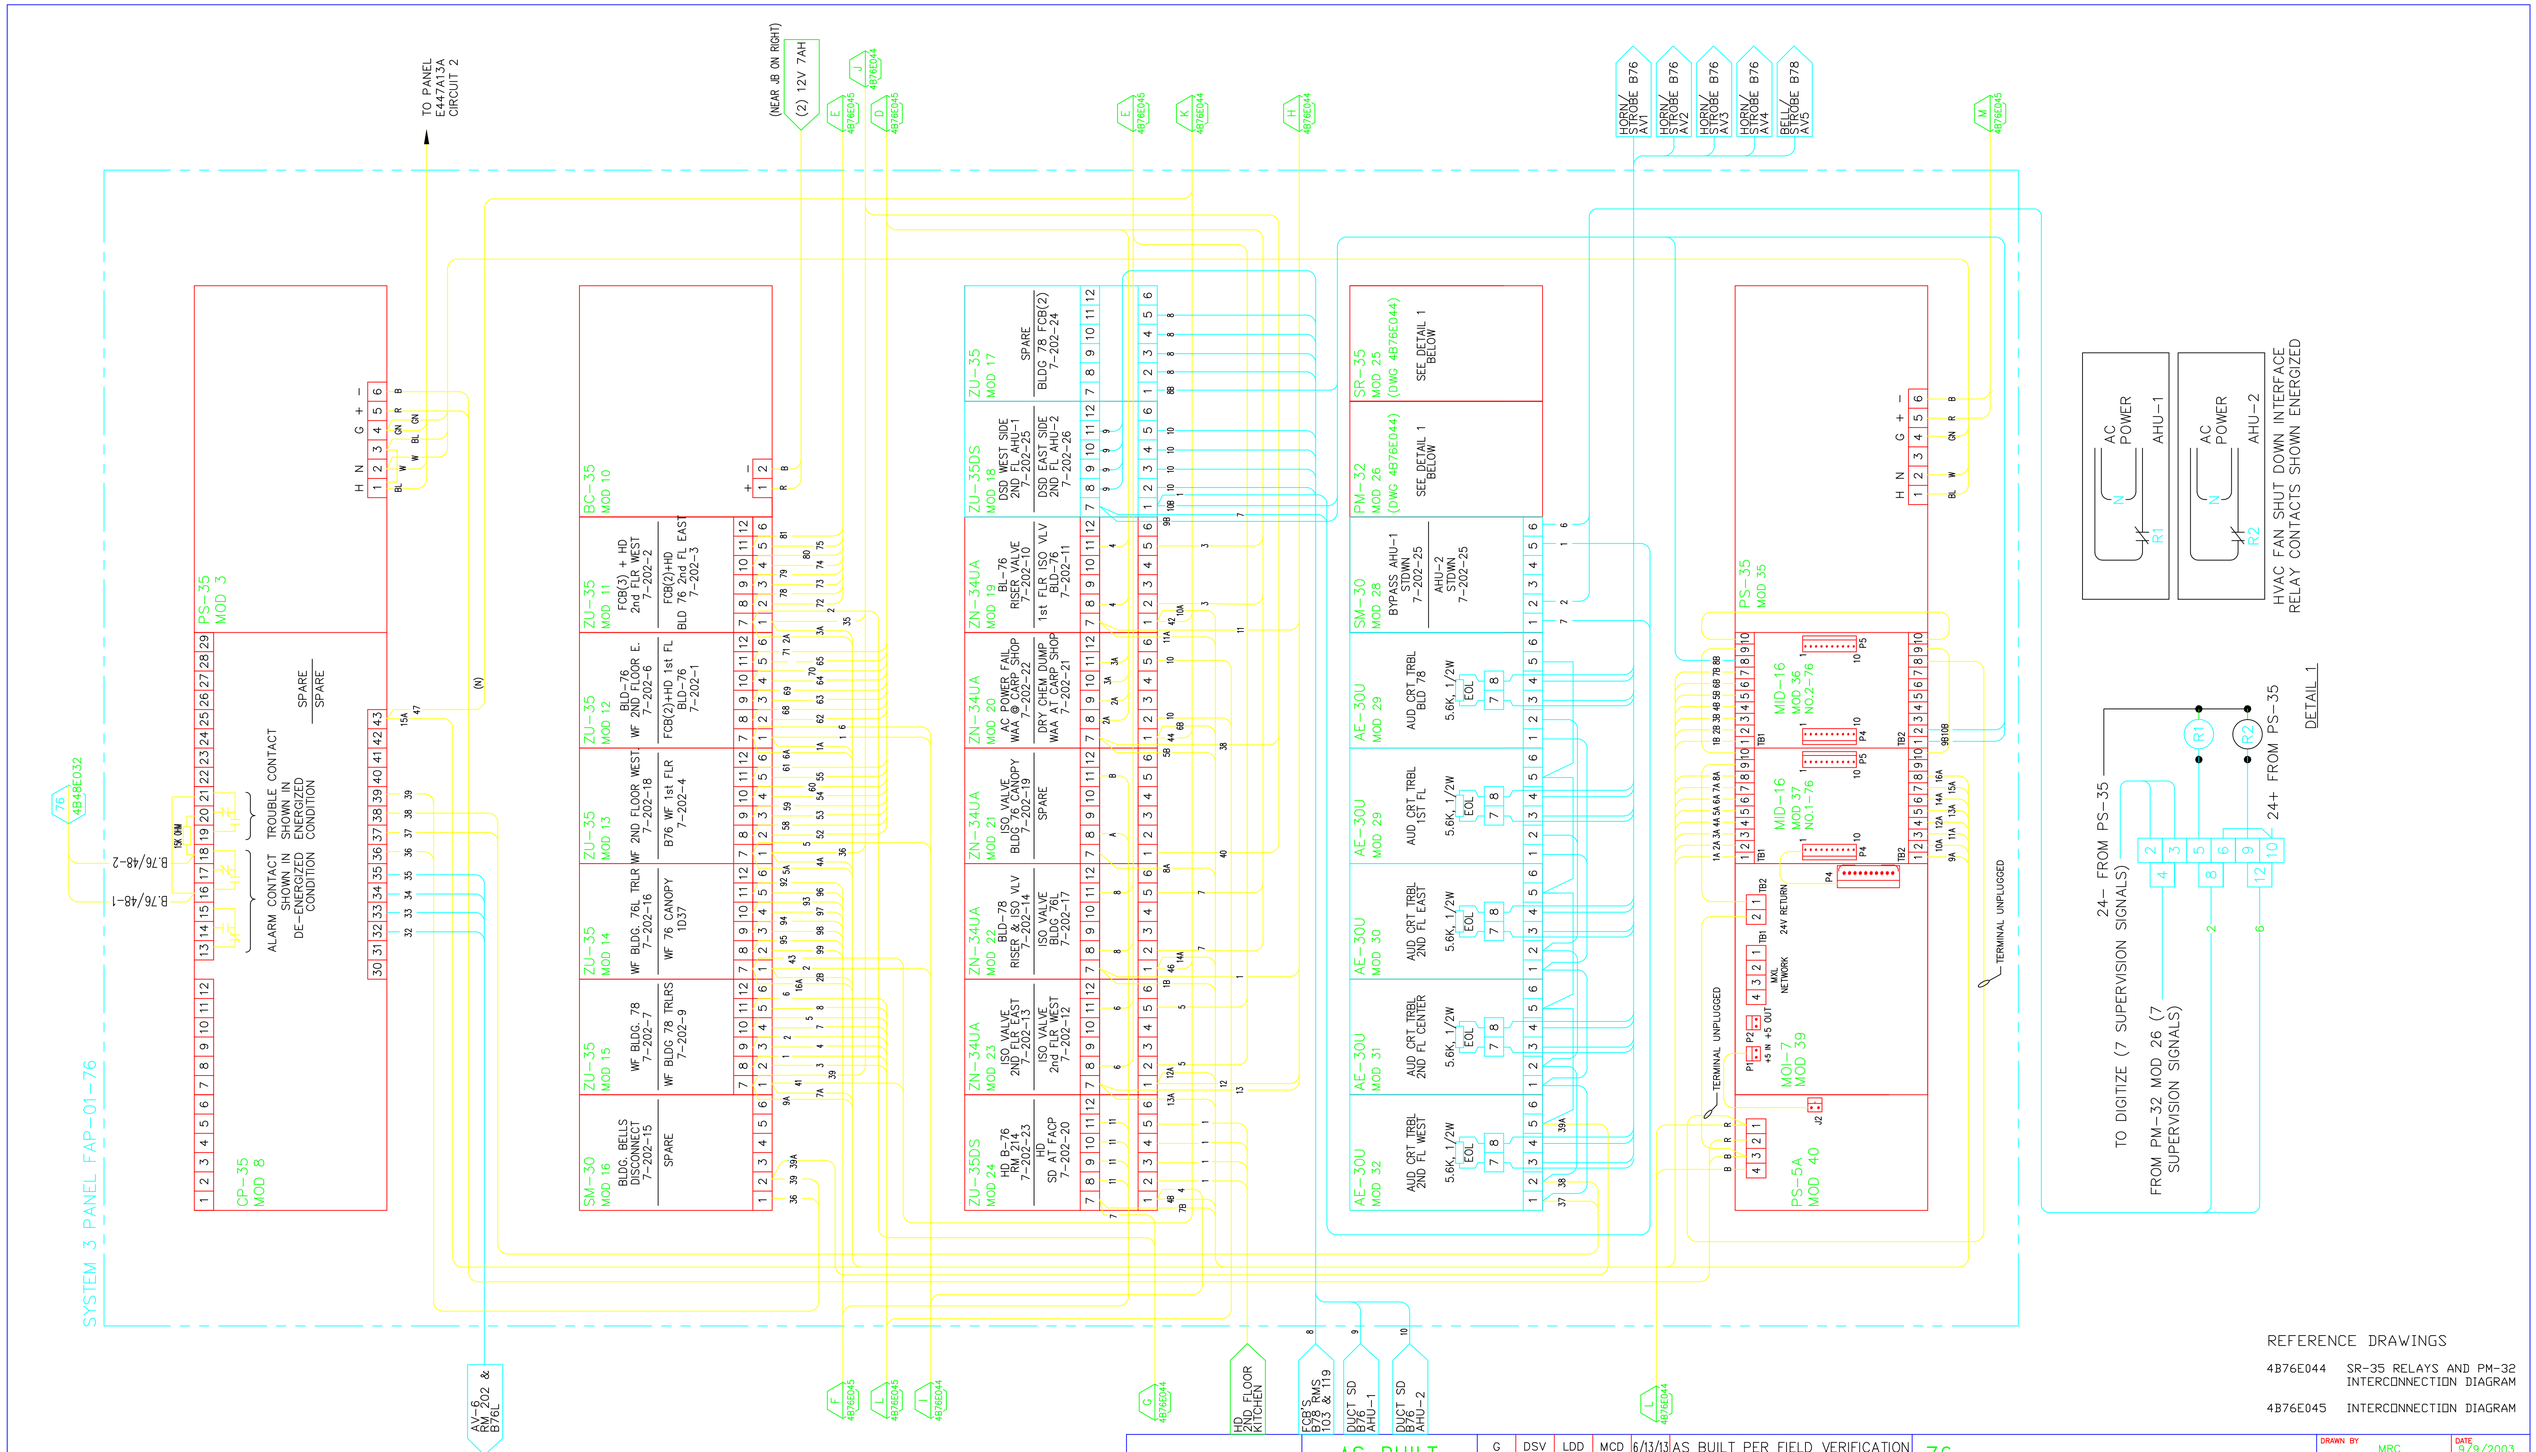

REFERENCE DRAWINGS

4B76E044 SR-35 RELAYS AND PM-32 INTERCONNECTION DIAGRAM

4B76E045 INTERCONNECTION DIAGRAM

REVISION NUMBER	DRAWN BY	CHECKED BY	APPR'D BY	DATE	REMARKS
G	DSV	LDD	MCD	6/13/13	AS BUILT PER FIELD VERIFICATION
F	HYT	HYT	–	06/05/09	RECORD DRAWING NOTIFIC APPL
E	HYT	HYT	–	01/23/09	NOTIFICATION APPLIANCES
D	HYT	HYT	–	03/5/08	SHOP RELOCATION PROJECT
C	HYT	HYT	–	01/24/08	SHOP RELOCATION PROJECT
B	AD	MCG	MCG	04/26/05	REVISED FOR MXL/DIGITIZE SYSTEMS
A	AD	MCG	MCG	10/2/03	AS-BUILT, PHASE II FA UPGRADE

PROFESSIONAL SEAL (IF REVISION, APPLIES ONLY TO REVISED WORK)

ISSUE (PROGRESS, ESTIMATE, BID, CONSTRUCTION, CONFORMED, REVISION, RECORD)

AS BUILT
G
6/13/13

76
SYSTEM 3 PANEL FAP-01-76
INTERCONECTION DIAGRAM

UNIVERSITY OF CALIFORNIA
LAWRENCE BERKELEY NATIONAL LABORATORY
FACILITIES DIVISION

DRAWN BY MRC	DATE 9/9/2003	
CHECKED BY MCG	9/9/2003	
APPROVED BY MCG	9/9/2003	
CAD FILE PATH		
SCALE As Noted		
DRAWING NO. 4B76E043G	SHEET FA0.2	
PROJECT NO. FP8200	1 OF 1	