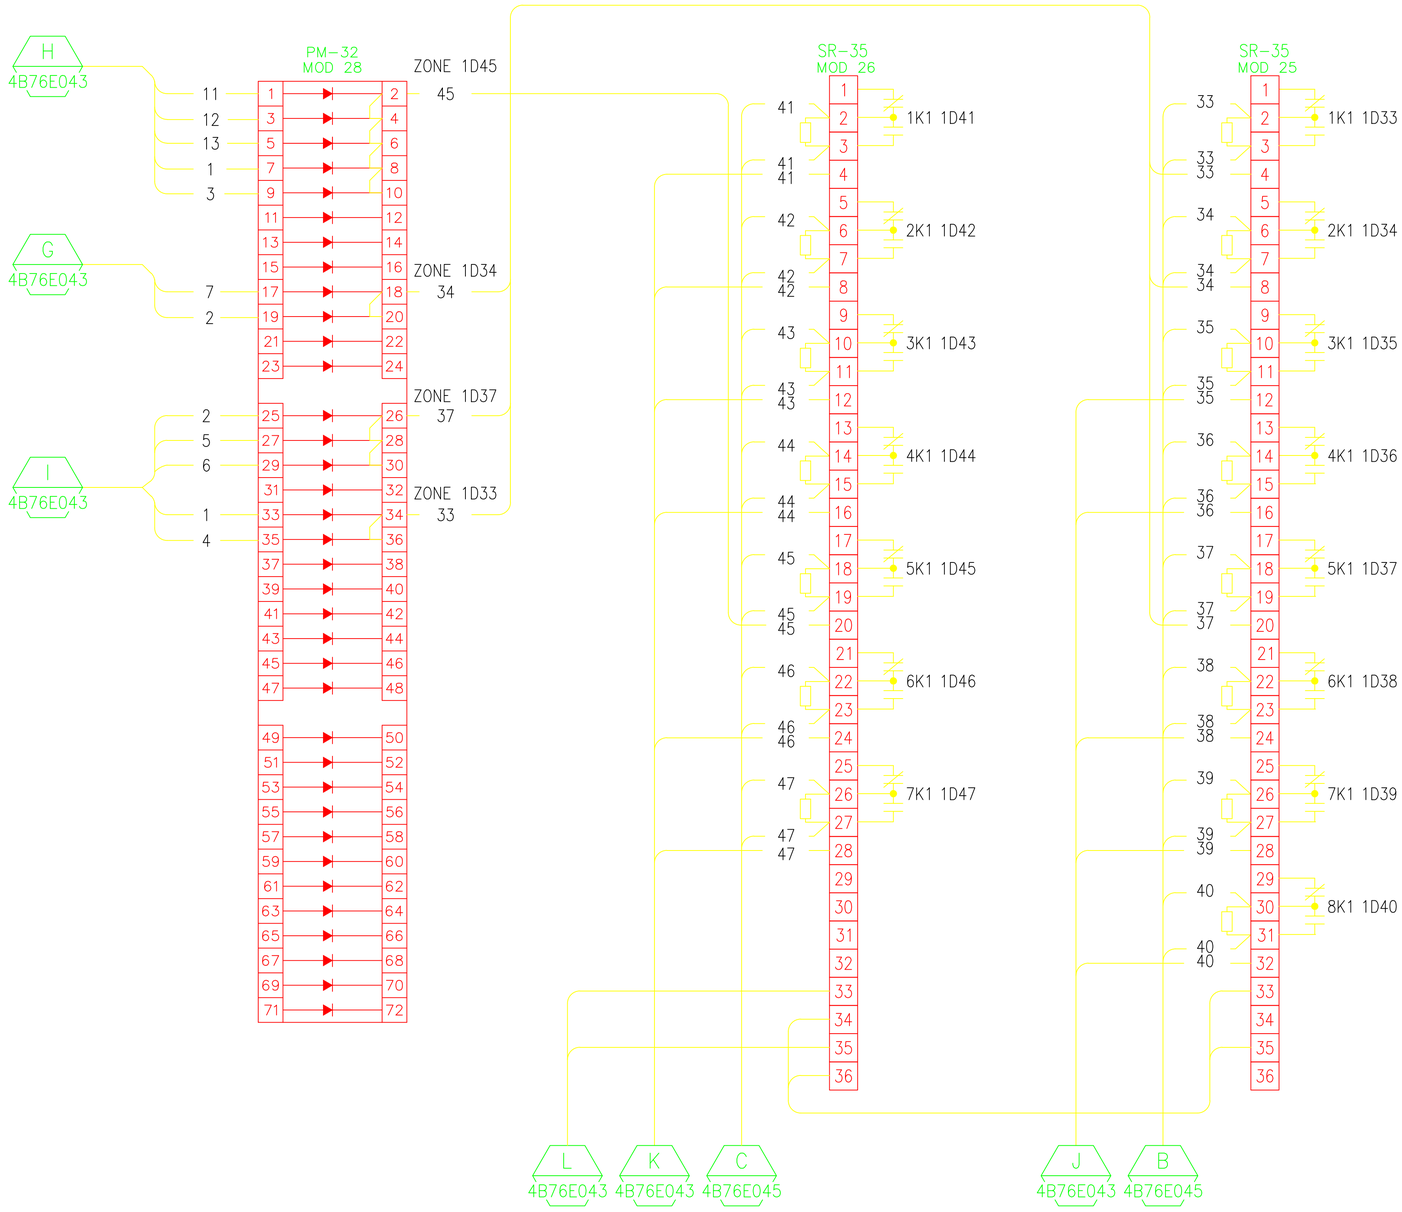

REFERENCE DRAWINGS

4B76E043	INTERCONNECTION DIAGRAM
4B76E045	INTERCONNECTION DIAGRAM
4B76E046	LOGIC DIAGRAM

AS BUILT

C
3/6/2008

REVISION NUMBER	DRAWN BY	CHECKED BY	APPR'D BY	DATE	REMARKS
C				03/06/08	AS BUILT
B	AD	MCG	MCG	04/27/05	REVISED FOR MXL/DIGITIZE SYSTEM
A	AD	MCG	MCG	10/02/03	AS-BUILT, PHASE II FA UPGRADE

PROFESSIONAL SEAL (IF REVISION, APPLIES ONLY TO REVISED WORK)

ISSUE (PROGRESS, ESTIMATE, BID, CONSTRUCTION, CONFORMED, REVISION, RECORD)

76 FIRE ALARM
SR-35 RELAYS AND PM-32
CONNECTION DIAGRAM

UNIVERSITY OF CALIFORNIA
LAWRENCE BERKELEY NATIONAL LABORATORY
FACILITIES DIVISION

DRAWN BY	MRC	DATE 7/17/2003
CHECKED BY	MCG	7/17/2003
APPROVED BY	MCG	7/17/2003
CAD FILE PATH	00019341	
SCALE	As Noted	
DRAWING NO.	4B76E044C	SHEET 1 OF 1
PROJECT NO.	FP8200	