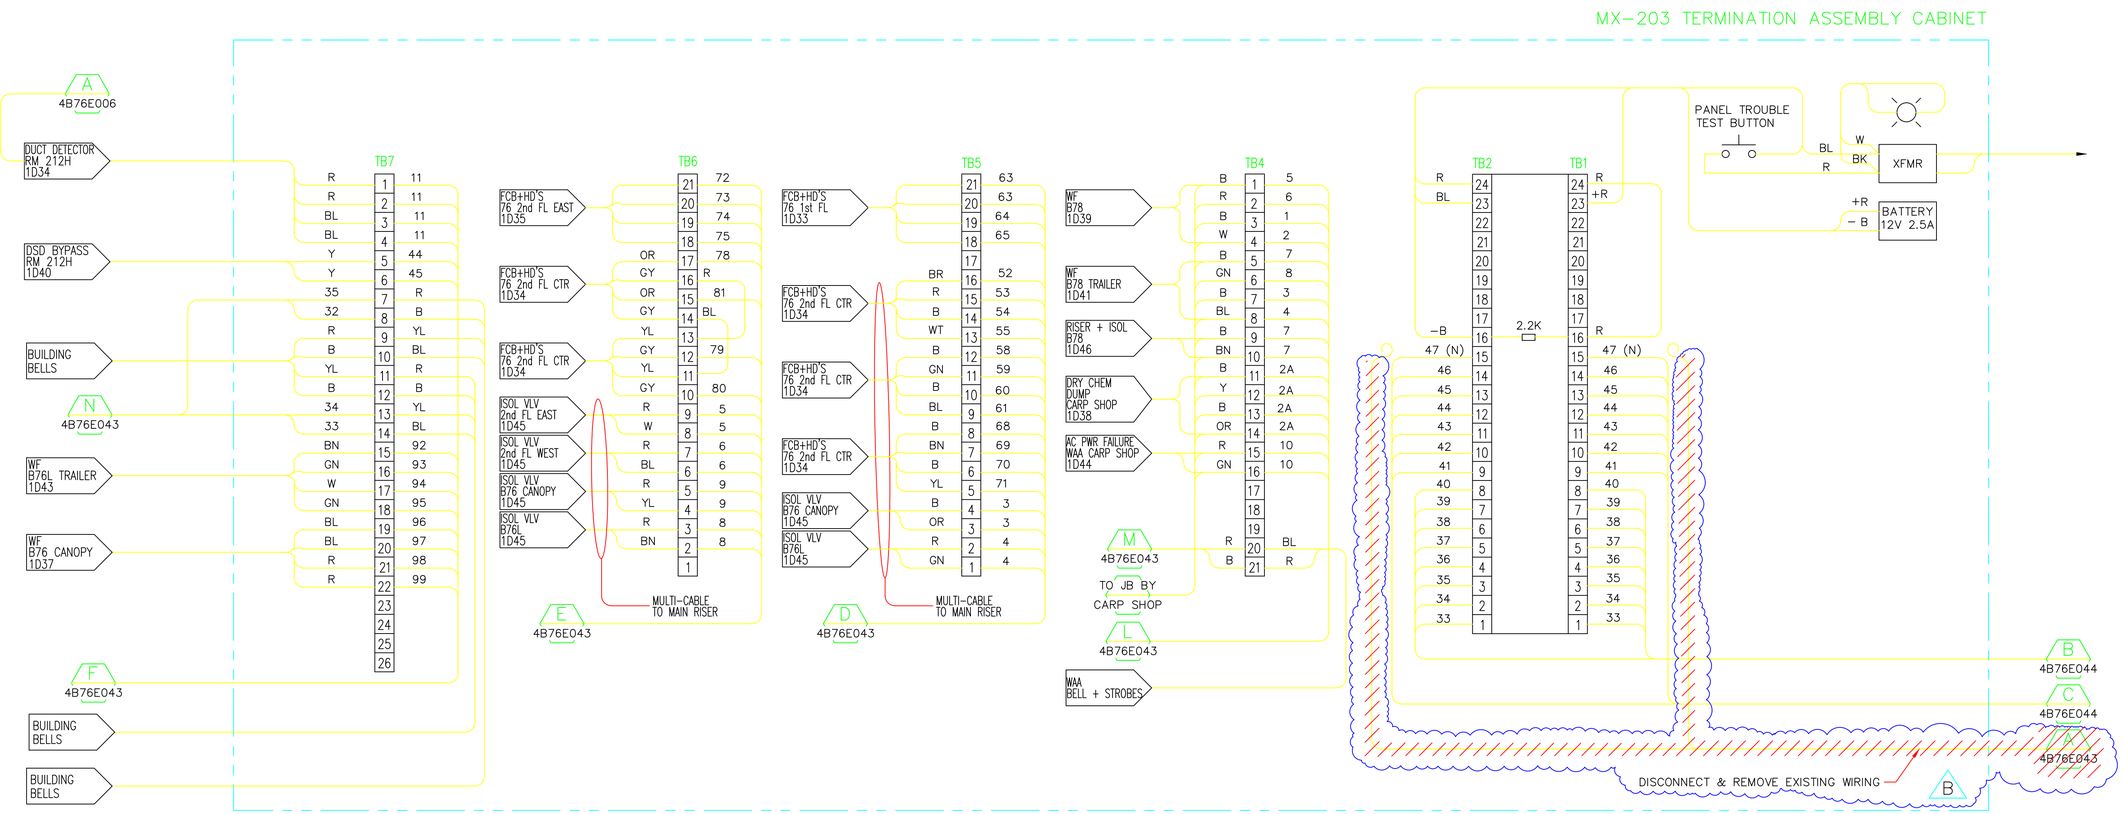

REFERENCE DRAWINGS

4B76E043 INTERCONNECTION DIAGRAM
4B76E006 INTERCONNECTION DIAGRAM

PROFESSIONAL SEAL (IF REVISION, APPLIES ONLY TO REVISED WORK)	ISSUE (PROGRESS, ESTIMATE, BID, CONSTRUCTION, CONFORMED, REVISION, RECORD)	REVISION NUMBER	DRAWN BY	CHECKED BY	APPR'D BY	DATE	REMARKS
	TITLE 2 CONSTRUCTION B 4/27/2005	B	AD	MCG	MCG	04/27/05	REVISED FOR MXL/DIGITIZE SYSTEMS
		A	AD	MCG	MCG	10/02/03	AS-BUILT, PHASE II FA UPGRADE

76 FIRE ALARM
MX-203 TERMINATION ASSEMBLY CABINET
CONNECTION DIAGRAM

UNIVERSITY OF CALIFORNIA
LAWRENCE BERKELEY NATIONAL LABORATORY
FACILITIES DIVISION

DRAWN BY	MRC	DATE 7/17/2003
CHECKED BY	MCG	7/17/2003
APPROVED BY	MCG	7/17/2003
CAD FILE PATH	00019339	
SCALE	As Noted	
DRAWING NO.	4B76E045B	SHEET 1 OF 1
PROJECT NO.	FA8040	