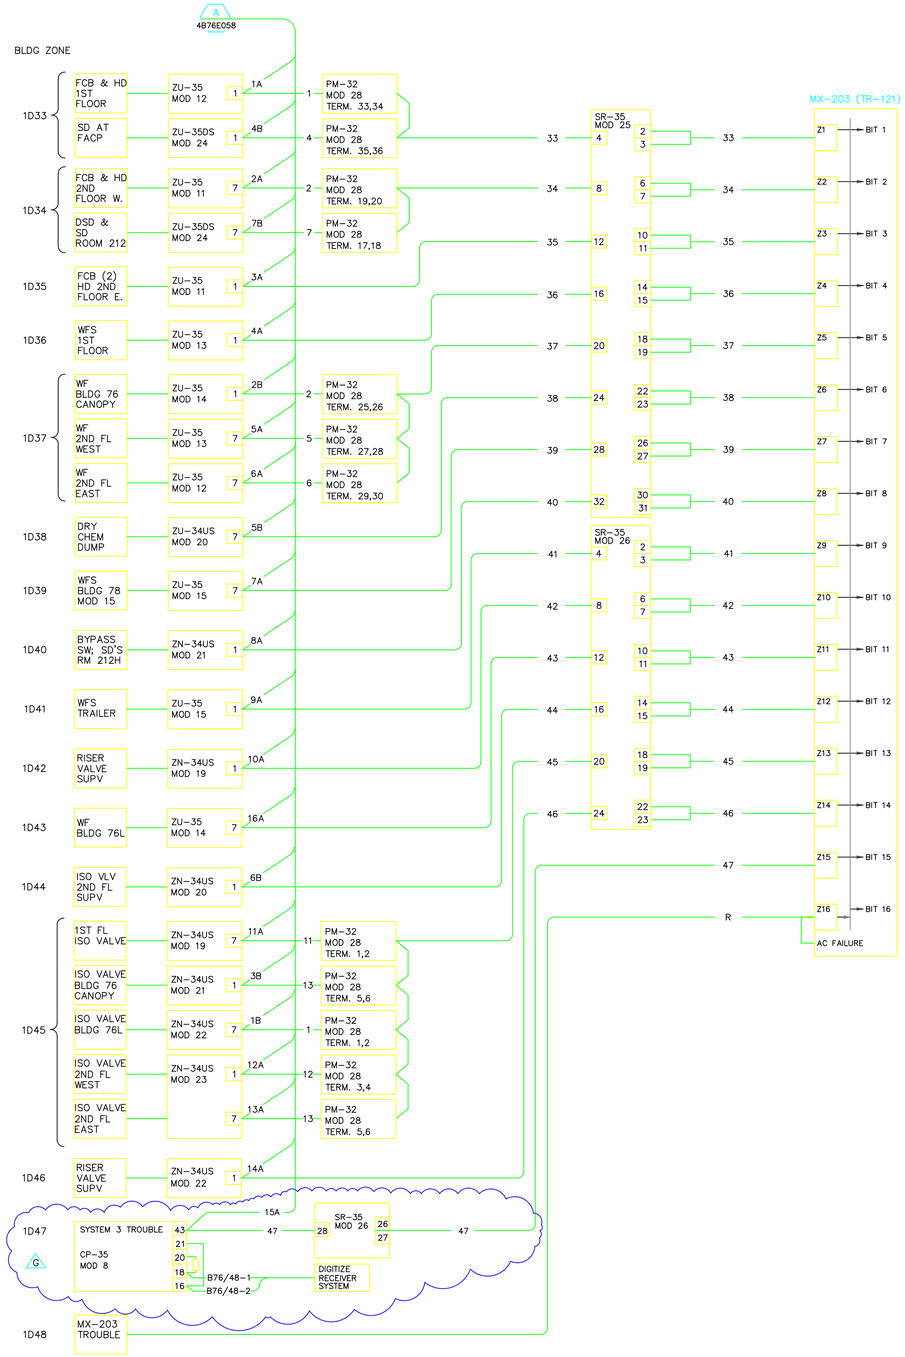

REFERENCE DRAWINGS

4B76E058	DEVICE FIELD CONNECTIVITY
4B76E044	SR-35 RELAYS AND PM-32 INTERCONNECTION DIAGRAM
4B76E045	INTERCONNECTION DIAGRAM

REVISION NUMBER	DRAWN BY	CHECKED BY	APPR'D BY	DATE	REMARKS
B	AD	MCG	MCG	04/26/05	REVISED FOR MXL/DIGITIZE SYSTEMS
A	AD	MCG	MCG	10/02/03	AS-BUILT, PHASE II FA UPGRADE

PROFESSIONAL SEAL (IF REVISION, APPLIES ONLY TO REVISED WORK)

ISSUE (PROGRESS, ESTIMATE, BID, CONSTRUCTION, CONFORMED, REVISION, RECORD)

TITLE 2
CONSTRUCTION
B
4/26/2005

76
FIRE ALARM SYSTEM
LOGIC DIAGRAM

UNIVERSITY OF CALIFORNIA
LAWRENCE BERKELEY NATIONAL LABORATORY
FACILITIES DIVISION

DRAWN BY	HYT	DATE	2/12/2003
CHECKED BY	HYT		2/12/2003
APPROVED BY			
CAD FILE PATH	00019334		
SCALE	As Noted		
DRAWING NO.	4B76E046B	SHEET	1 OF 1
PROJECT NO.	FA8040		