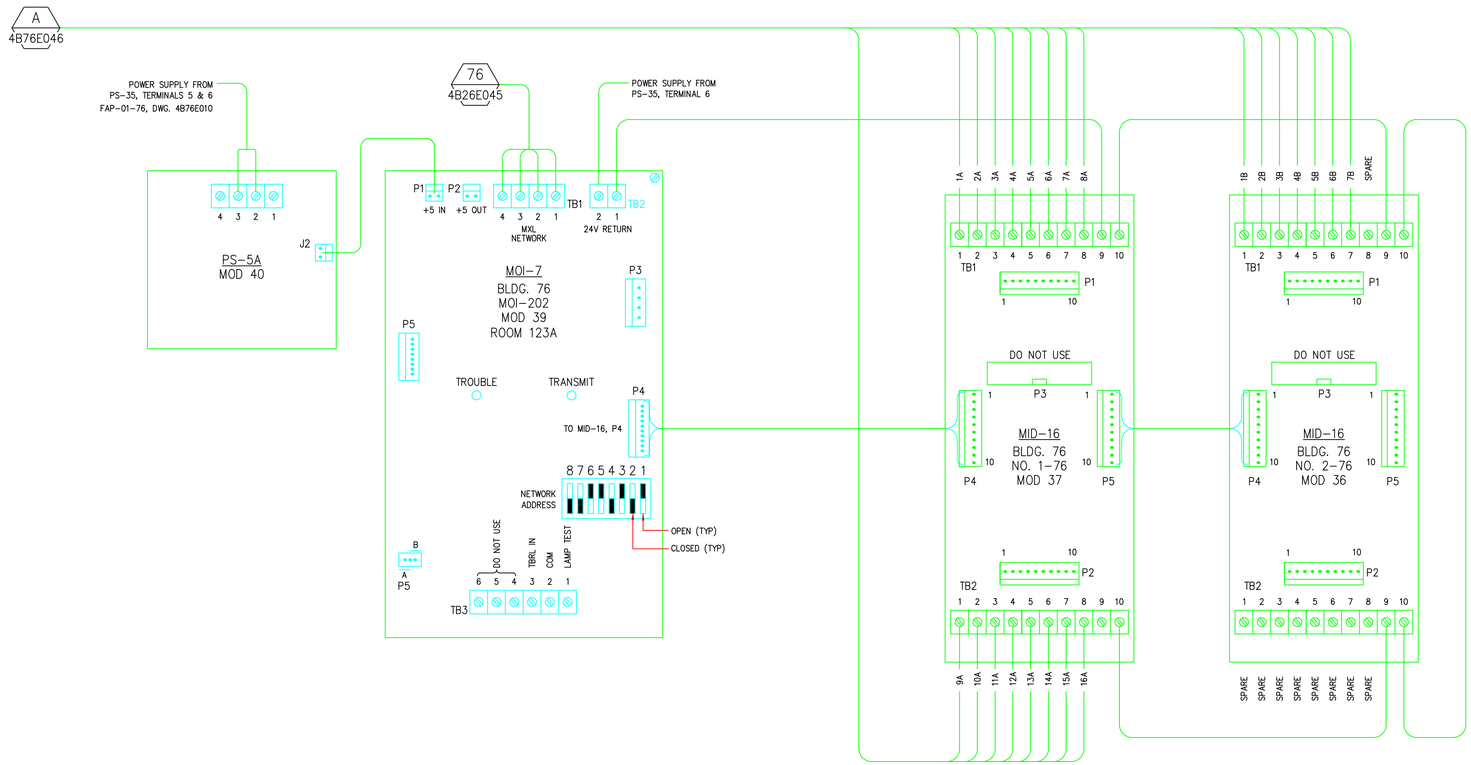

OLD ADDRESS	DESCRIPTION	MID-16 TERMINATION	MODULE TYPE & NO.	MXL NO. 7 AT B. 26 ADDRESS
1D33	FCB, HD 1ST FLOOR, & FACP SD	TB. 1 NO. 1	MID-16 NO. 1-76	7-202-1
1D34	FCB (3) & HD 2ND FLOOR WEST	TB. 1 NO. 2	MID-16 NO. 1-76	7-202-2
1D35	FCB (2) & HD 2ND FLOOR EAST	TB. 1 NO. 3	MID-16 NO. 1-76	7-202-3
1D36	WFS 1ST FLOOR	TB. 1 NO. 4	MID-16 NO. 1-76	7-202-4
1D37	WFS 2ND FLOOR WEST	TB. 1 NO. 5	MID-16 NO. 1-76	7-202-18
1D38	WFS 2ND FLOOR EAST	TB. 1 NO. 6	MID-16 NO. 1-76	7-202-6
1D39	WFS BUILDING	TB. 1 NO. 7	MID-16 NO. 1-76	7-202-7
1D40	BYPASS SWITCH (SD RM 212H)	TB. 1 NO. 8	MID-16 NO. 1-76	7-202-8
1D41	WFS TRAILER B. 76K	TB. 2 NO. 1	MID-16 NO. 1-76	7-202-9
1D42	RISER VLV SUPERVISION	TB. 2 NO. 2	MID-16 NO. 1-76	7-202-10
1D43	WF BLDG 76L	TB. 2 NO. 8	MID-16 NO. 1-76	7-202-16
1D45	1ST FLOOR ISO VLV SUPV	TB. 2 NO. 3	MID-16 NO. 1-76	7-202-11
1D45	2ND FLOOR WEST ISO VLV SUPV	TB. 2 NO. 4	MID-16 NO. 1-76	7-202-12
1D45	2ND FLOOR EAST ISO VLV SUPV	TB. 2 NO. 5	MID-16 NO. 1-76	7-202-13
1D46	RISER & ISO VALVE SUPV	TB. 2 NO. 6	MID-16 NO. 1-76	7-202-14
1D47	SYSTEM 3 FAP TROUBLE	TB. 2 NO. 7	MID-16 NO. 1-76	7-202-15

OLD ADDRESS	DESCRIPTION	MID-16 TERMINATION	MODULE TYPE & NO.	MXL NO. 7 AT B. 26 ADDRESS
1D33	SMOKE DETECTOR AT FACP	TB. 1 NO. 4	MID-16 NO. 2-76	7-202-20
1D34	DSD & SD, ROOM 212	TB. 1 NO. 7	MID-16 NO. 2-76	
1D37	WF, BLDG 76 CANOPY	TB. 1 NO. 2	MID-16 NO. 2-76	
1D37	WF, BLDG 76 2ND FLOOR EAST	TB. 1 NO. 5	MID-16 NO. 2-76	
1D44	ISO VLV 2ND FLOOR SUPV	TB. 1 NO. 6	MID-16 NO. 2-76	
1D45	ISO VLV BLDG 76L	TB. 1 NO. 1	MID-16 NO. 2-76	7-202-17
1D45	ISO VLV BLDG 76 CANOPY	TB. 1 NO. 3	MID-16 NO. 2-76	7-202-19
		TB. 1 NO. 8	MID-16 NO. 2-76	
		TB. 2 NO. 1	MID-16 NO. 2-76	
		TB. 2 NO. 2	MID-16 NO. 2-76	
		TB. 2 NO. 3	MID-16 NO. 2-76	
		TB. 2 NO. 4	MID-16 NO. 2-76	
		TB. 2 NO. 5	MID-16 NO. 2-76	
		TB. 2 NO. 6	MID-16 NO. 2-76	
		TB. 2 NO. 7	MID-16 NO. 2-76	
		TB. 2 NO. 8	MID-16 NO. 2-76	

FIELD VERIFY

AS BUILT

F
6/13/13

PROFESSIONAL SEAL (IF REVISION, APPLIES ONLY TO REVISED WORK)

ISSUE (PROGRESS, ESTIMATE, BID, CONSTRUCTION, CONFORMED, REVISION, RECORD)

REVISION NUMBER	DRAWN BY	CHECKED BY	APPR'D BY	DATE	REMARKS
F	DSV	LDD	MCD	6/13/13	AS BUILT PER FIELD VERIFICATION
E				7/28/06	HYT PROGRESS
D	-	-	-	———	-
C	AD	LDD	MCD	06/06/06	REVISED FOR MXL COPPER LOOP
B	AD	MCG	MCG	04/27/05	REVISED FOR MXL/DIGITIZE SYSTEMS
A	AD	MCG	MCG	10/02/03	AS-BUILT, PHASE II FA UPGRADE

76
REPLACEMENT FIRE ALARM SYSTEM
MOI/MID MODULE ARRANGEMENT, LOOP 7

UNIVERSITY OF CALIFORNIA
LAWRENCE BERKELEY NATIONAL LABORATORY
FACILITIES DIVISION

DRAWN BY	HYT	DATE 2/12/2003
CHECKED BY	HYT	2/12/2003
APPROVED BY		
CAD FILE PATH		
SCALE	As Noted	
DRAWING NO.	4B76E058F	SHEET 1 OF 1
PROJECT NO.	FP8200	