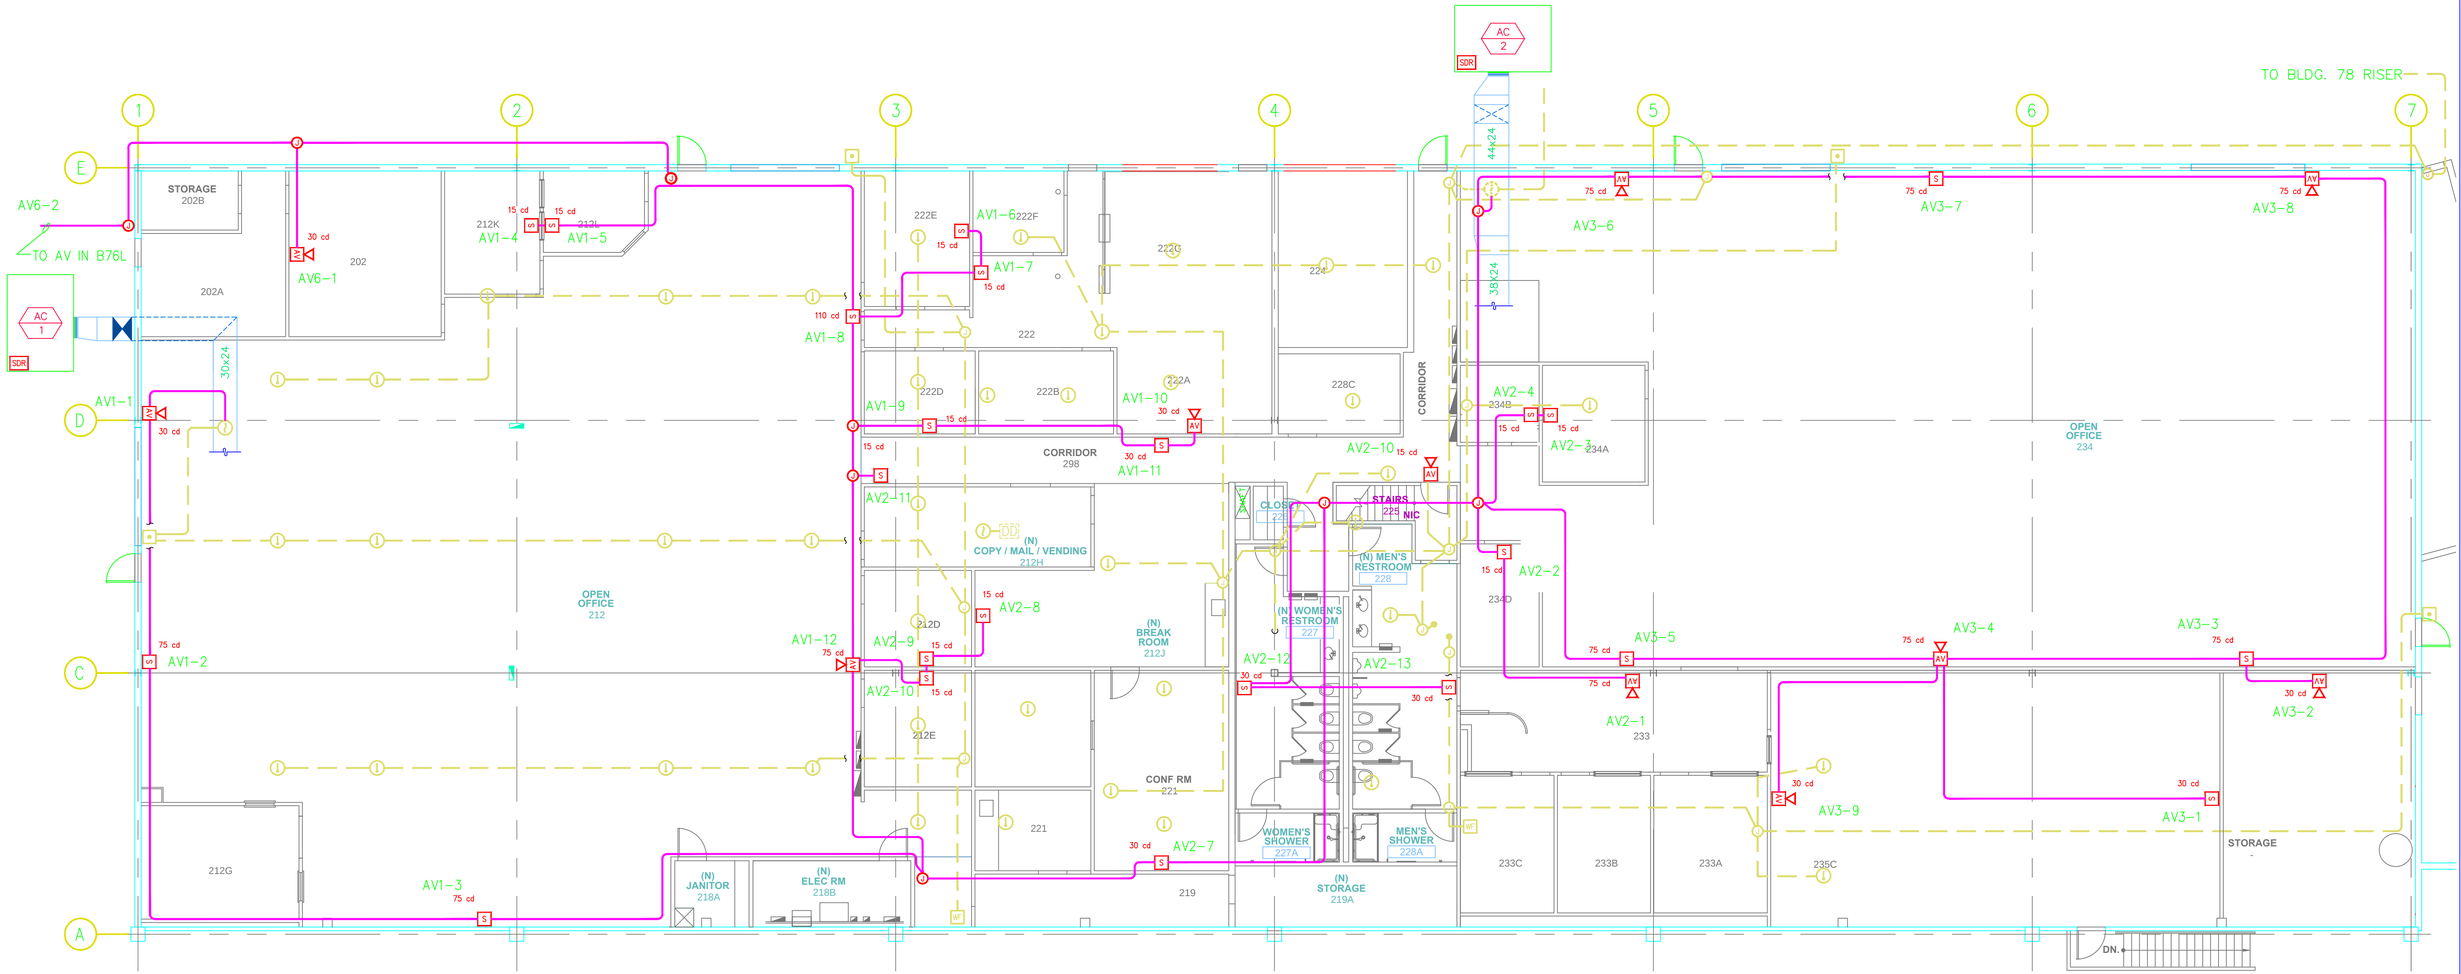

KEYPLAN–BUILDING 76

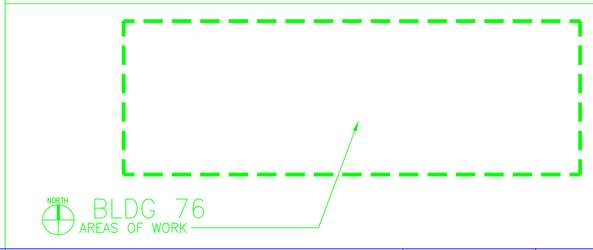

HYT Corporation
Fire Protection Engineers and Consultants
3498 Clayton Road - Suite 101 Concord, California 94519
Phone: (925) 681-2731 FAX: (925) 681-2733

RECORD DRAWING
06/08/09

REVISION NUMBER	DRAWN BY	CHECKED BY	APPR'D BY	DATE	REMARKS
B	HYT	HYT	NA	06/08/09	RECORD DRAWING NOTIFIC APPL
A	HYT	HYT	NA	01/23/09	NOTIFICATION APPLIANCES

76
2ND FLOOR PLAN
FIRE ALARM SYSTEM MODIFICATIONS

UNIVERSITY OF CALIFORNIA
LAWRENCE BERKELEY NATIONAL LABORATORY
FACILITIES DIVISION

DRAWN BY DWH	DATE 03/05/08
CHECKED BY BBT	03/05/08
APPROVED BY	
CAD FILE PATH 00023464	
SCALE As Noted	
DRAWING NO. 4B76E070B	SHEET FA1.1 OF
PROJECT NO. FP8200	

CONSULTING FIRM | CONSULTING FIRM | CONSULTING A/E FIRM | PROFESSIONAL SEAL (IF REVISION, APPLIES ONLY TO REVISED WORK) | ISSUE (PROGRESS, ESTIMATE, BID, CONSTRUCTION, CONFORMED, REVISION, AS-BUILT)