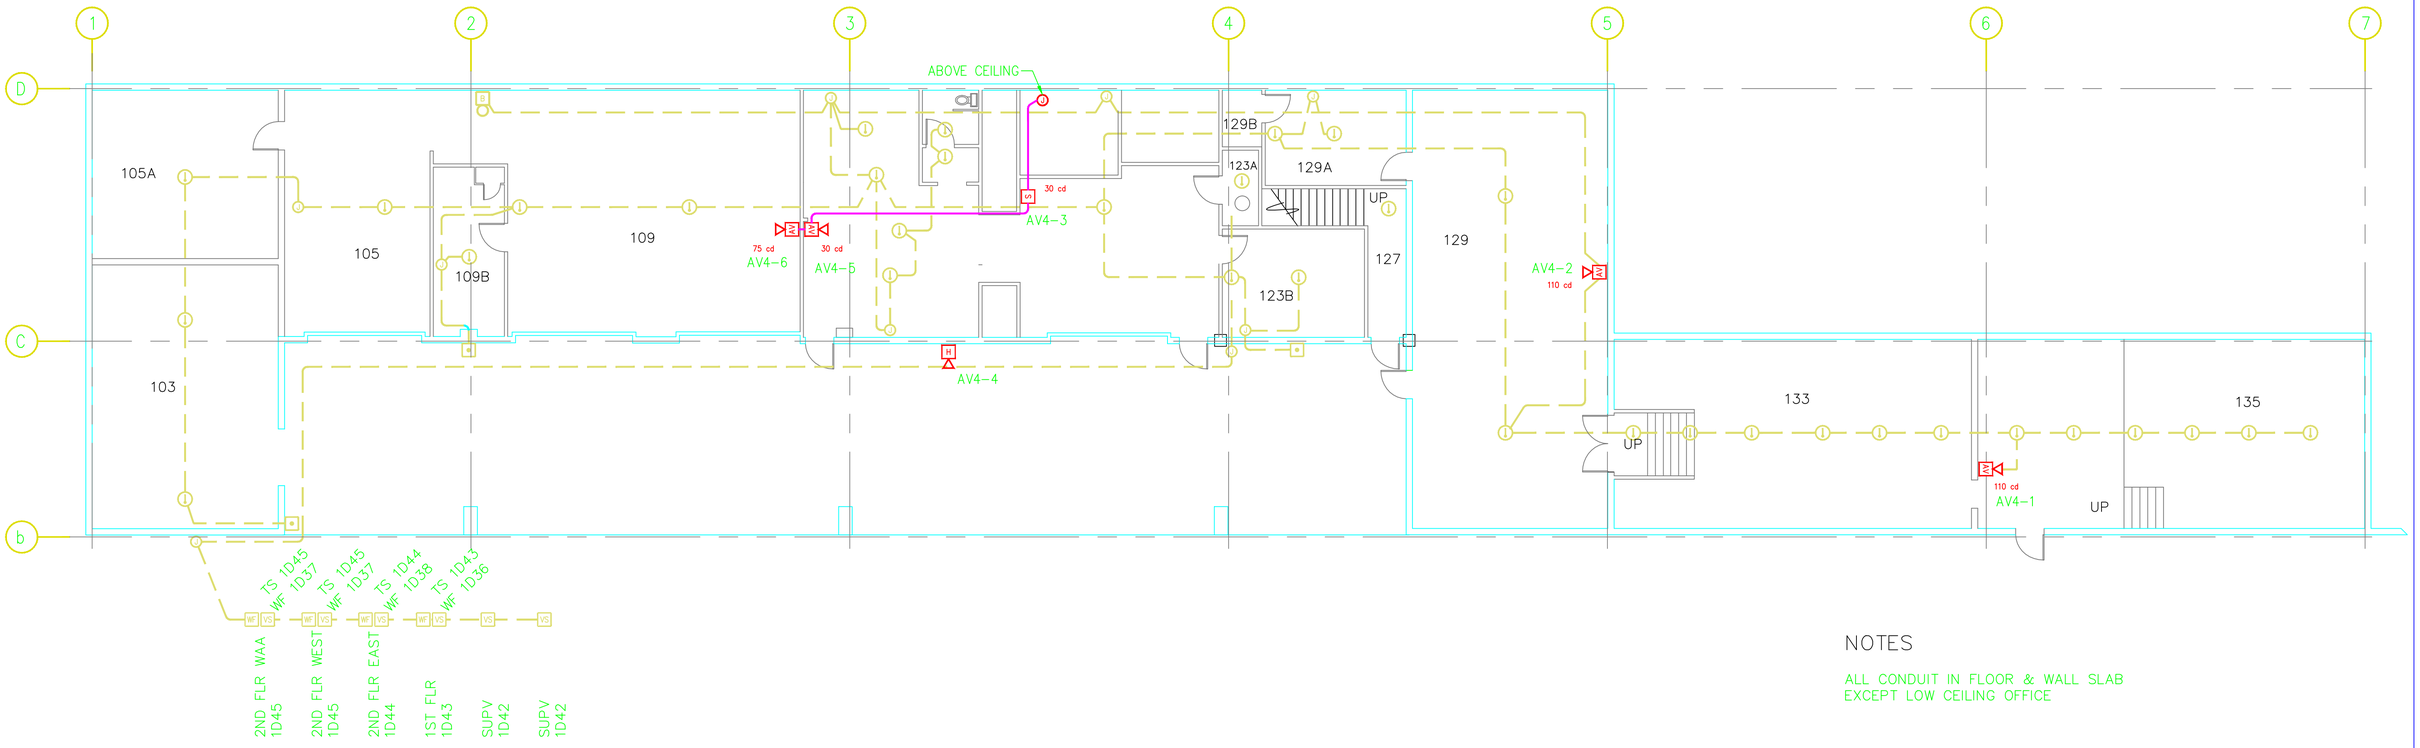

NOTES

ALL CONDUIT IN FLOOR & WALL SLAB
EXCEPT LOW CEILING OFFICE

8' 4' 0' 8' 16'
GRAPHIC SCALE: 1/8" = 1'-0"

PLAN NORTH

KEYPLAN-BUILDING 76

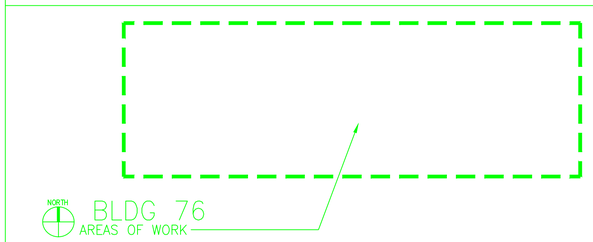

HYT Corporation
Fire Protection Engineers and Consultants
3498 Clayton Road - Suite 101 Concord, California 94519
Phone: (925) 681-2731 FAX: (925) 681-2733

CONSULTING FIRM | CONSULTING FIRM | CONSULTING A/E FIRM | PROFESSIONAL SEAL (IF REVISION, APPLIES ONLY TO REVISED WORK)

ISSUE: RECORD DRAWING 06/08/09 (PROGRESS, ESTIMATE, BID, CONSTRUCTION, CONFORMED, REVISION, AS-BUILT)

REVISION NUMBER	DRAWN BY	CHECKED BY	APPR'D BY	DATE	REMARKS
A	HYT	HYT	NA	06/08/09	RECORD DRAWING NOTIFIC APPL

76
1ST FLOOR PLAN
FIRE ALARM SYSTEM MODIFICATIONS

UNIVERSITY OF CALIFORNIA
LAWRENCE BERKELEY NATIONAL LABORATORY
BERKELEY LAB
FACILITIES DIVISION

DRAWN BY DWH	DATE 01/23/09	
CHECKED BY BBT	01/23/09	
APPROVED BY		
CAD FILE PATH 00023465		
SCALE As Noted		
DRAWING NO. 4B76E082A		SHEET FA1.2
PROJECT NO. FP8200		OF