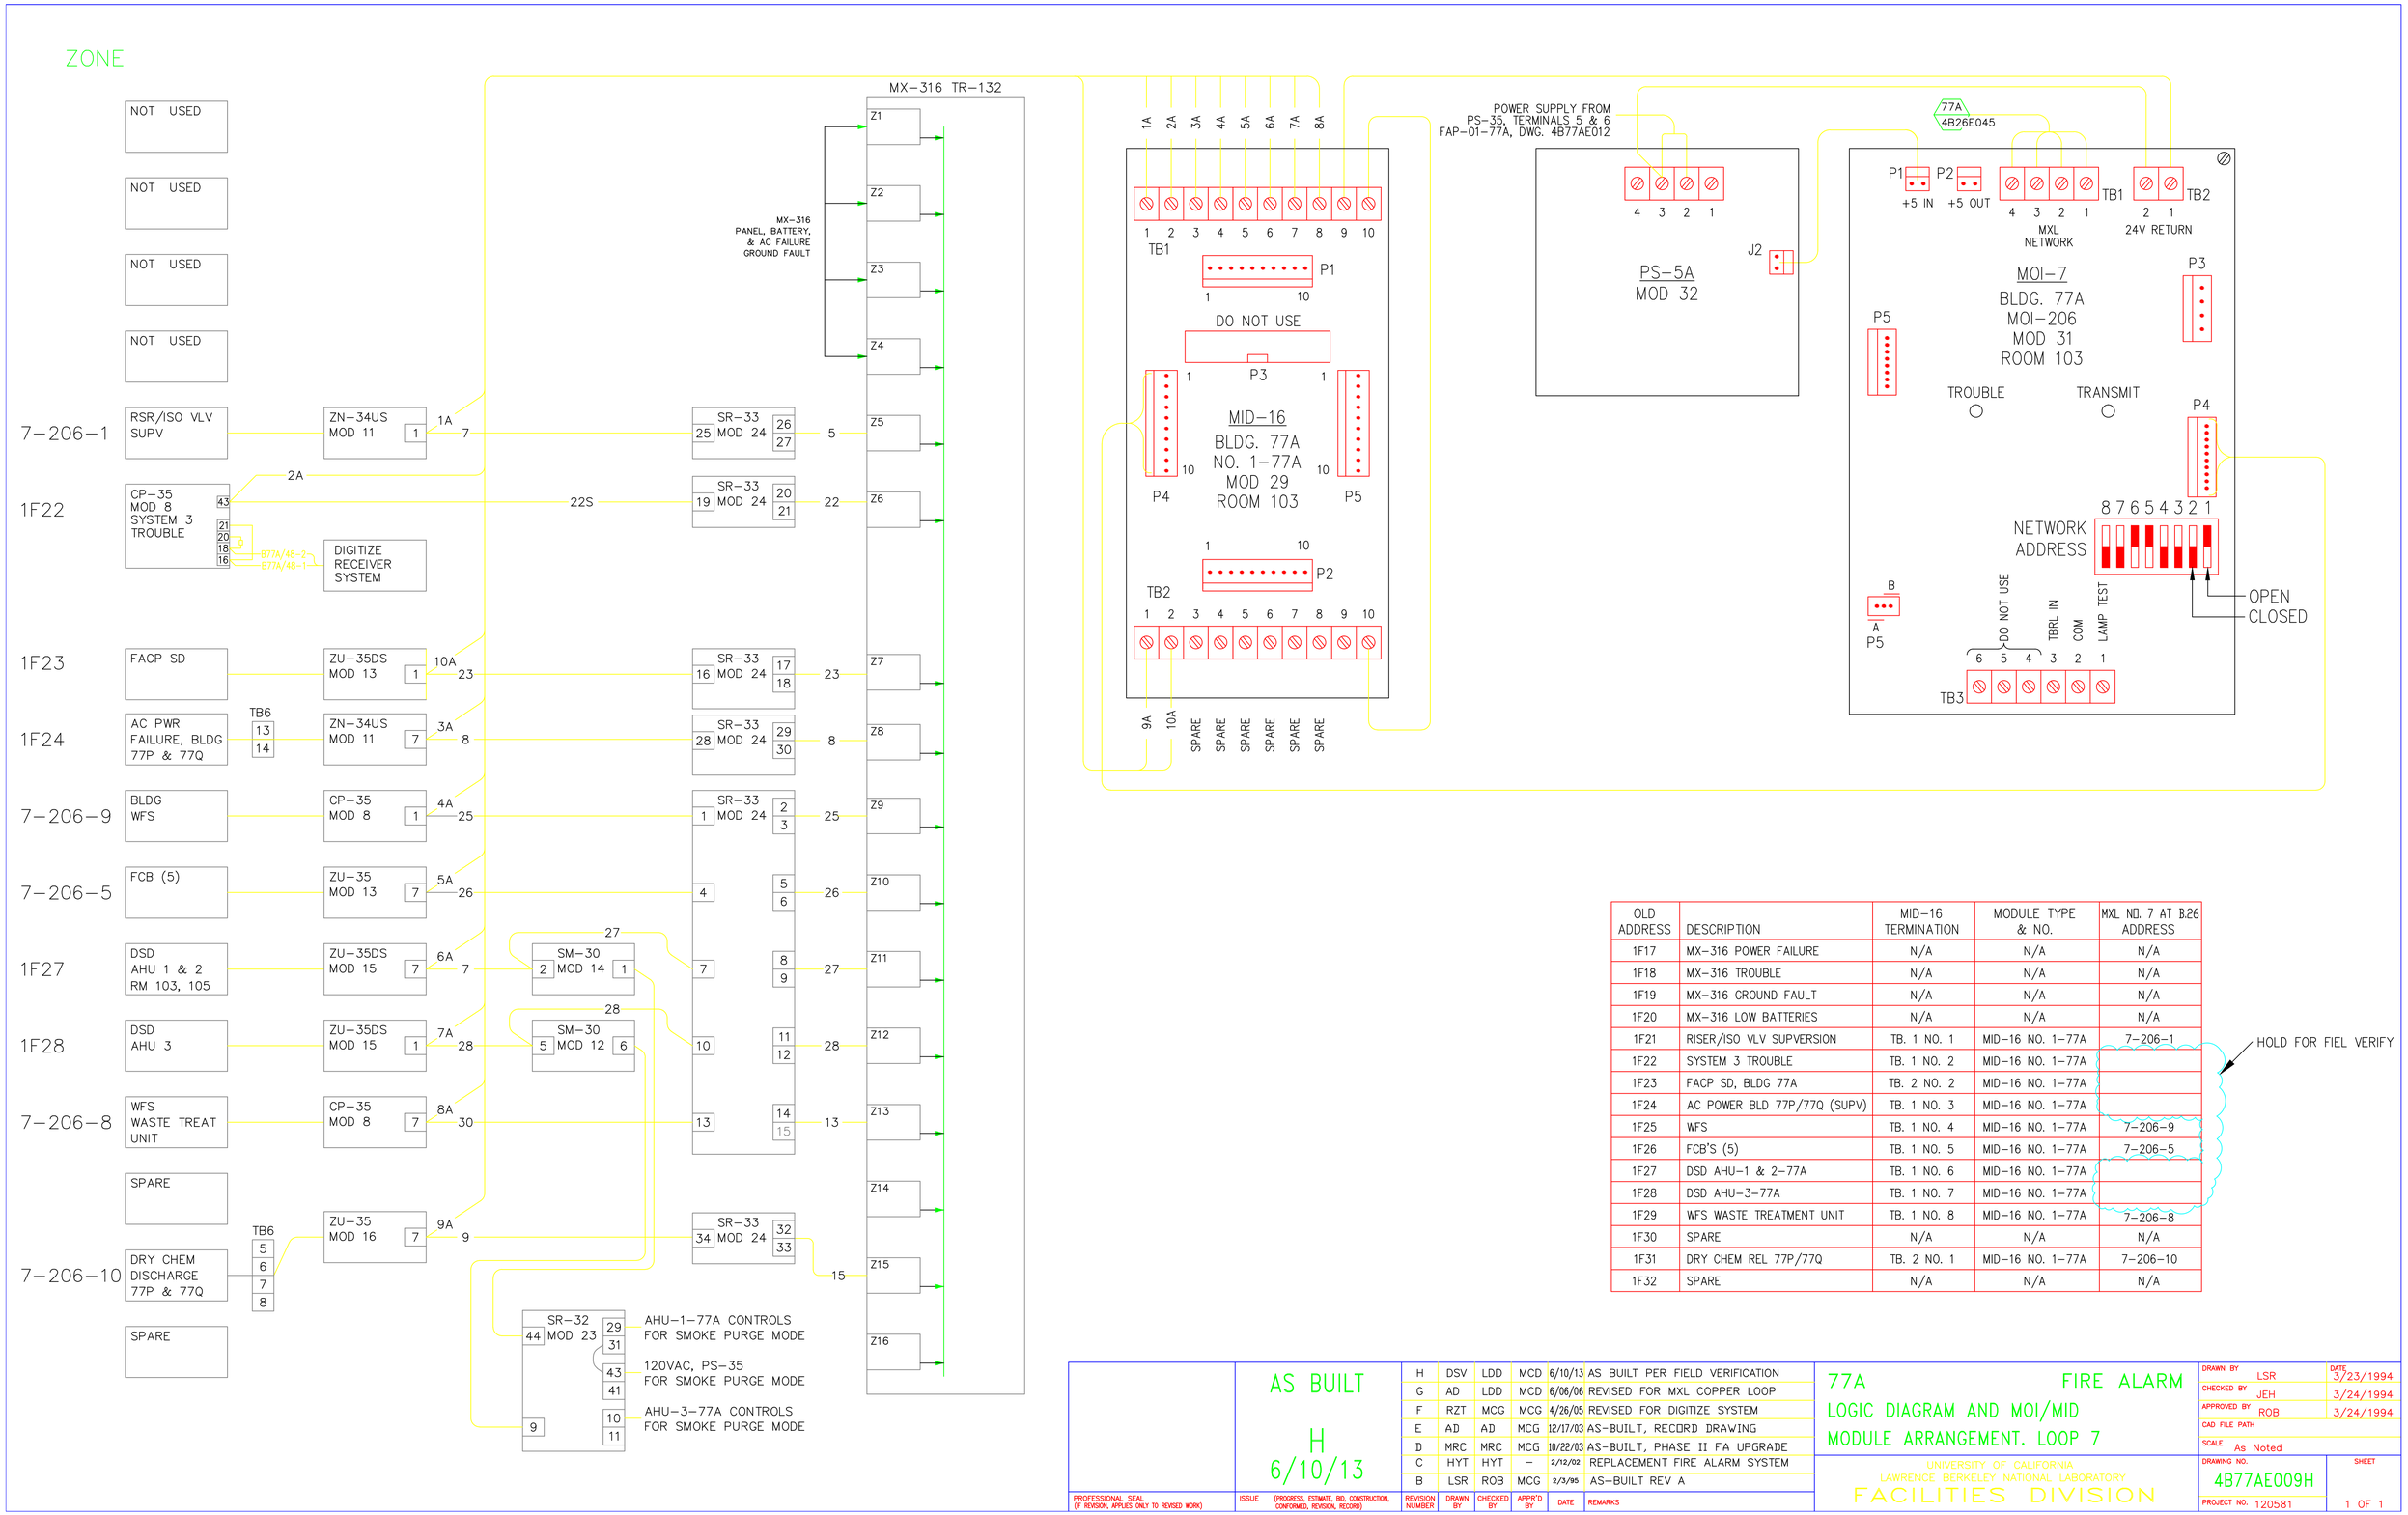

OLD ADDRESS	DESCRIPTION	MID-16 TERMINATION	MODULE TYPE & NO.	MXL NO. 7 AT B.26 ADDRESS
1F17	MX-316 POWER FAILURE	N/A	N/A	N/A
1F18	MX-316 TROUBLE	N/A	N/A	N/A
1F19	MX-316 GROUND FAULT	N/A	N/A	N/A
1F20	MX-316 LOW BATTERIES	N/A	N/A	N/A
1F21	RISER/ISO VLV SUPVERSION	TB. 1 NO. 1	MID-16 NO. 1-77A	7-206-1
1F22	SYSTEM 3 TROUBLE	TB. 1 NO. 2	MID-16 NO. 1-77A	
1F23	FACP SD, BLDG 77A	TB. 2 NO. 2	MID-16 NO. 1-77A	
1F24	AC POWER BLD 77P/77Q (SUPV)	TB. 1 NO. 3	MID-16 NO. 1-77A	
1F25	WFS	TB. 1 NO. 4	MID-16 NO. 1-77A	7-206-9
1F26	FCB'S (5)	TB. 1 NO. 5	MID-16 NO. 1-77A	7-206-5
1F27	DSD AHU-1 & 2-77A	TB. 1 NO. 6	MID-16 NO. 1-77A	
1F28	DSD AHU-3-77A	TB. 1 NO. 7	MID-16 NO. 1-77A	
1F29	WFS WASTE TREATMENT UNIT	TB. 1 NO. 8	MID-16 NO. 1-77A	7-206-8
1F30	SPARE	N/A	N/A	N/A
1F31	DRY CHEM REL 77P/77Q	TB. 2 NO. 1	MID-16 NO. 1-77A	7-206-10
1F32	SPARE	N/A	N/A	N/A

HOLD FOR FIEL VERIFY

AS BUILT

H
6/10/13

REVISION NUMBER	DRAWN BY	CHECKED BY	APPR'D BY	DATE	REMARKS
H	DSV	LDD	MCD	6/10/13	AS BUILT PER FIELD VERIFICATION
G	AD	LDD	MCD	6/06/06	REVISED FOR MXL COPPER LOOP
F	RZT	MCG	MCG	4/26/05	REVISED FOR DIGITIZE SYSTEM
E	AD	AD	MCG	12/17/03	AS-BUILT, RECORD DRAWING
D	MRC	MRC	MCG	10/22/03	AS-BUILT, PHASE II FA UPGRADE
C	HYT	HYT	–	2/12/02	REPLACEMENT FIRE ALARM SYSTEM
B	LSR	ROB	MCG	2/3/95	AS-BUILT REV A

PROFESSIONAL SEAL (IF REVISION, APPLIES ONLY TO REVISED WORK)

ISSUE (PROGRESS, ESTIMATE, BID, CONSTRUCTION, CONFORMED, REVISION, RECORD)

77A FIRE ALARM
LOGIC DIAGRAM AND MOI/MID
MODULE ARRANGEMENT. LOOP 7

UNIVERSITY OF CALIFORNIA
LAWRENCE BERKELEY NATIONAL LABORATORY
FACILITIES DIVISION

DRAWN BY	LSR	DATE 3/23/1994
CHECKED BY	JEH	3/24/1994
APPROVED BY	ROB	3/24/1994
CAD FILE PATH		
SCALE	As Noted	
DRAWING NO.	4B77AE009H	SHEET 1 OF 1
PROJECT NO.	120581	