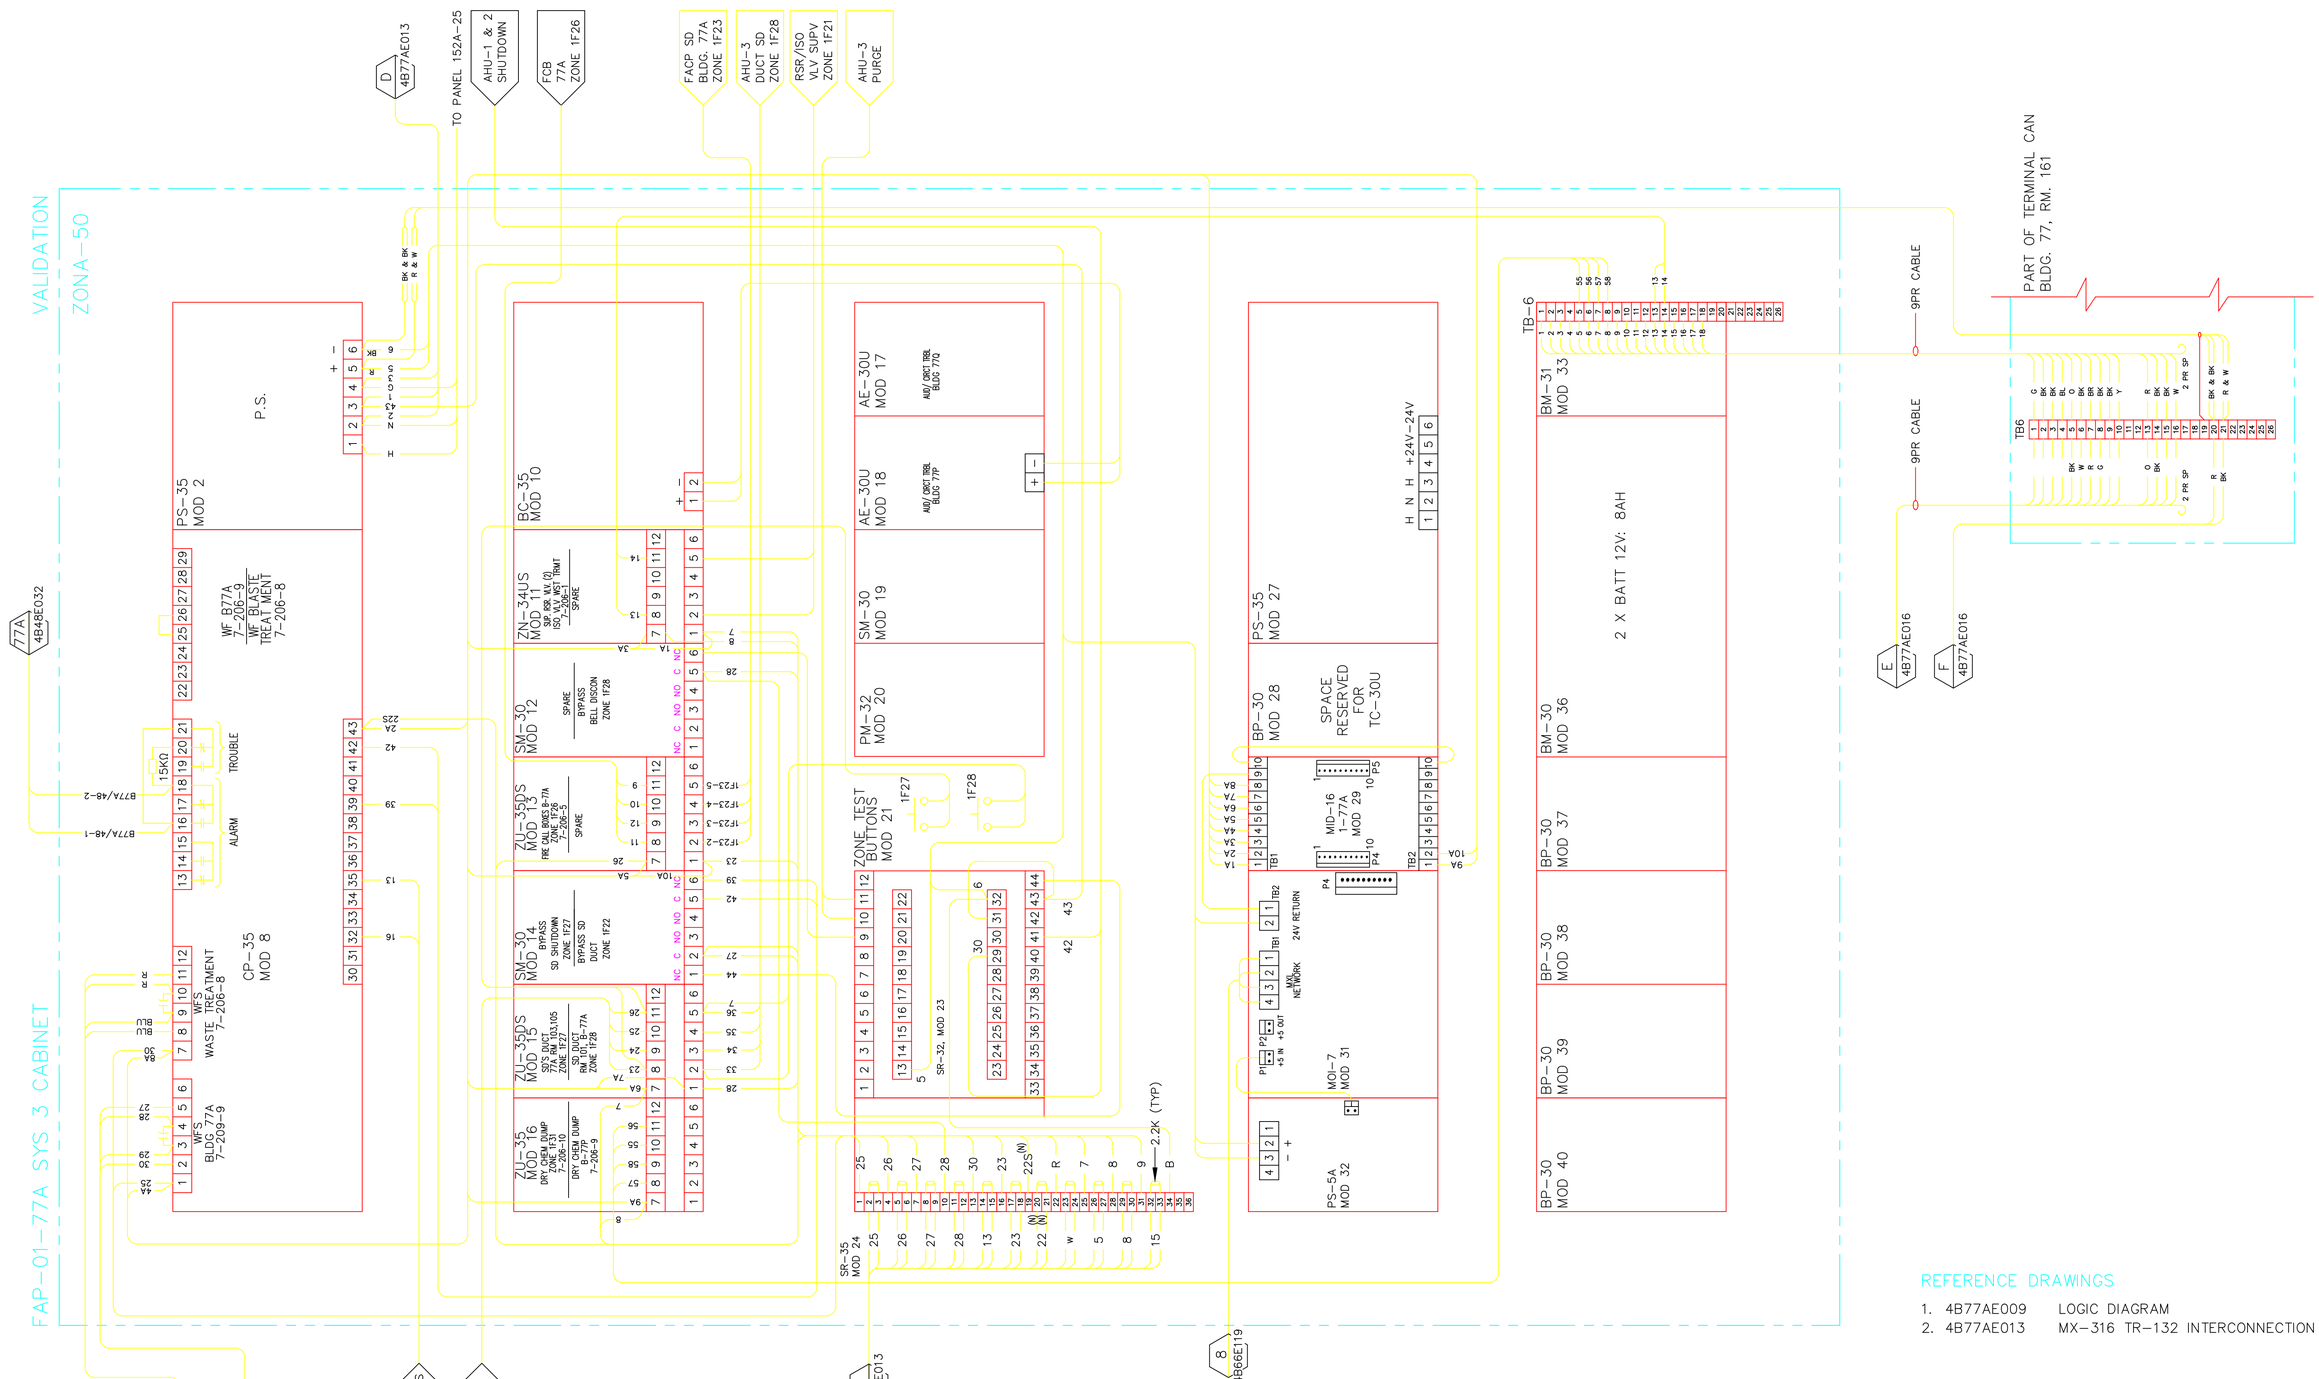

REFERENCE DRAWINGS

1. 4B77AE009 LOGIC DIAGRAM
2. 4B77AE013 MX-316 TR-132 INTERCONNECTION DIAGRAM

AS BUILT

G
6/10/13

PROFESSIONAL SEAL
(IF REVISION, APPLIES ONLY TO REVISED WORK)

ISSUE (PROGRESS, ESTIMATE, BID, CONSTRUCTION, CONFORMED, REVISION, RECORD)

REVISION NUMBER	DRAWN BY	CHECKED BY	APPR'D BY	DATE	REMARKS
G	DSV	LDD	MCD	6/10/13	AS BUILT PER FIELD VERIFICATION
F	RZT	MCG	MCG	4/25/05	REVISED FOR DIGITIZE SYSTEM
E	AD	AD	MCG	12/17/03	AS-BUILT, RECORD DRAWING
D	MRC	AD	MCG	10/21/03	AS BUILT, PHASE II FA UPGRADE
C	HYT	HYT	–	2/12/02	REPLACEMENT FIRE ALARM PROJECT
B	LSR	ROB	MCG	2-3-95	AS BUILT REV A
A	RB	BHS	BHS	2-5-94	MODIFY ZONES FOR 77A WAA'S

77A FIRE ALARM
FAP-00-77A SYS 3
INTERCONNECTION DIAGRAM

UNIVERSITY OF CALIFORNIA
LAWRENCE BERKELEY NATIONAL LABORATORY
FACILITIES DIVISION

DRAWN BY	LSR
DATE	3/23/1994
CHECKED BY	JEH 3/24/1994
APPROVED BY	ROB 3/24/1994
CAD FILE PATH	
SCALE	As Noted
DRAWING NO.	4B77AE012G
SHEET	1 OF 1
PROJECT NO.	120581